


SURVEY No. 1054

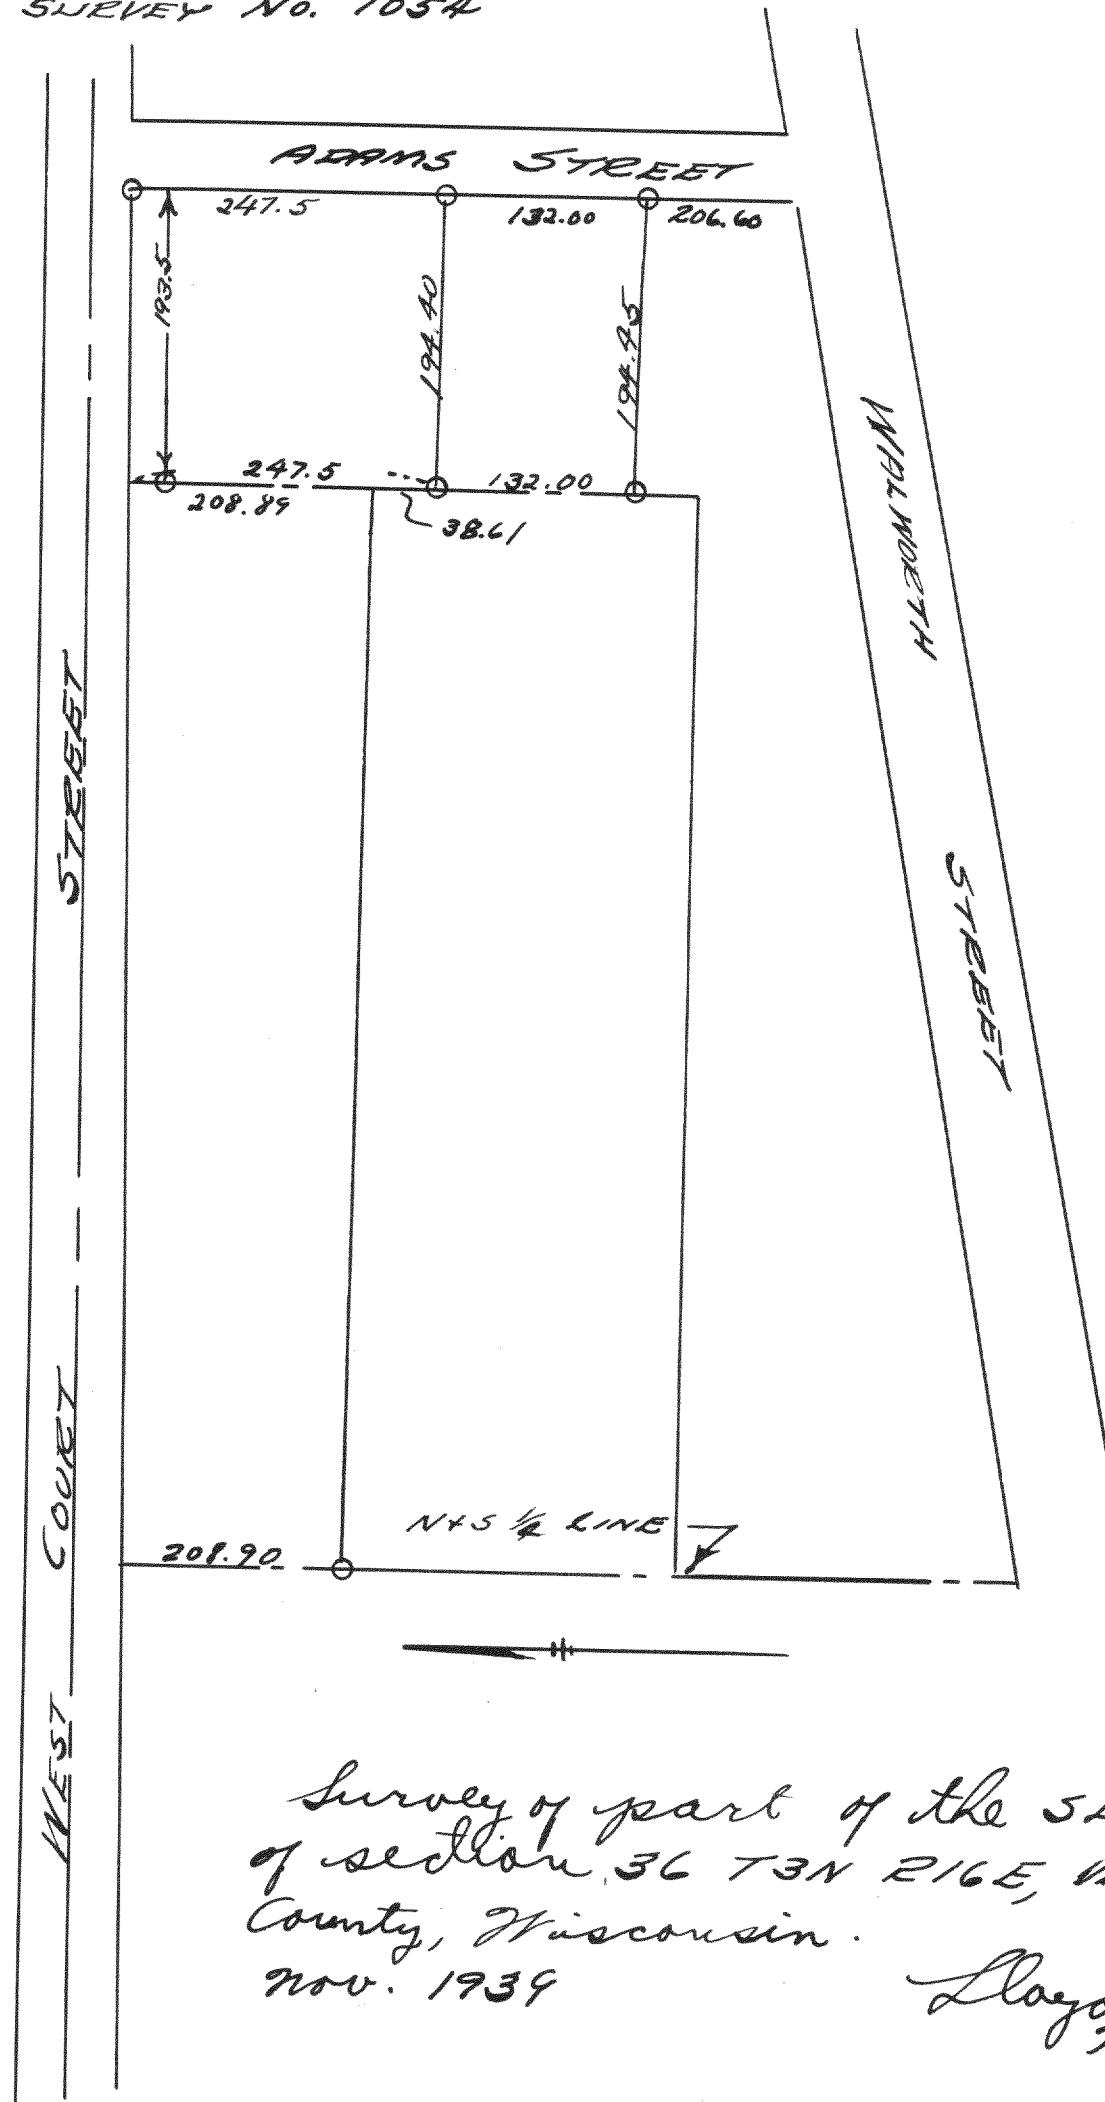

SURVEY No. 1055

