



SURVEY No. 1067

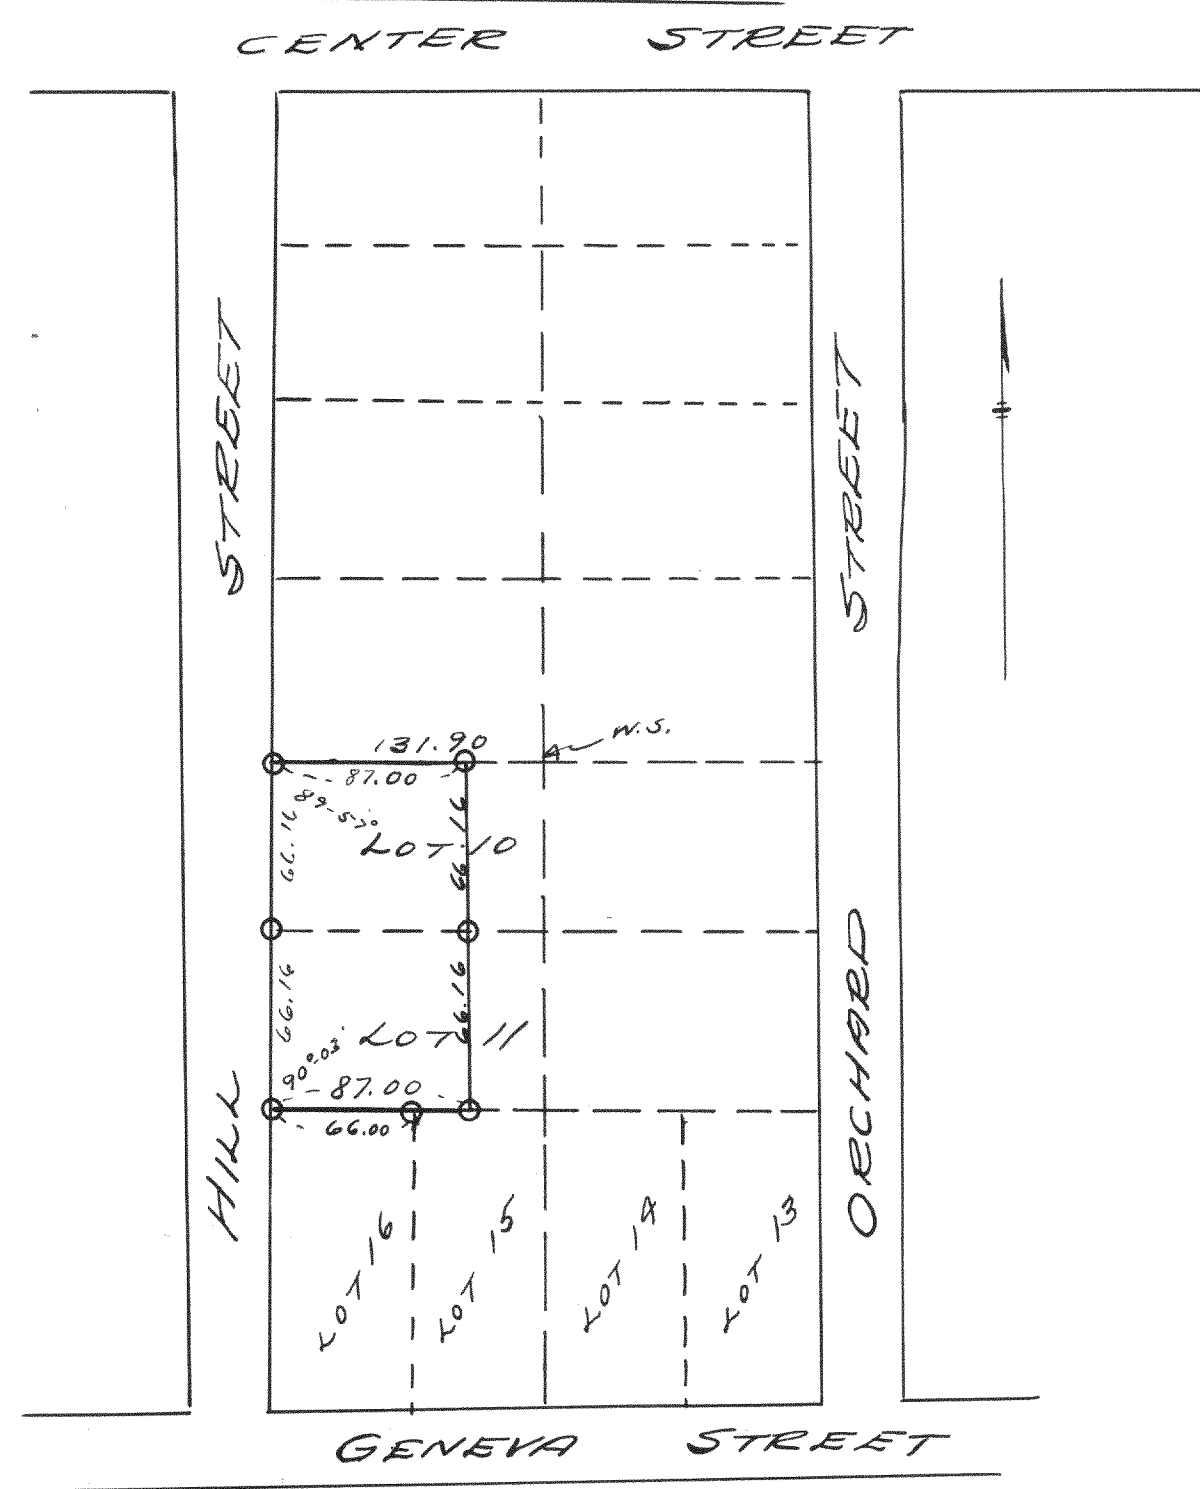


SURVEY OF LOTS 10 & 11 OF BLOCK
16 OF WILLIAMS 2ND ADD. TO THE
VILLAGE OF WIMS. BAY
9-19-39
Lloyd L. Jensen
by K.E.J.

SURVEY No. 1068

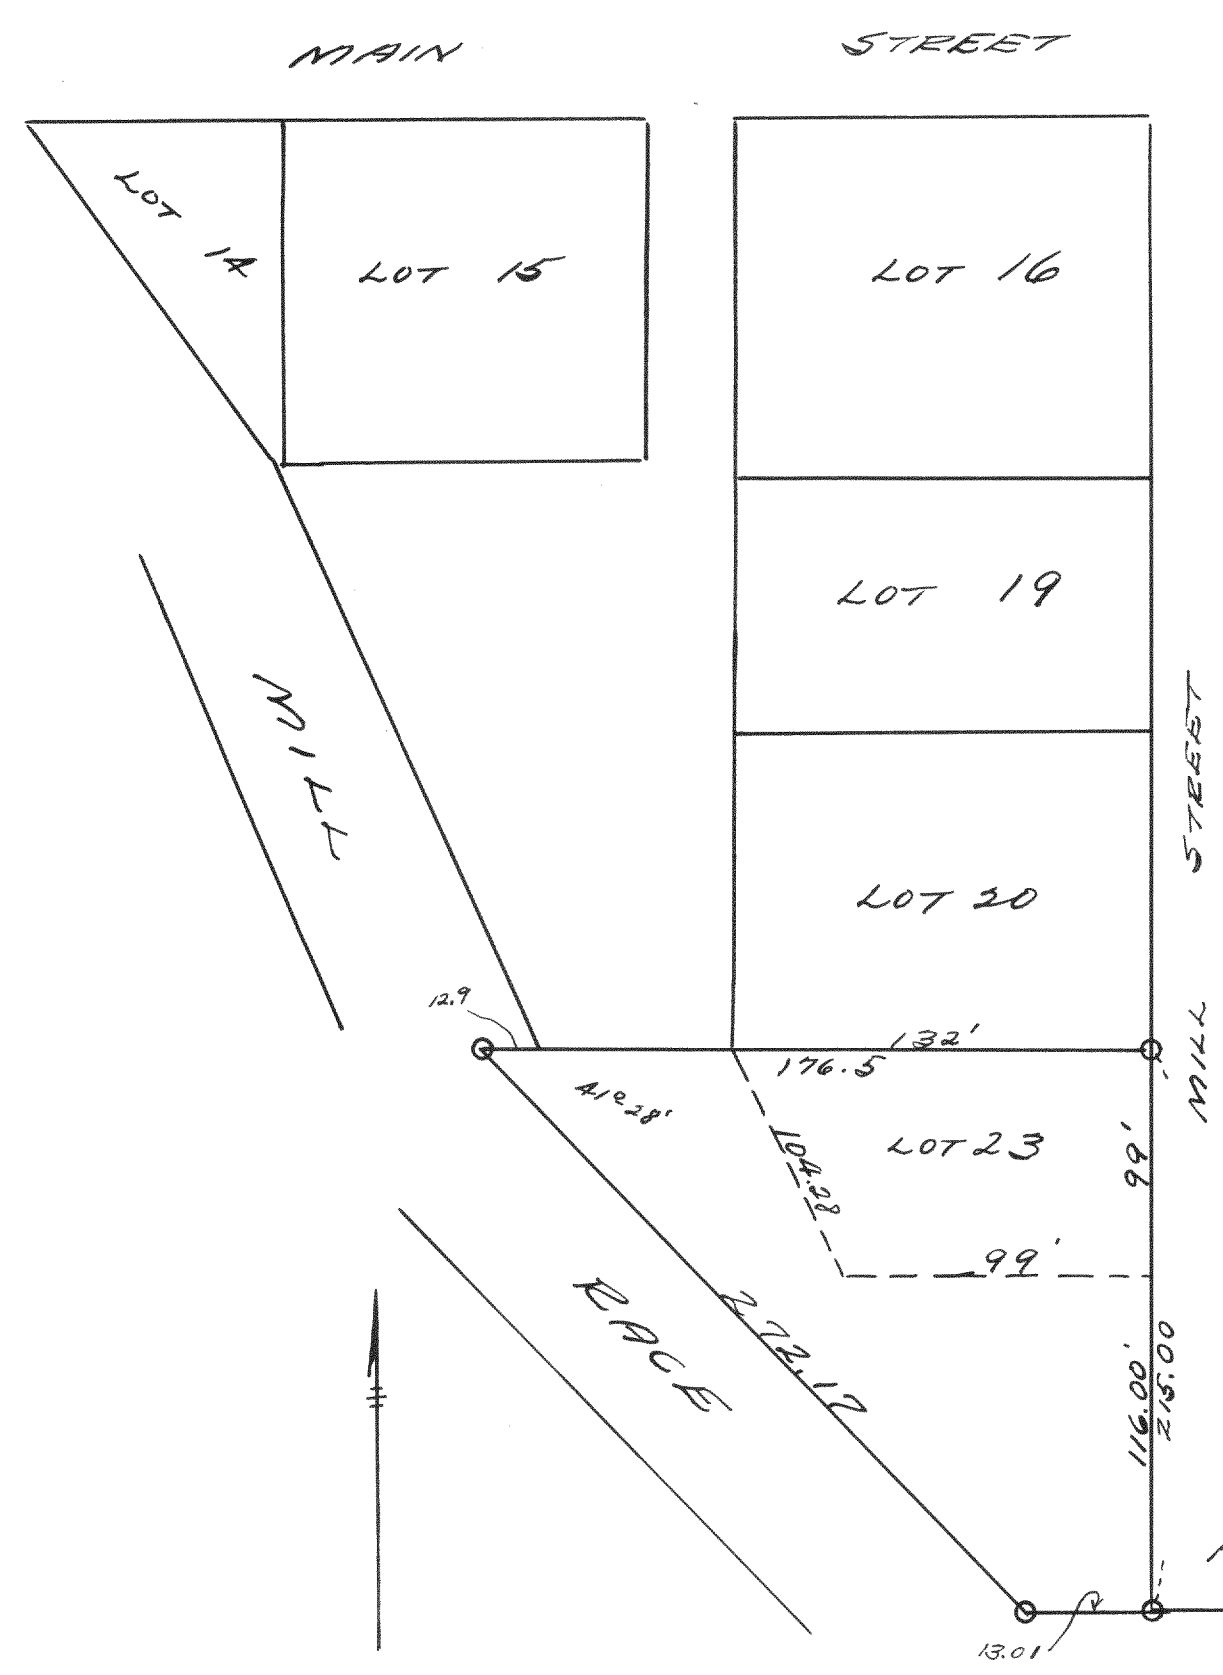

SURVEY OF LOT 23 OF THE ORIGINAL
VILLAGE OF GENOA CITY AND ADJOINING
PROPERTY.
APRIL 5, 1939
Lloyd L. Jensen
by K.E.J.

SURVEY No. 1069

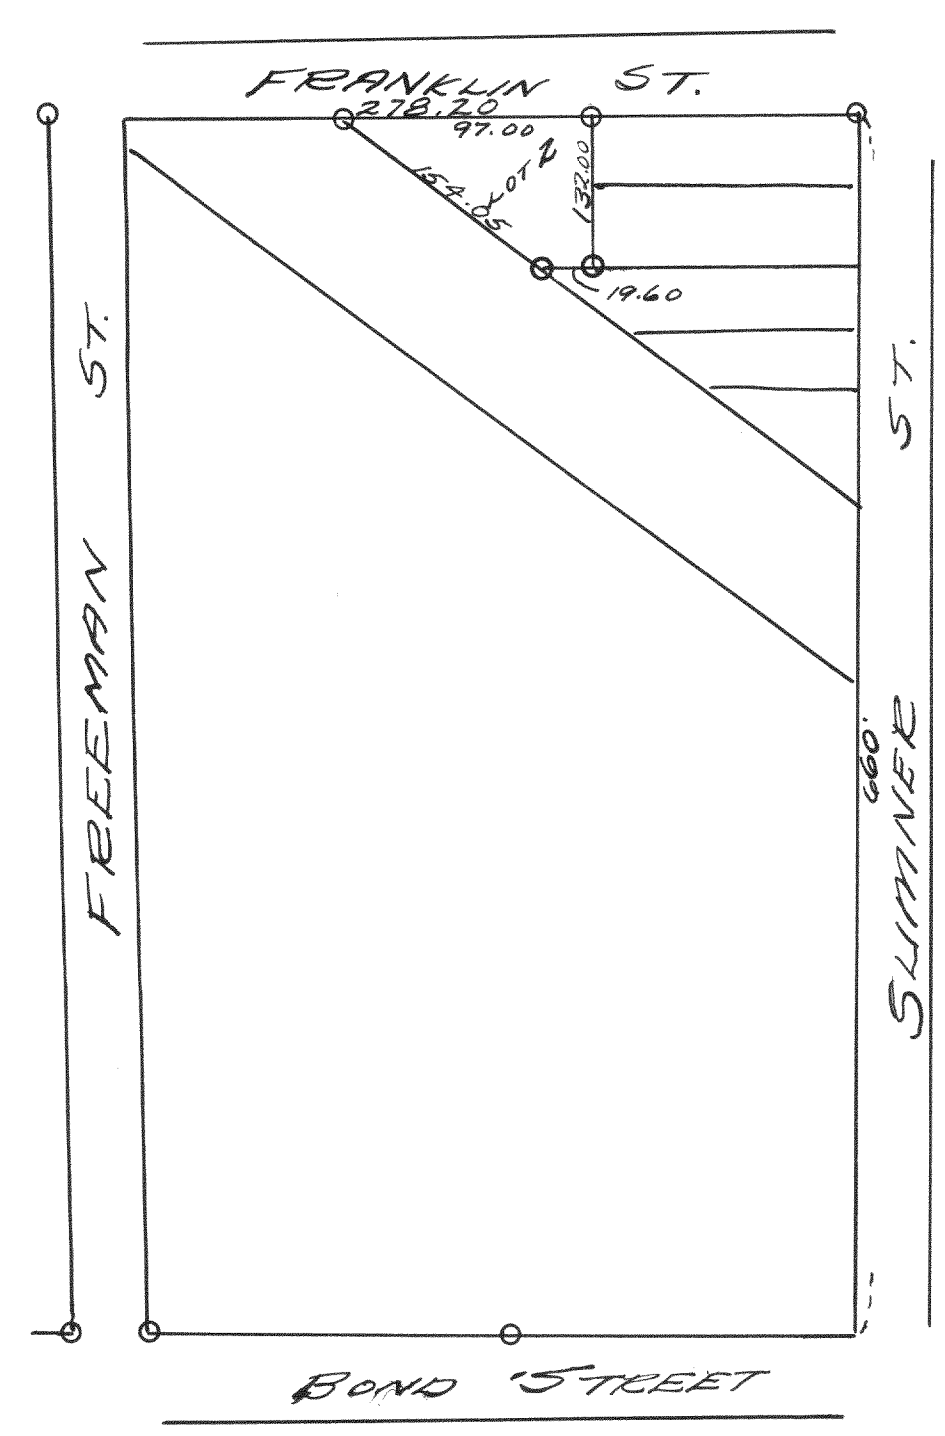

SURVEY OF LOT 2, BLK. 4
OF ROWE'S ADD. TO
THE VILLAGE OF GENOA
CITY.
10-39
Lloyd L. Jensen
by K.E.J.