


SURVEY No. 1083

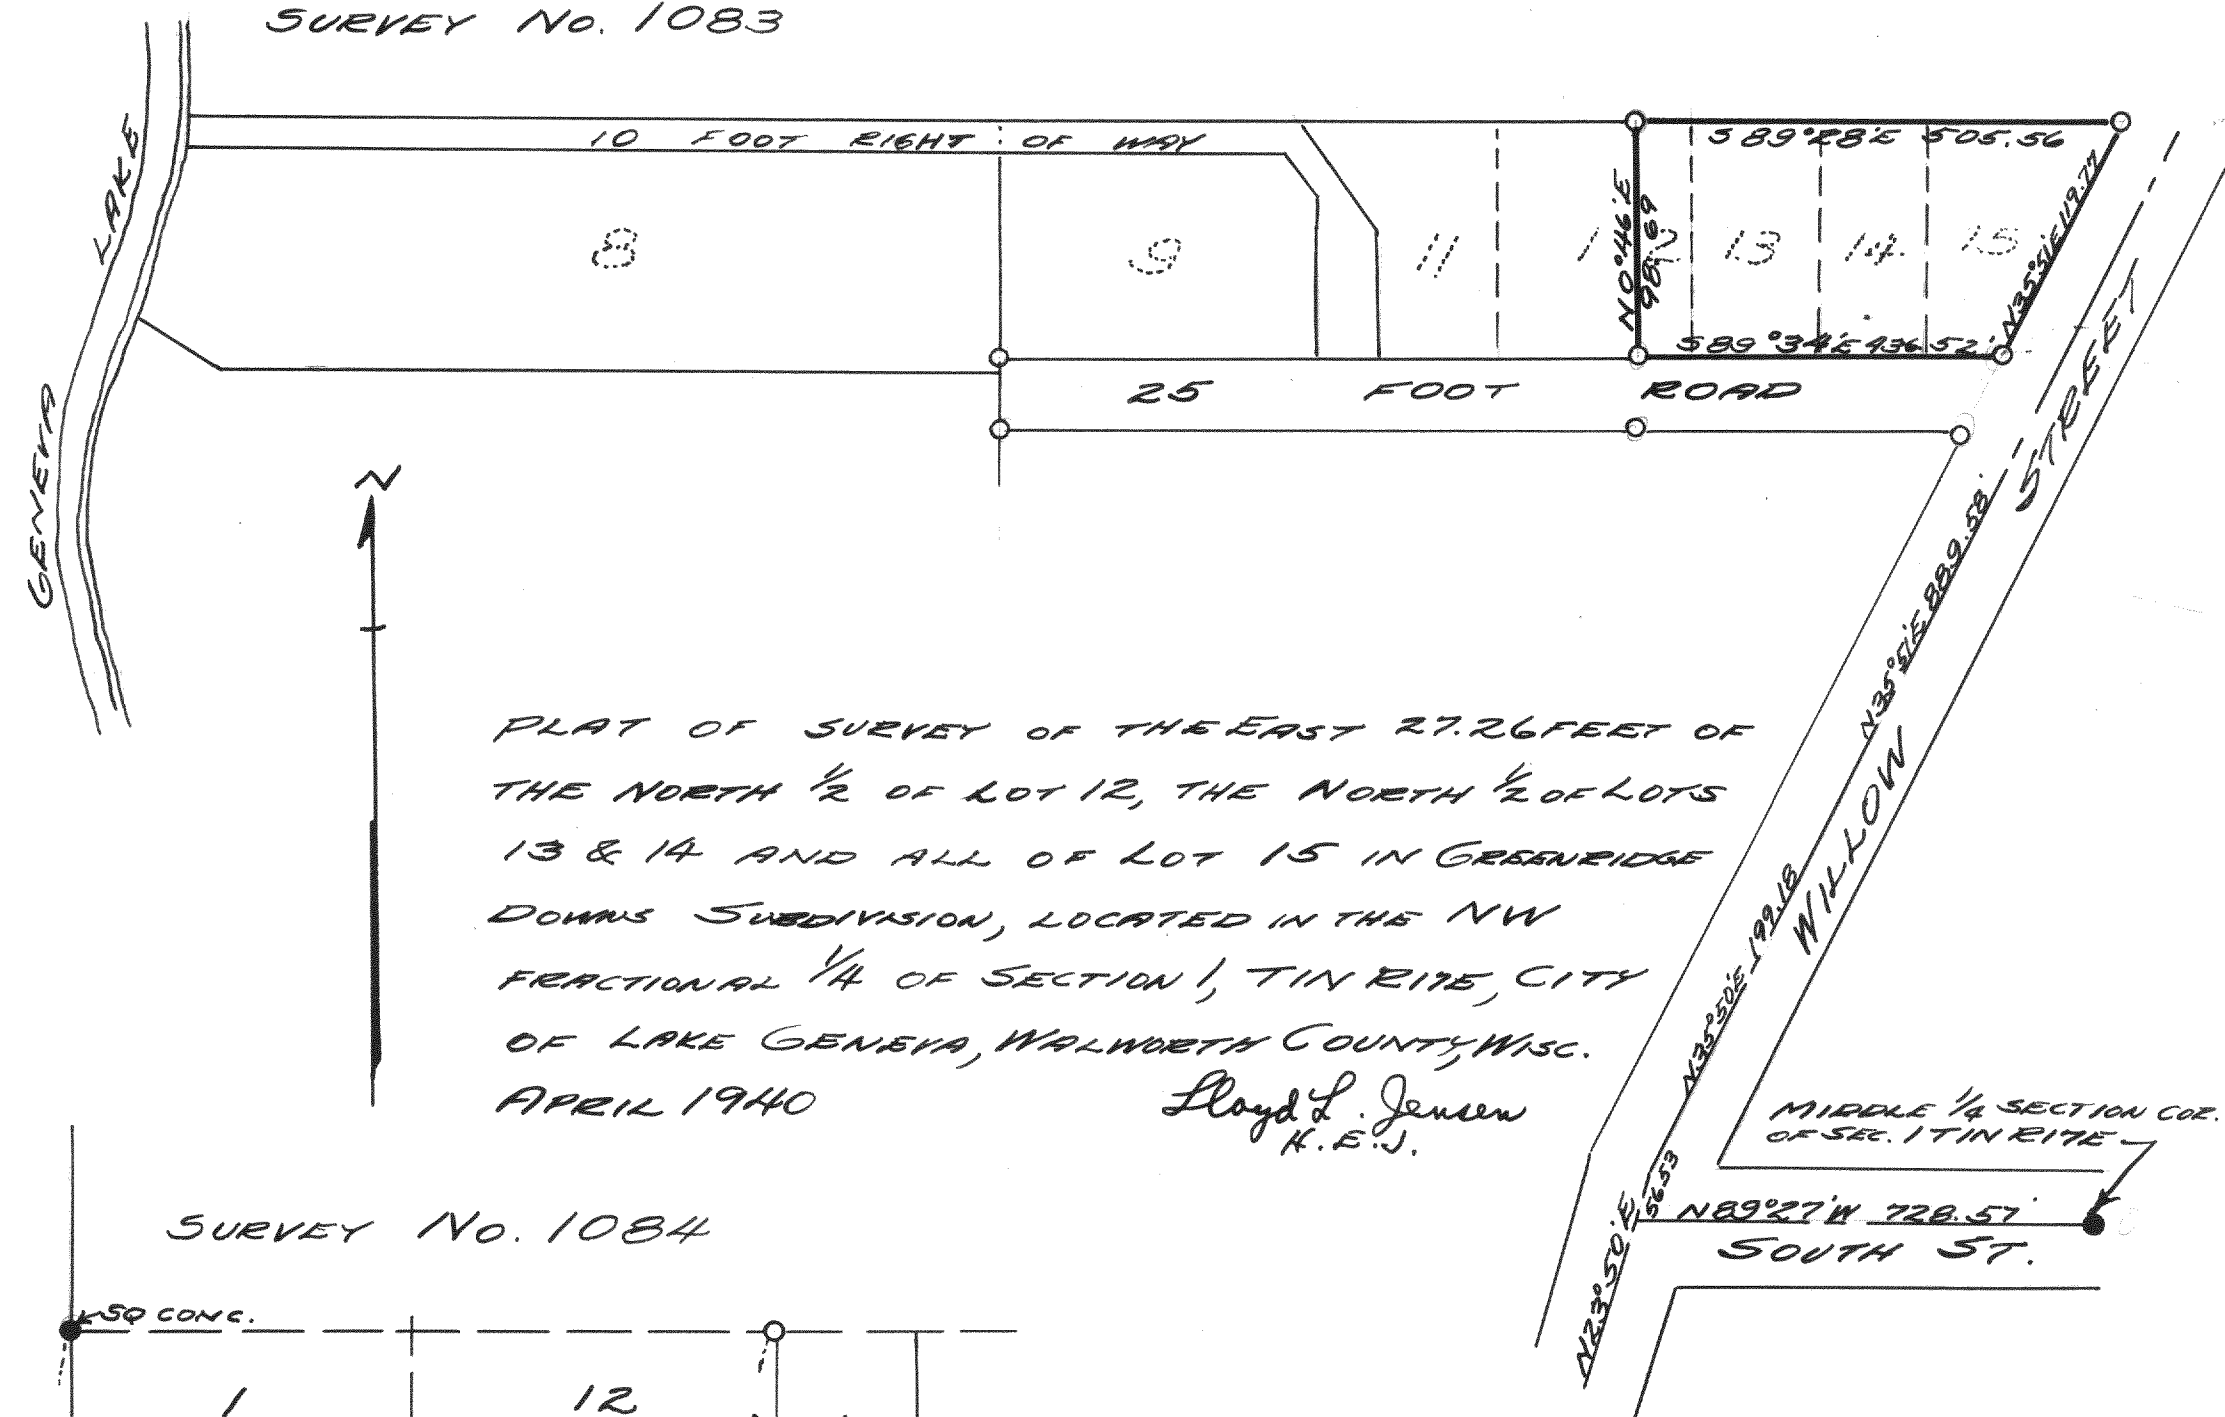

SURVEY No. 1084



SURVEY No. 1085

