



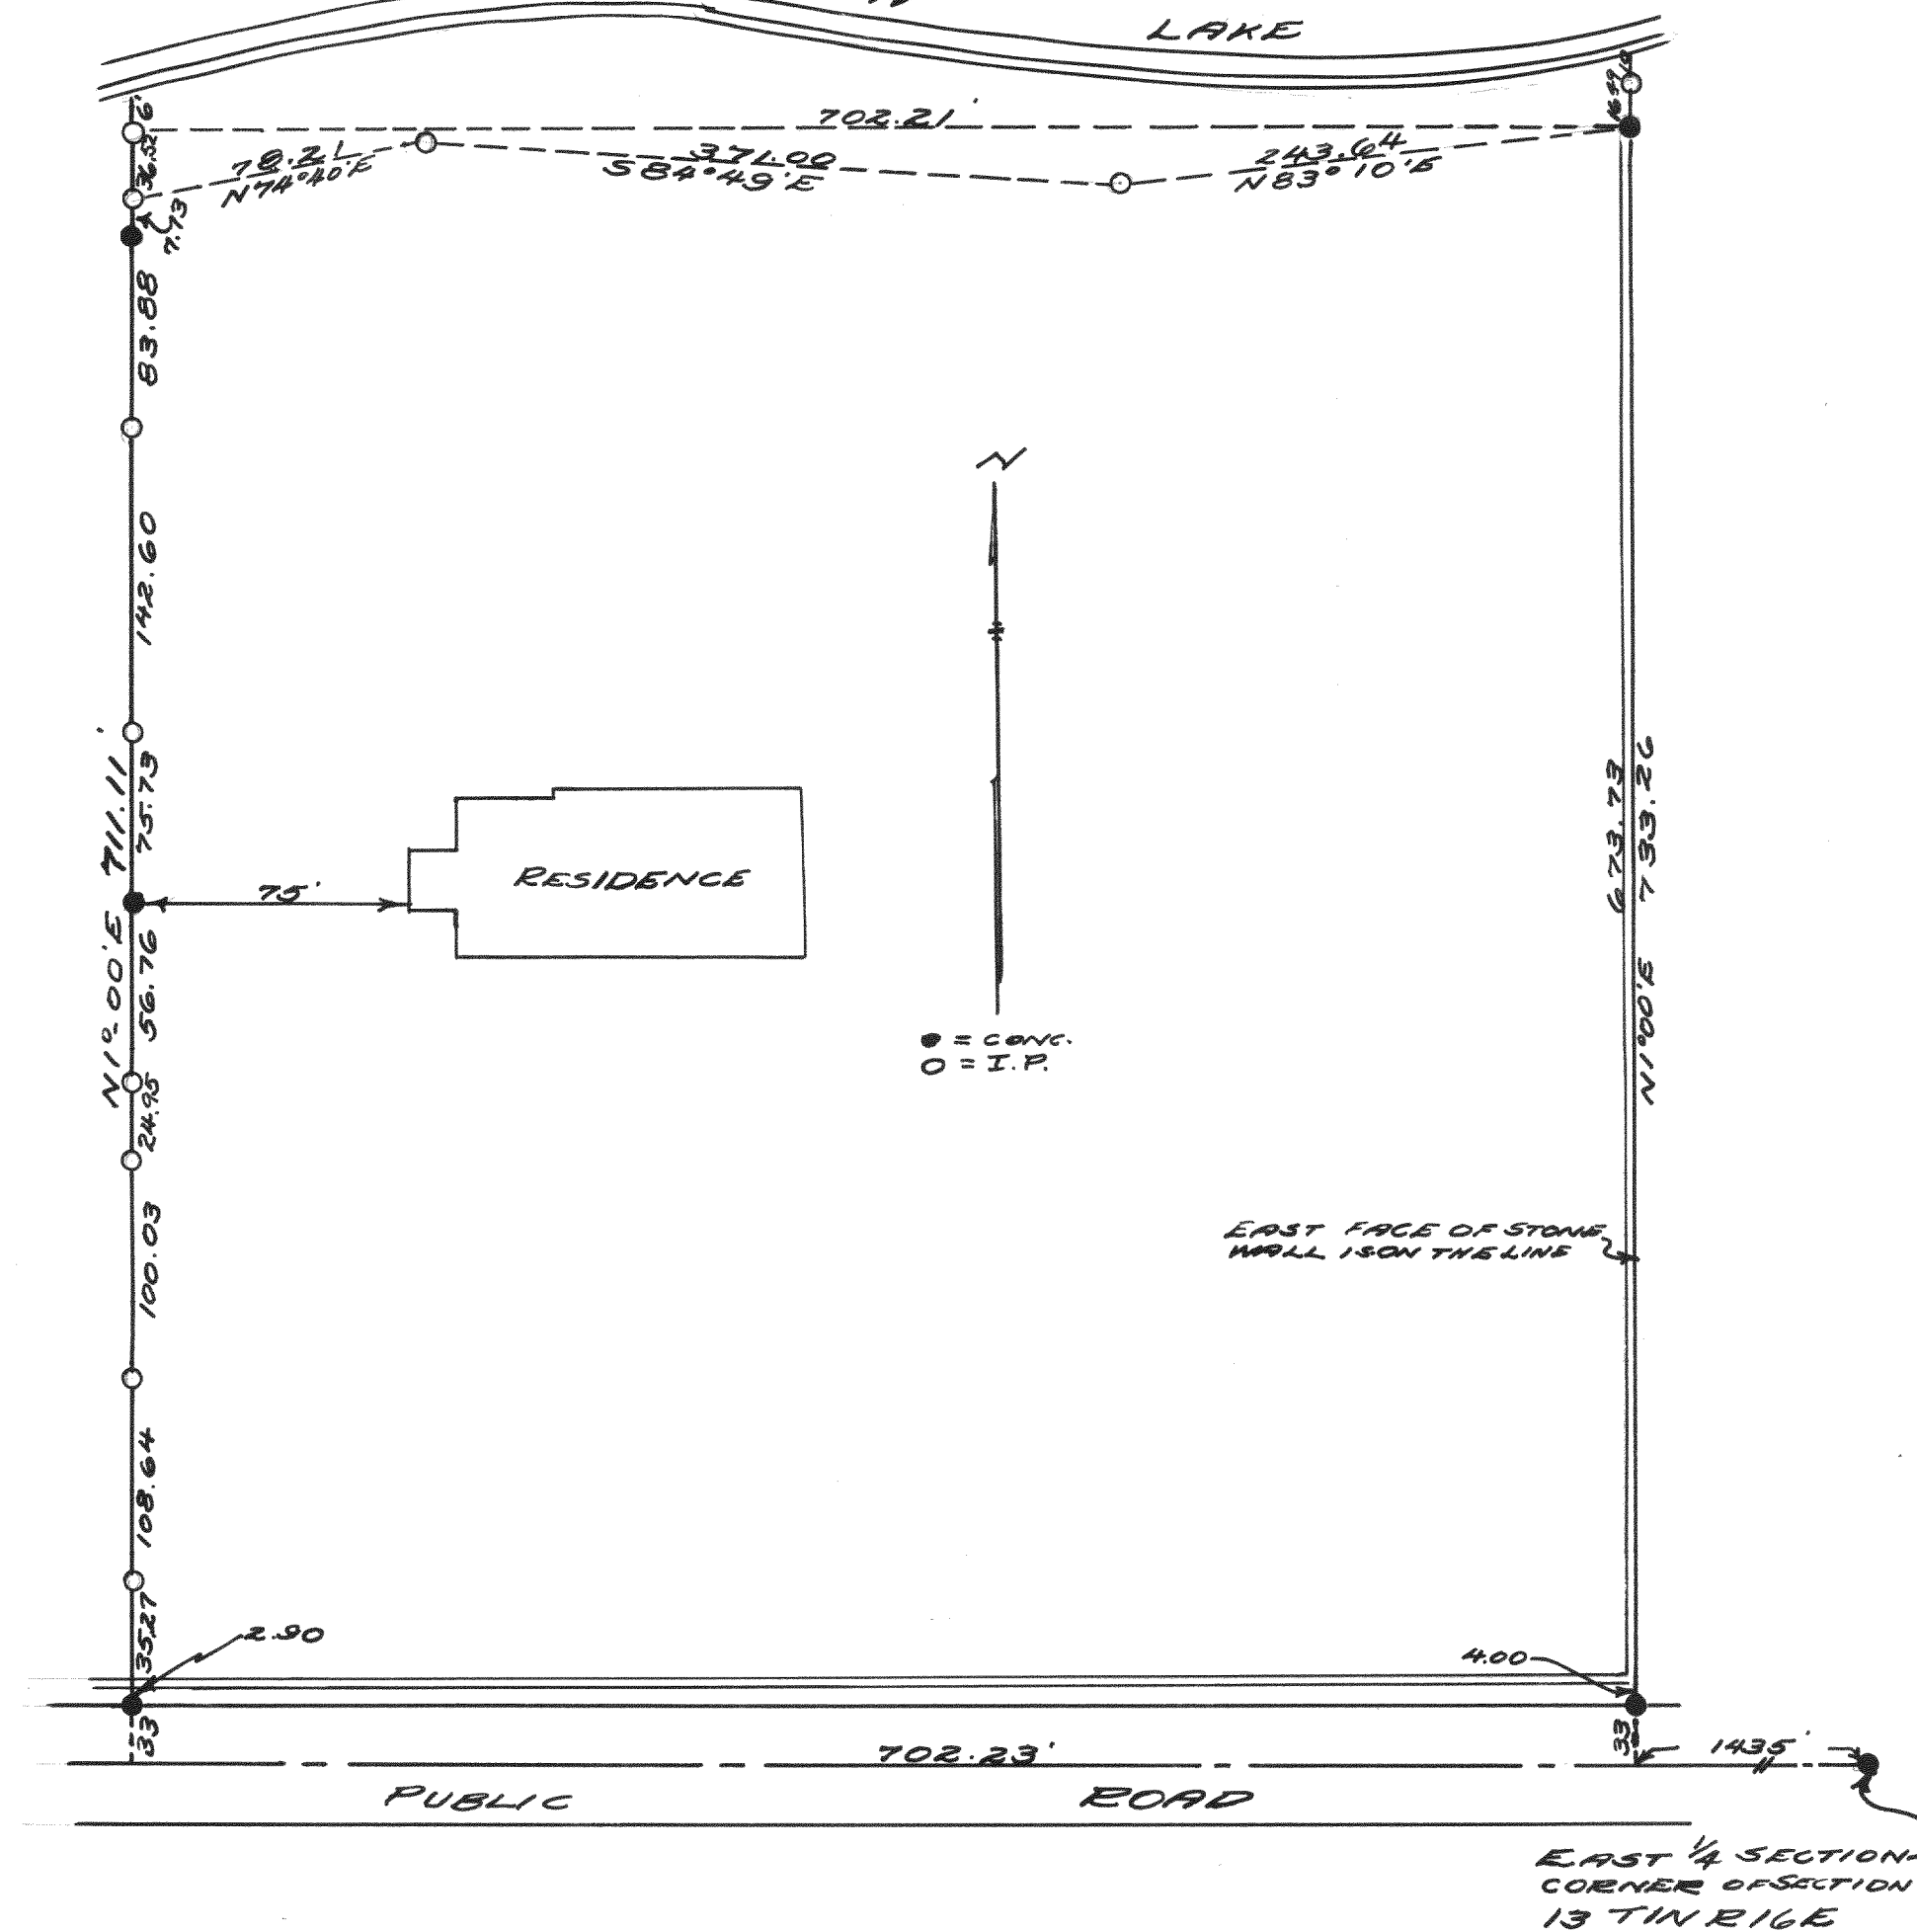

PLAT OF SURVEY OF LAND LOCATED IN THE NORTH $\frac{1}{2}$
OF FRACTIONAL SECTION 13 T1N R16E, WAL. CO. WISC.
OCT. 1940

Lloyd L. Jensen
S.E.S.

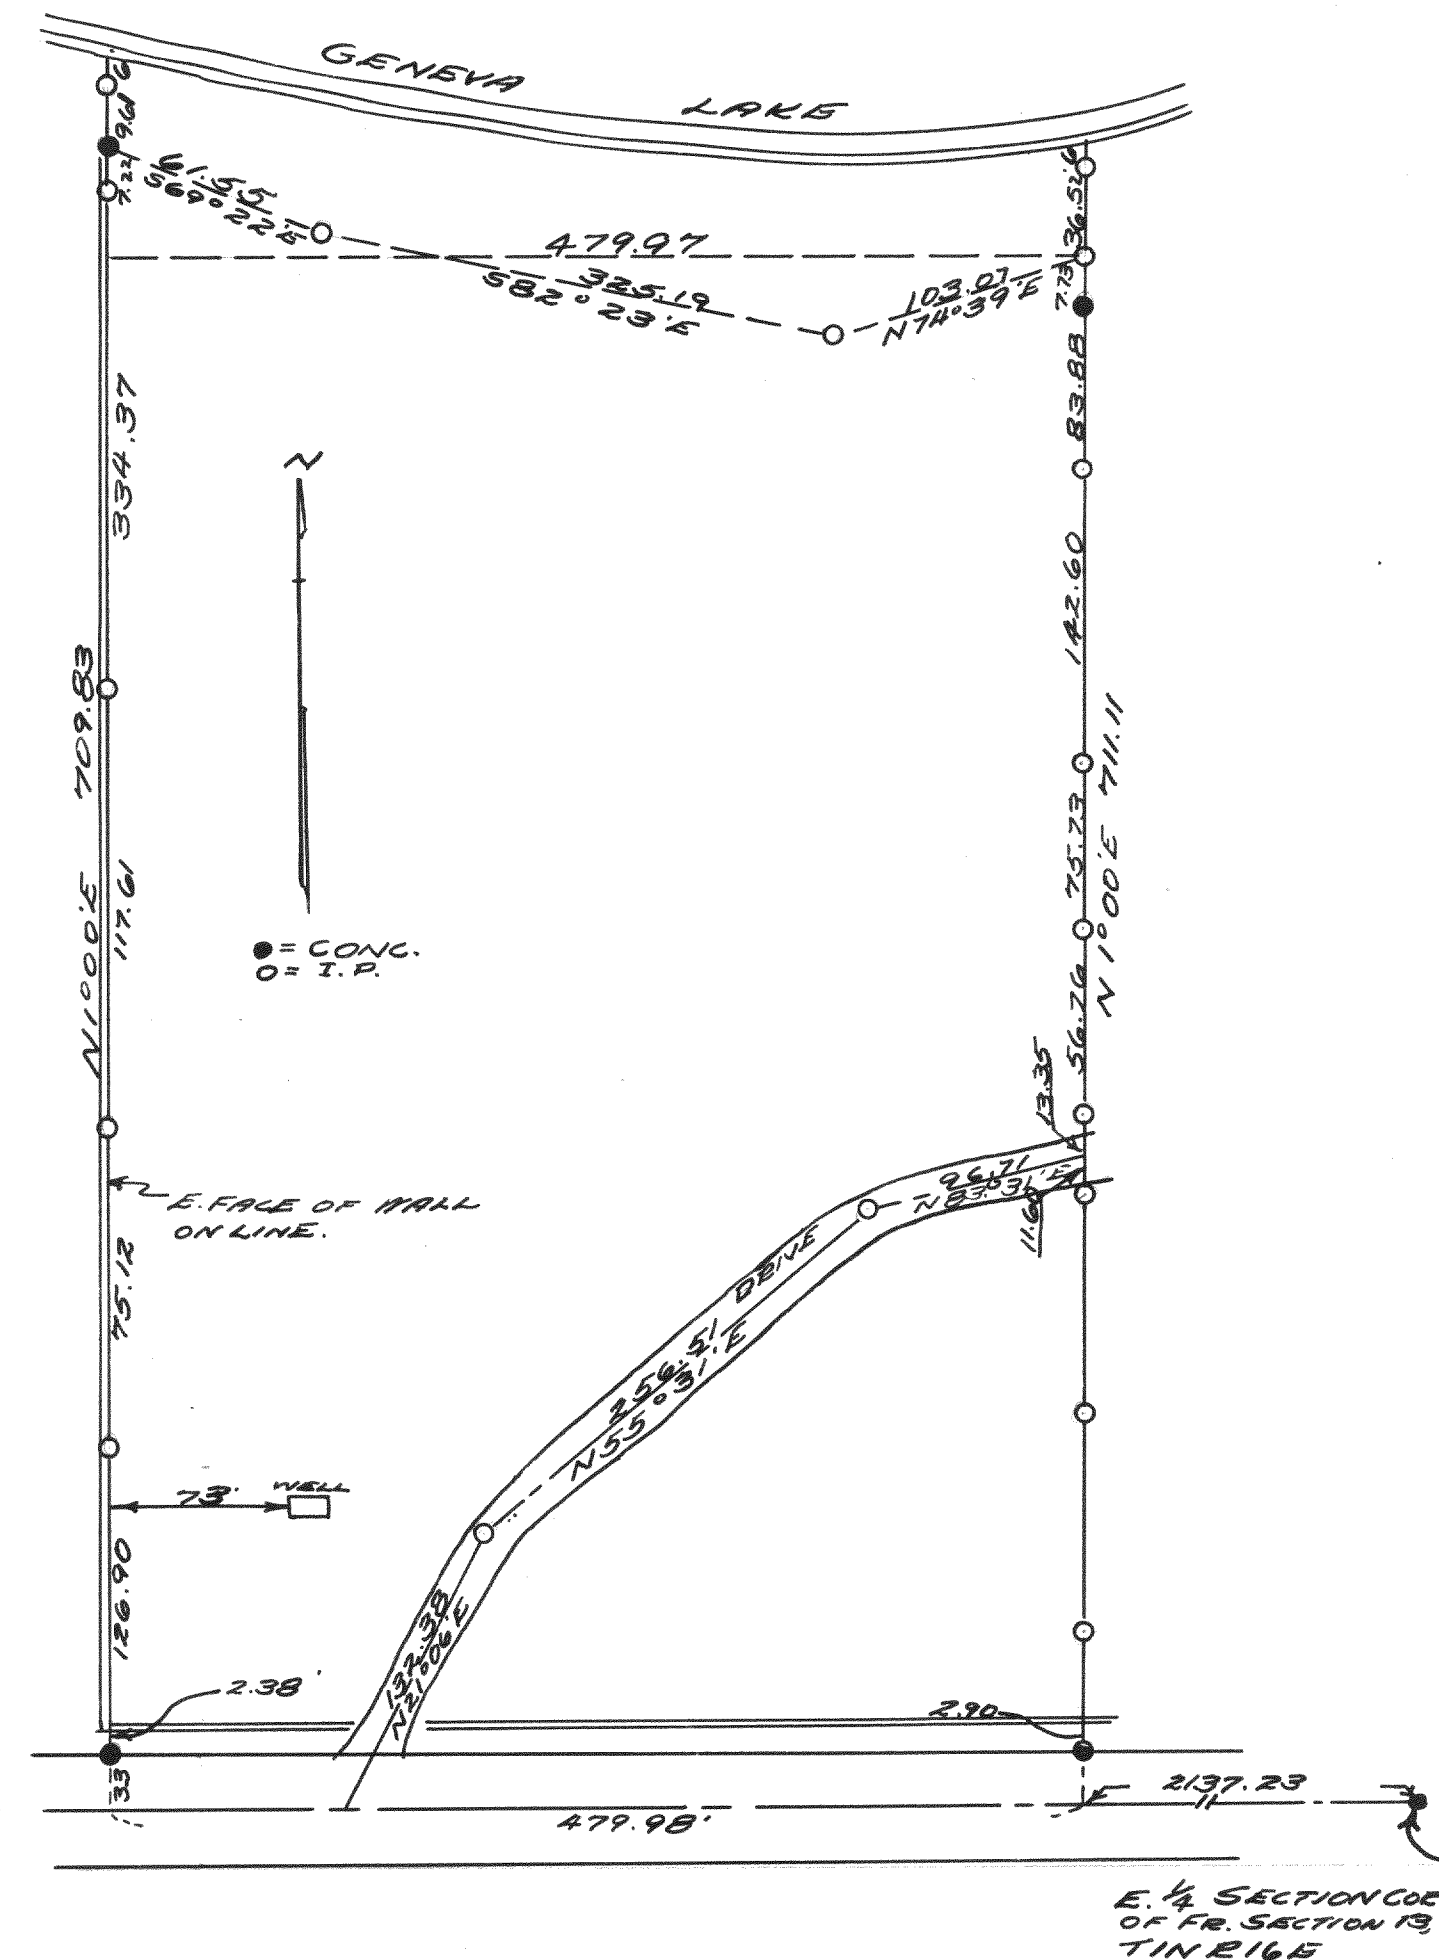

PLAT OF SURVEY OF LAND LOCATED IN THE NORTH $\frac{1}{2}$
OF FRACTIONAL SECTION 13 T1N R16E, WALWORTH CO.
WISCONSIN
OCT., 1940

Lloyd L. Jensen
S.E.S.