


374

SURVEY NO. 1049

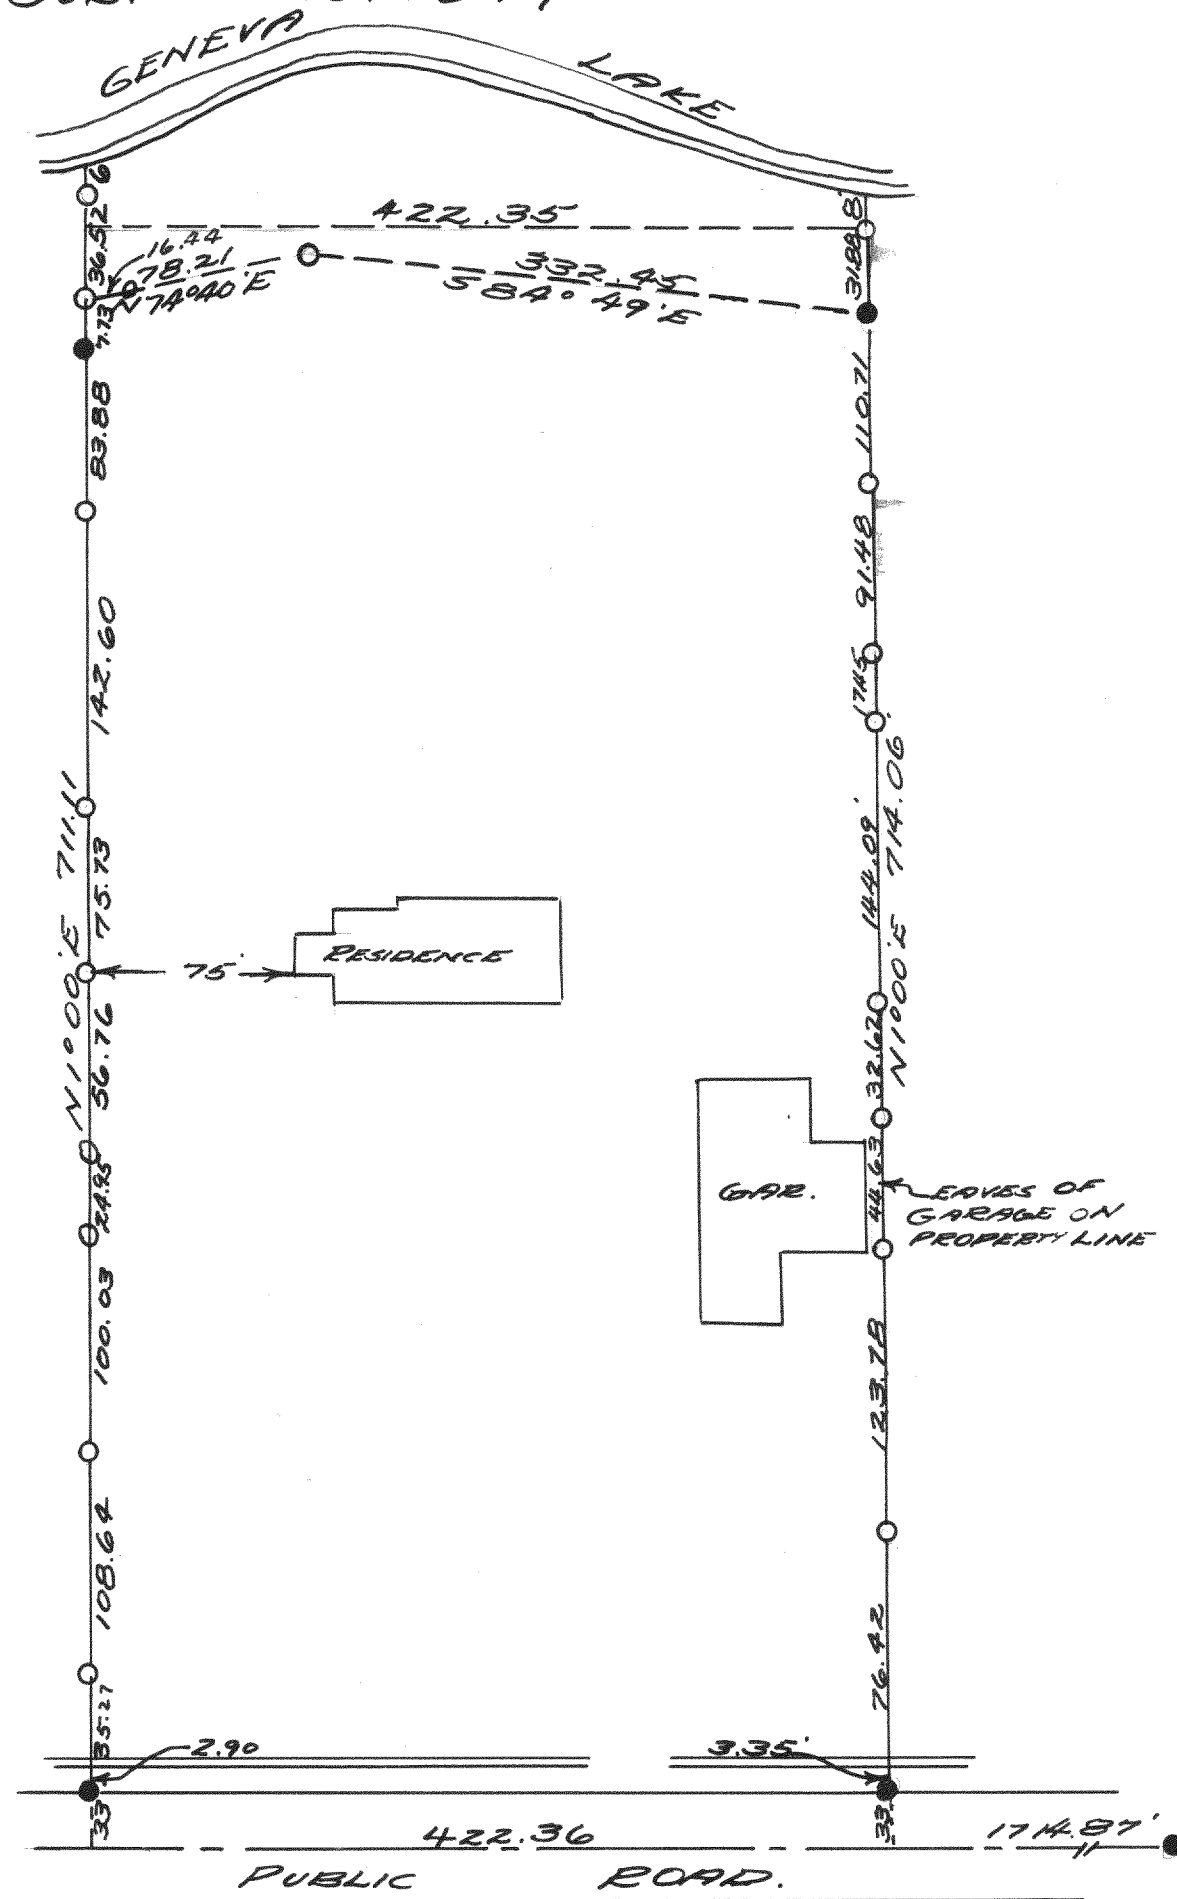


EAST 1/4 SECTION CORNER
OF FR. SECTION 13
T1N R16E, WAL. CO. WISC.

PLAT OF SURVEY OF LAND LOCATED IN THE
NORTH 1/2 OF FR. SECTION 13 T1N R16E, WALWORTH
COUNTY, WISCONSIN
OCT. 1940

Lloyd L. Jensen
S.E.J.

SURVEY NO. 1100

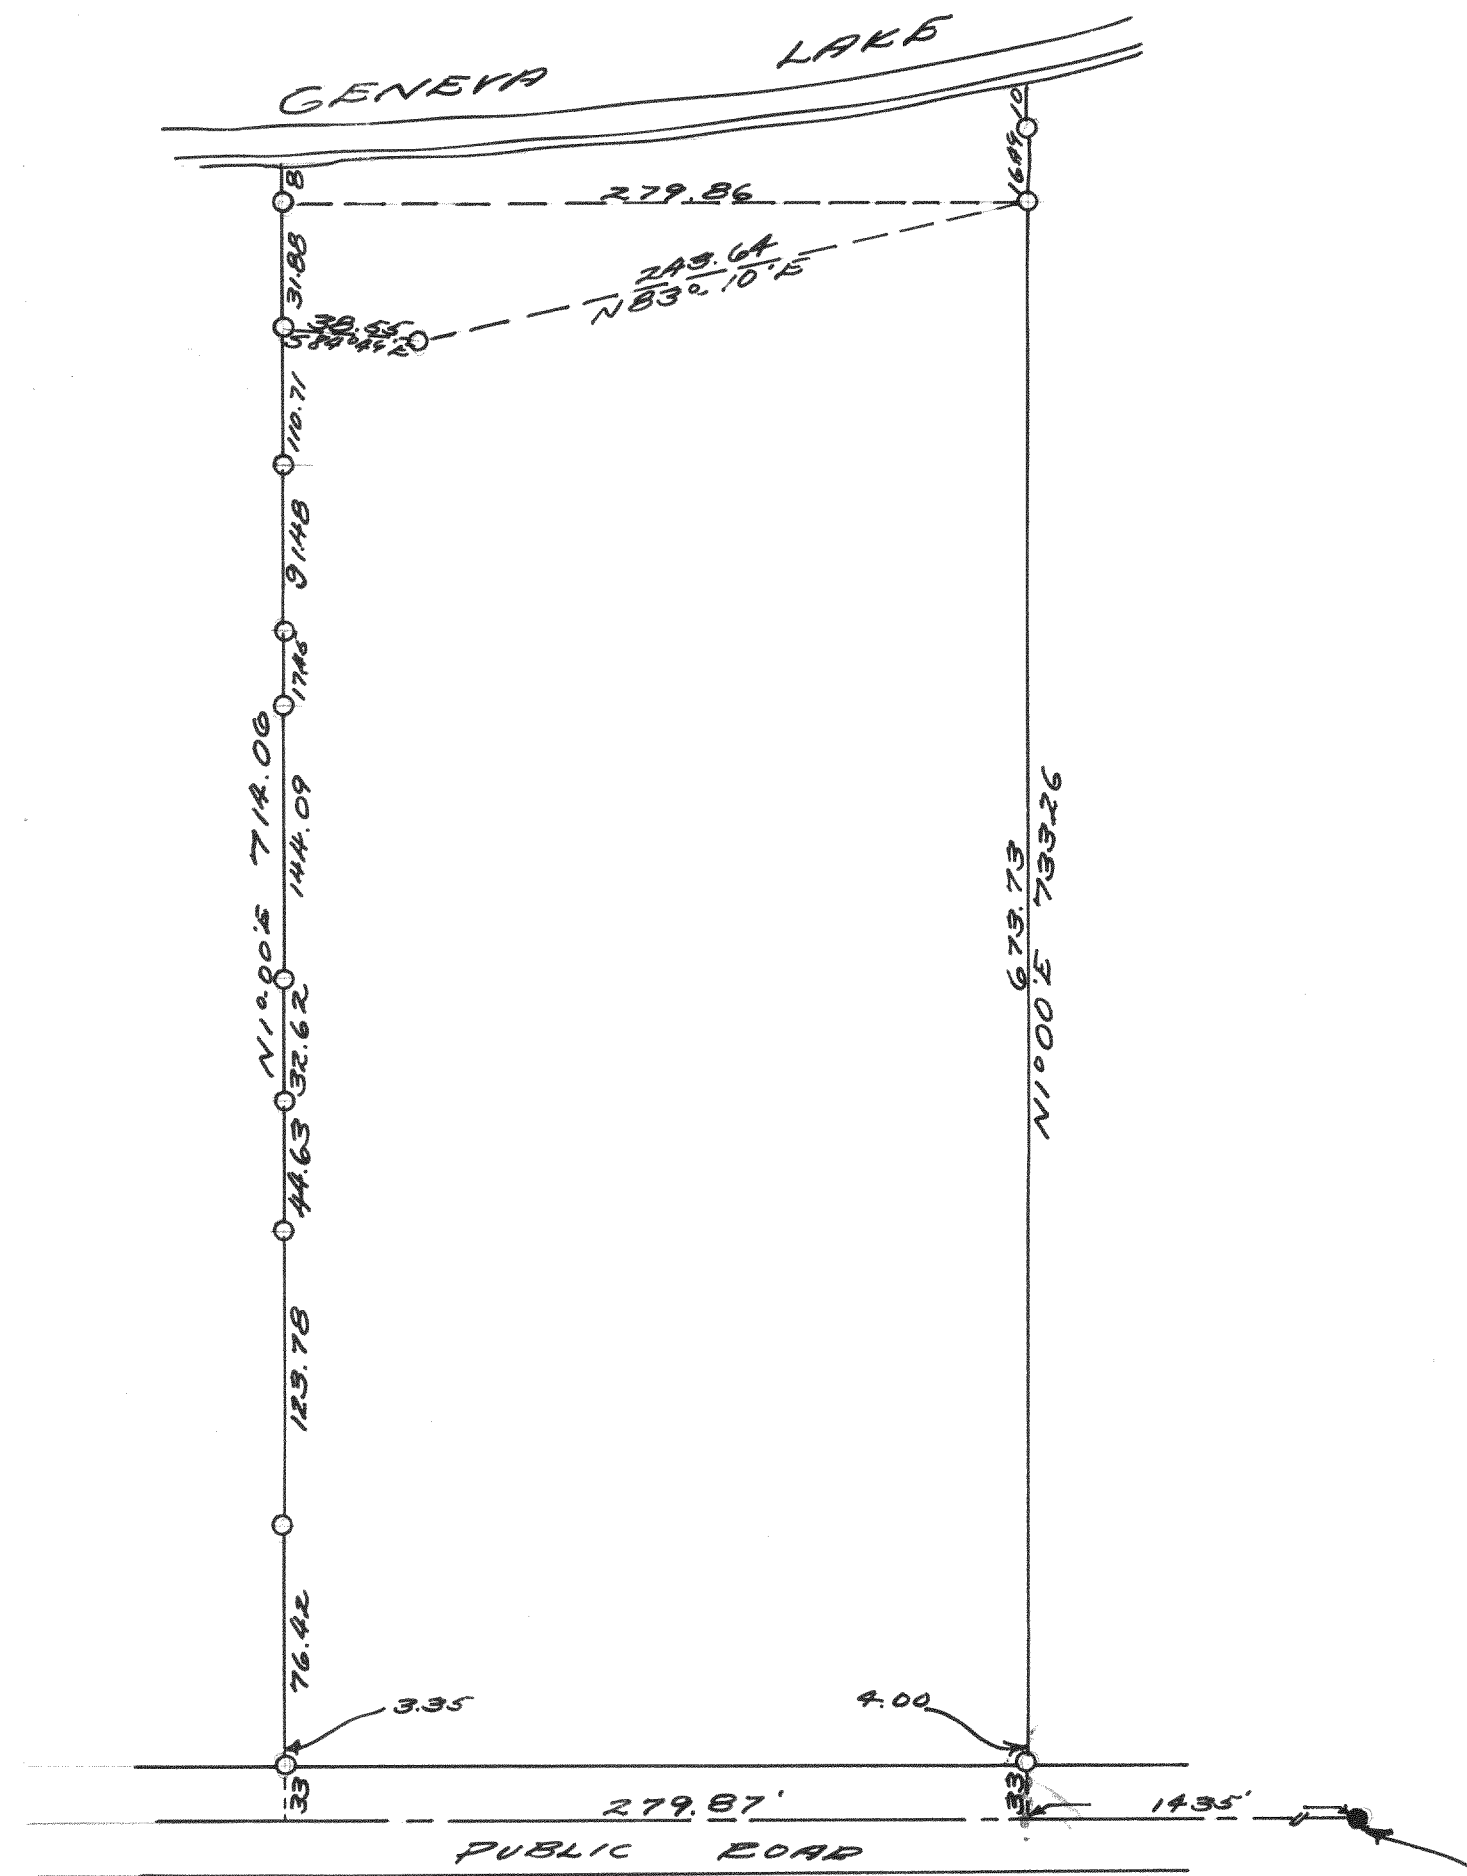

E. 1/4 SECTION CORNER
OF FR. SECTION 13, T1N
R16E, WAL. CO. WISC.

PLAT OF SURVEY OF LAND LOCATED IN THE
NORTH 1/2 OF FR. SECTION 13 T1N R16E, WALWORTH
COUNTY, WISCONSIN
OCT. 1940

Lloyd L. Jensen
S.E.J.