


376


SURVEY NO. 1102

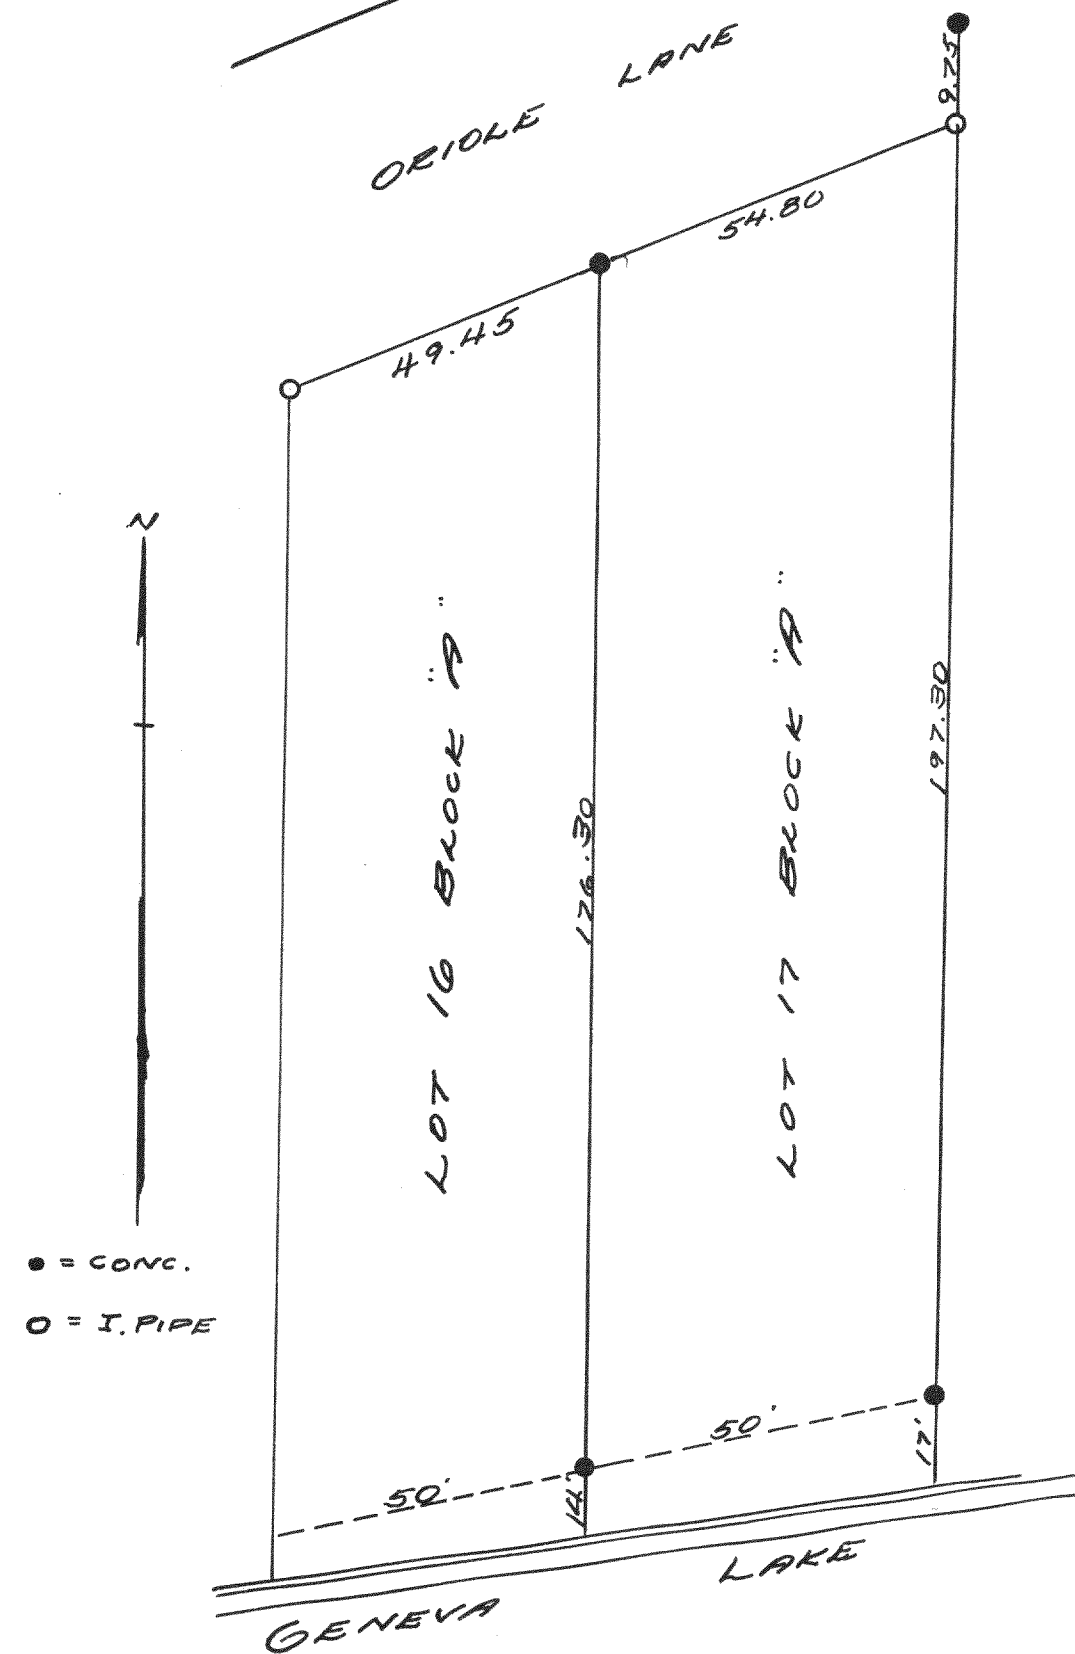

PLAT OF SURVEY OF LOT 17 BLK. "A"
OF CISCO BEACH SUBDIVISION T1N
R17E, WALWORTH COUNTY, WISCONSIN
MAY 27, 1940

Lloyd L. Jensen
N.E.J.


SURVEY NO. 1103

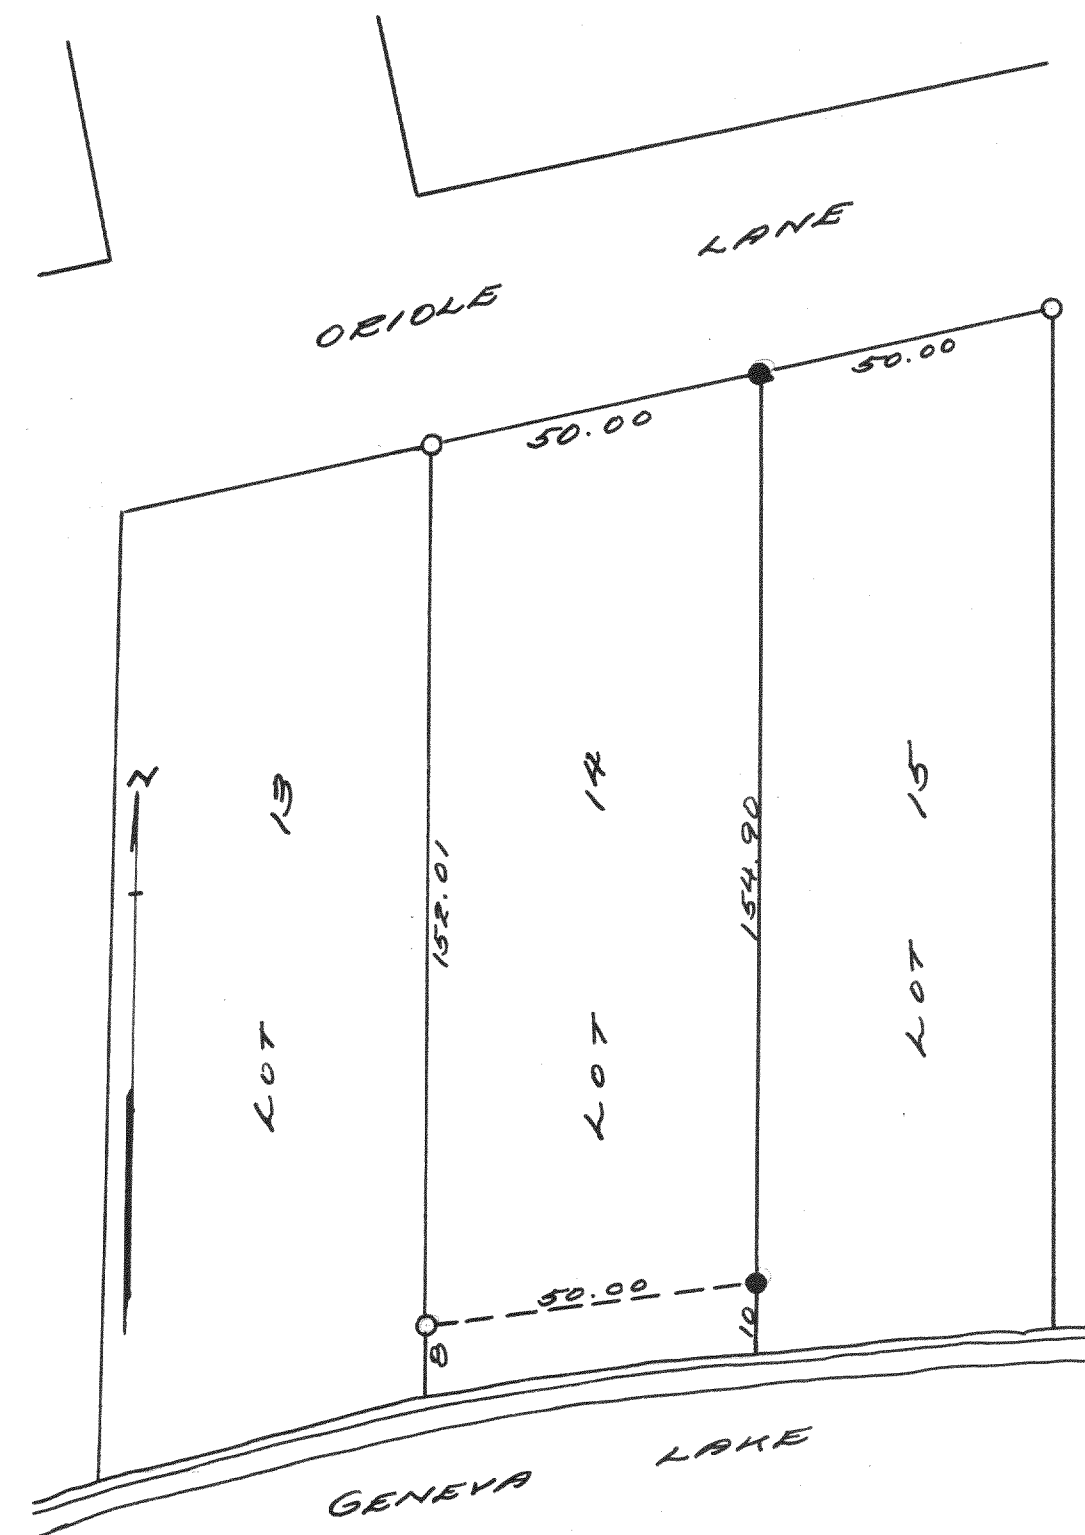

PLAT OF SURVEY OF LOT 14 OF
BLOCK "A" OF CISCO BEACH SUBD.
T1N R17E WALWORTH COUNTY
OCT., 1940

Lloyd L. Jensen
N.E.J.

SURVEY NO. 1104

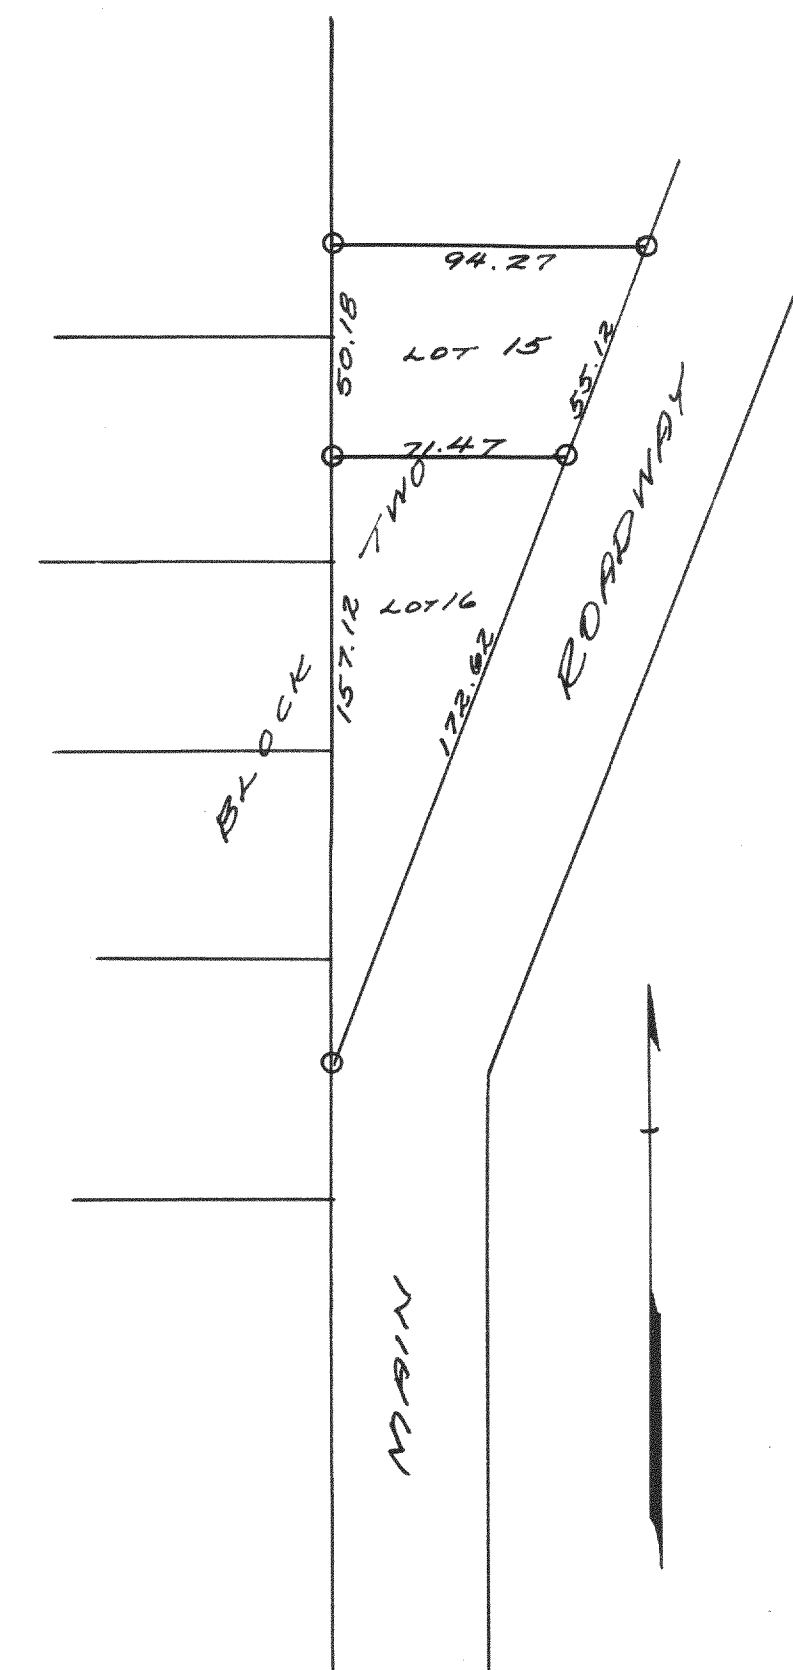

PLAT OF SURVEY OF LOTS 15+16
OF BLOCK 2 OF SUNSET HILLS
SUBDIVISION
JAN. 1941

Lloyd L. Jensen
N.E.J.