



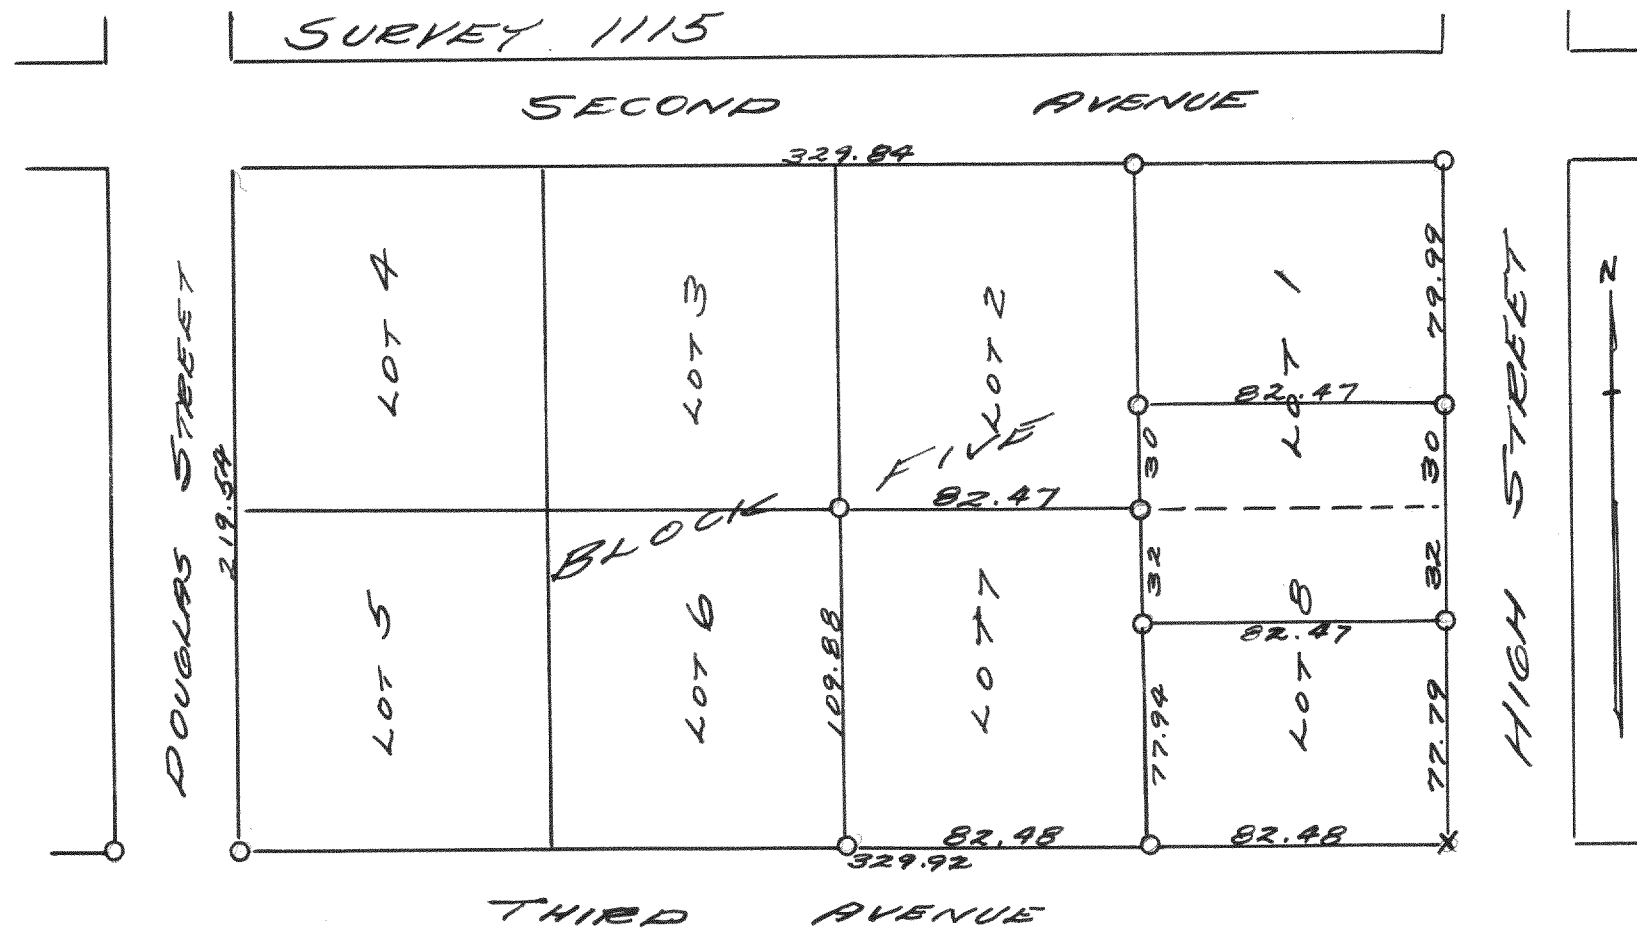


PLAT OF SURVEY OF LOT 7 AND PART
OF LOTS 1 & 8 OF BLOCK 5 OF THE
ORIGINAL PLAT OF FONTANA, WALWORTH
COUNTY, WISCONSIN
JULY, 1940

Lloyd L. Jensen
N.E.J.

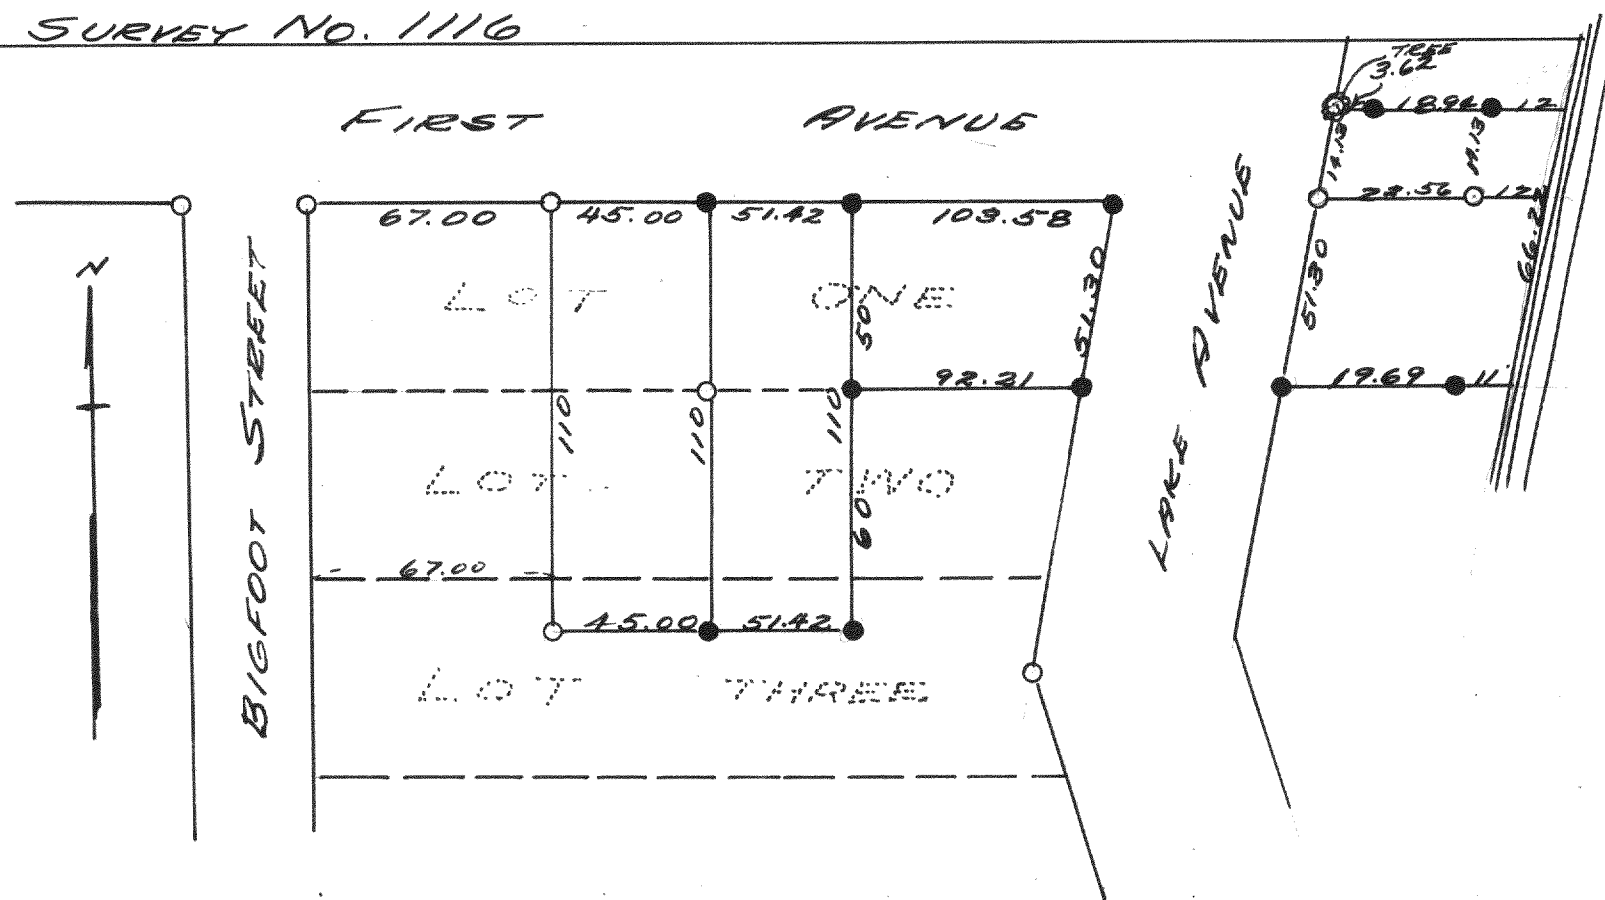

PLAT OF SURVEY OF PART OF LOT 1, BLOCK 1 AND
PART OF LOTS 1, 2, & 3 OF BLOCK 2 OF D.A. RIEBES
ADDITION TO THE VILLAGE OF FONTANA
MARCH 1940 Lloyd L. Jensen

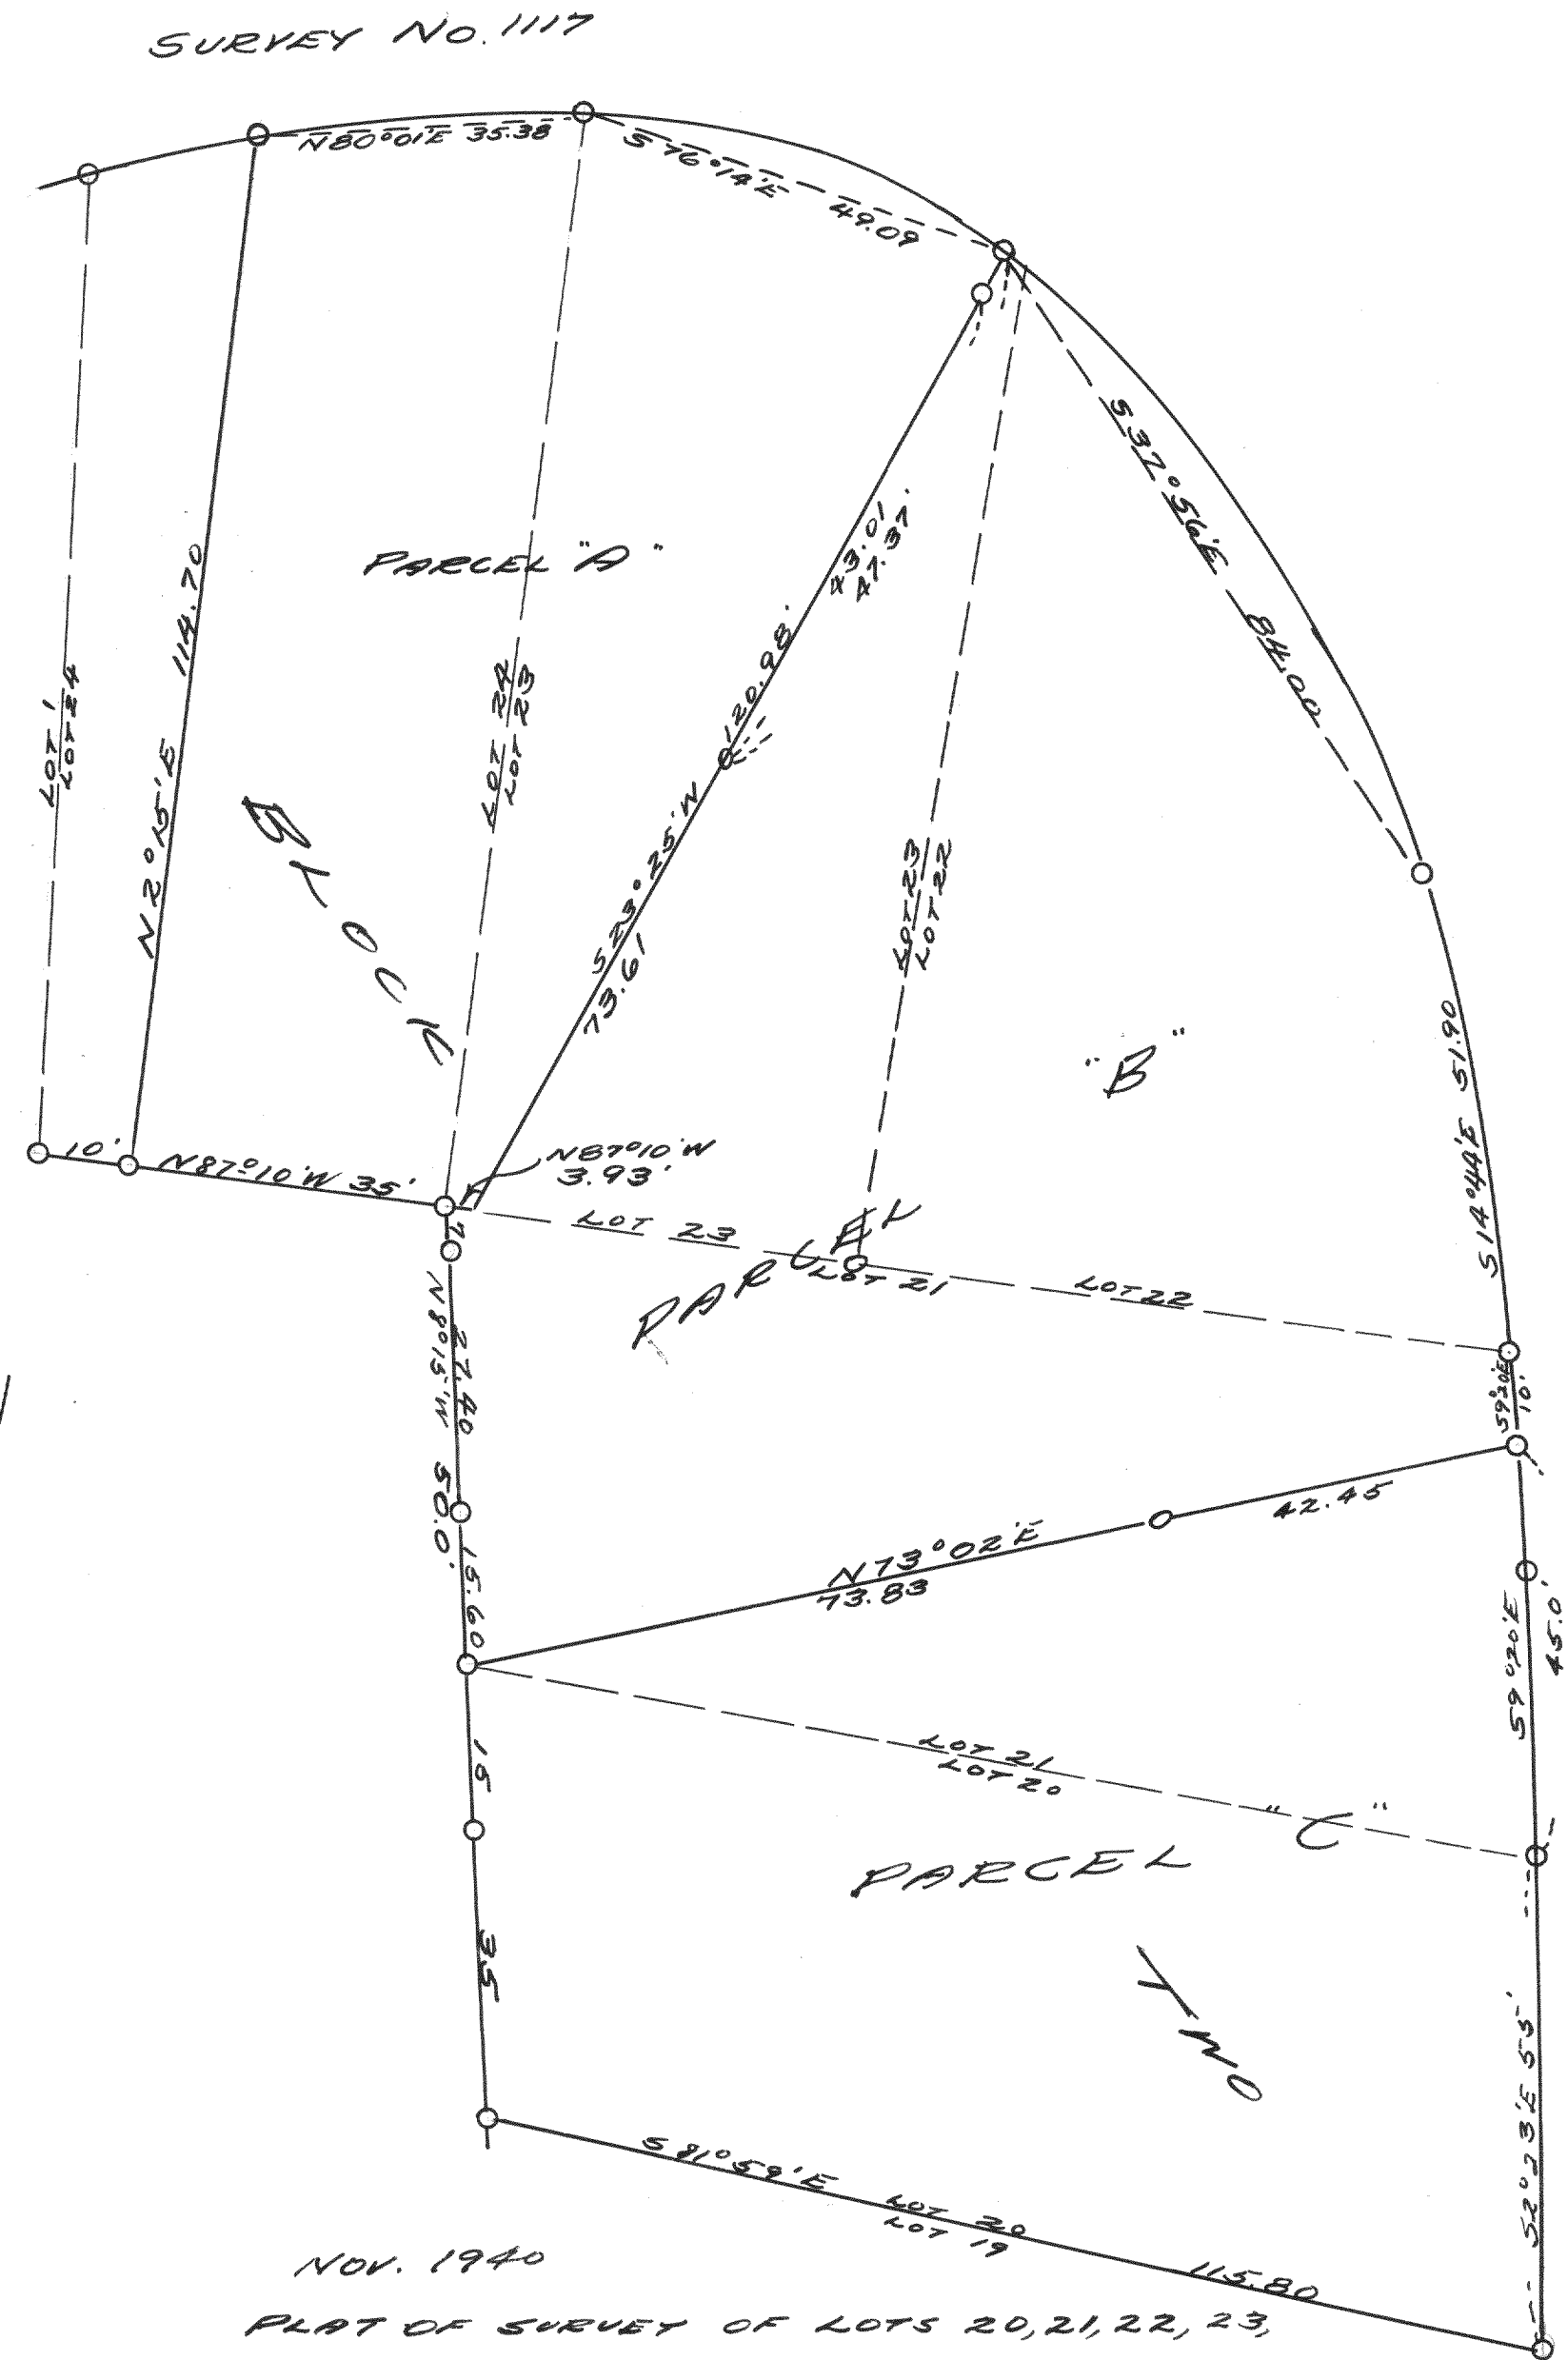

NOV. 1940 19 45.80
 PLAT OF SURVEY OF LOTS 20, 21, 22, 23,
 & 24 OF BLOCK 2 OF THE PLAT OF INDIAN
 HILLS, FONTANA, WAL. CO. WISC. Lloyd L. Jensen
 L.S.J.