

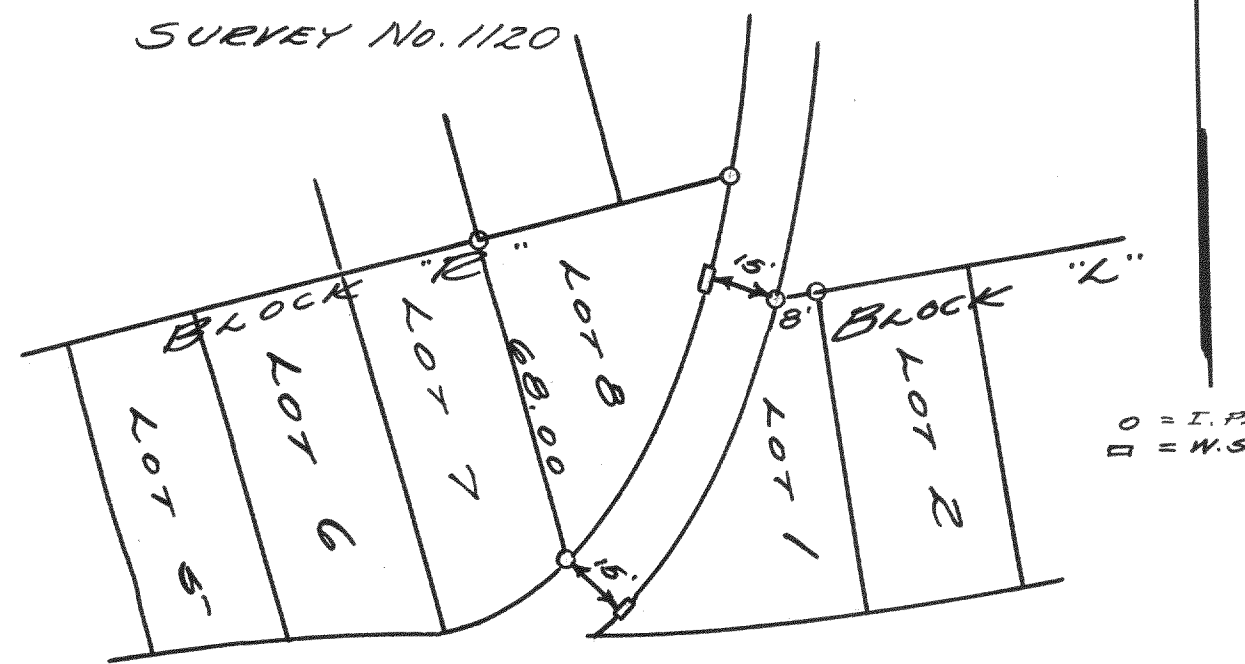


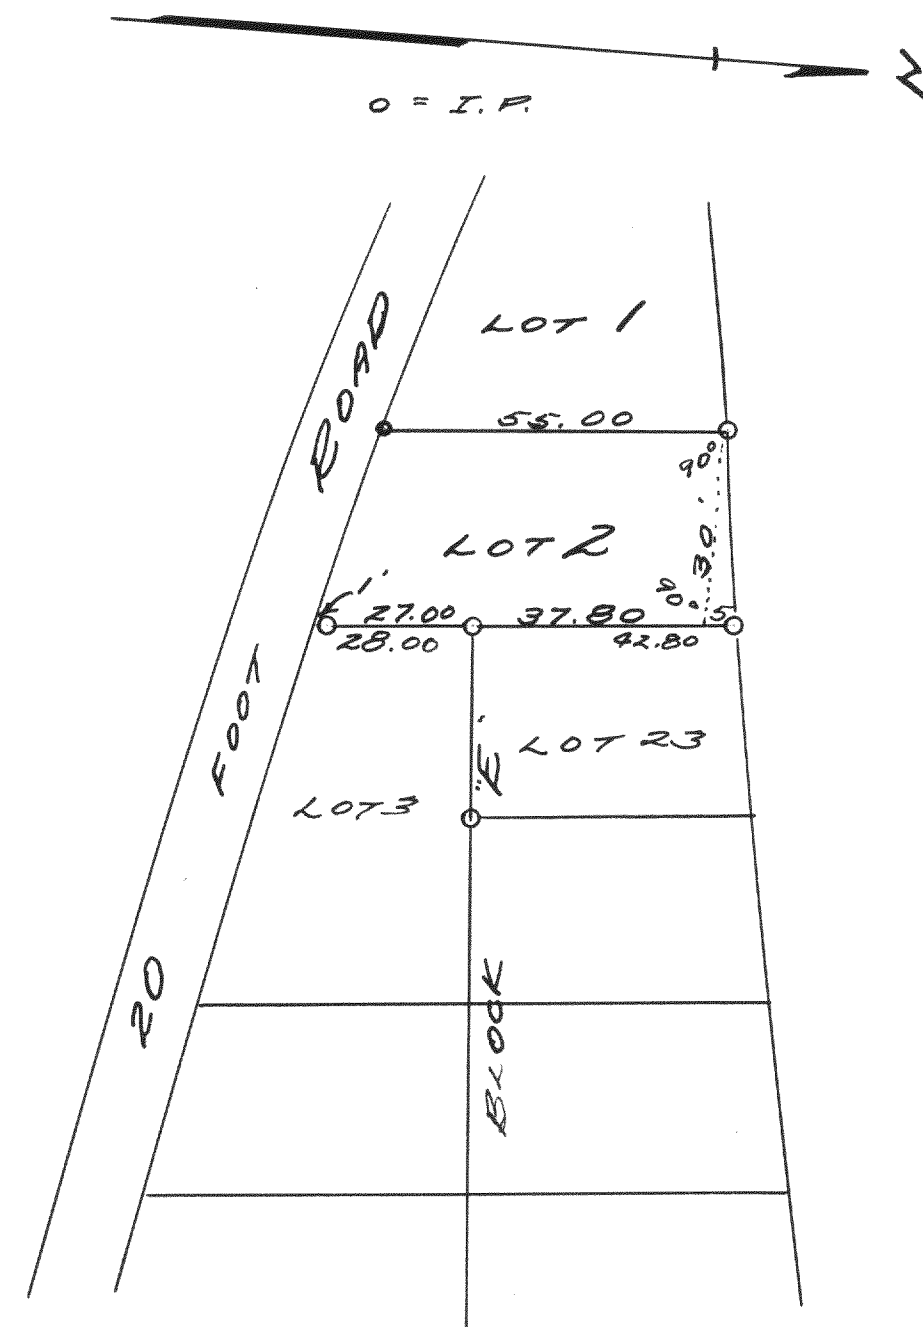

PLAT OF SURVEY OF 15' DRIVE
BETWEEN LOT 1, BLOCK "L" AND
LOT 8, BLOCK "R" OF DELAVAN
LAKE ASSEMBLY PARK.
JULY 20, 1940 Lloyd L. Jensen
N.E.S.

PLAT OF SURVEY OF LOT 2 OF
BLOCK "E" OF DELAVAN LAKE
ASSEMBLY PARK, WAH. CO., WISC.
SEPT 1940 Lloyd L. Jensen
N.E.S.


SURVEY NO. 1119
WEST 1/8 CORNER NE 1/4 26-2-16

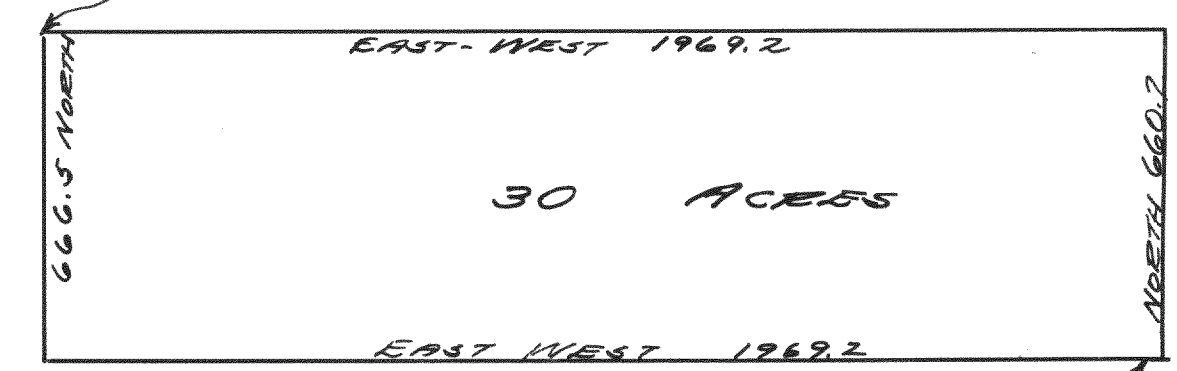

SOUTH LINE OF THE N 1/2 S 1/2 NE 1/4 26-2-16

PLAT OF SURVEY OF THE WEST 1969.2 FEET OF THE
NORTH 1/2 OF THE S 1/2 NE 1/4, 26-2-16
1940 Lloyd L. Jensen
N.E.S.

SURVEY NO. 1121

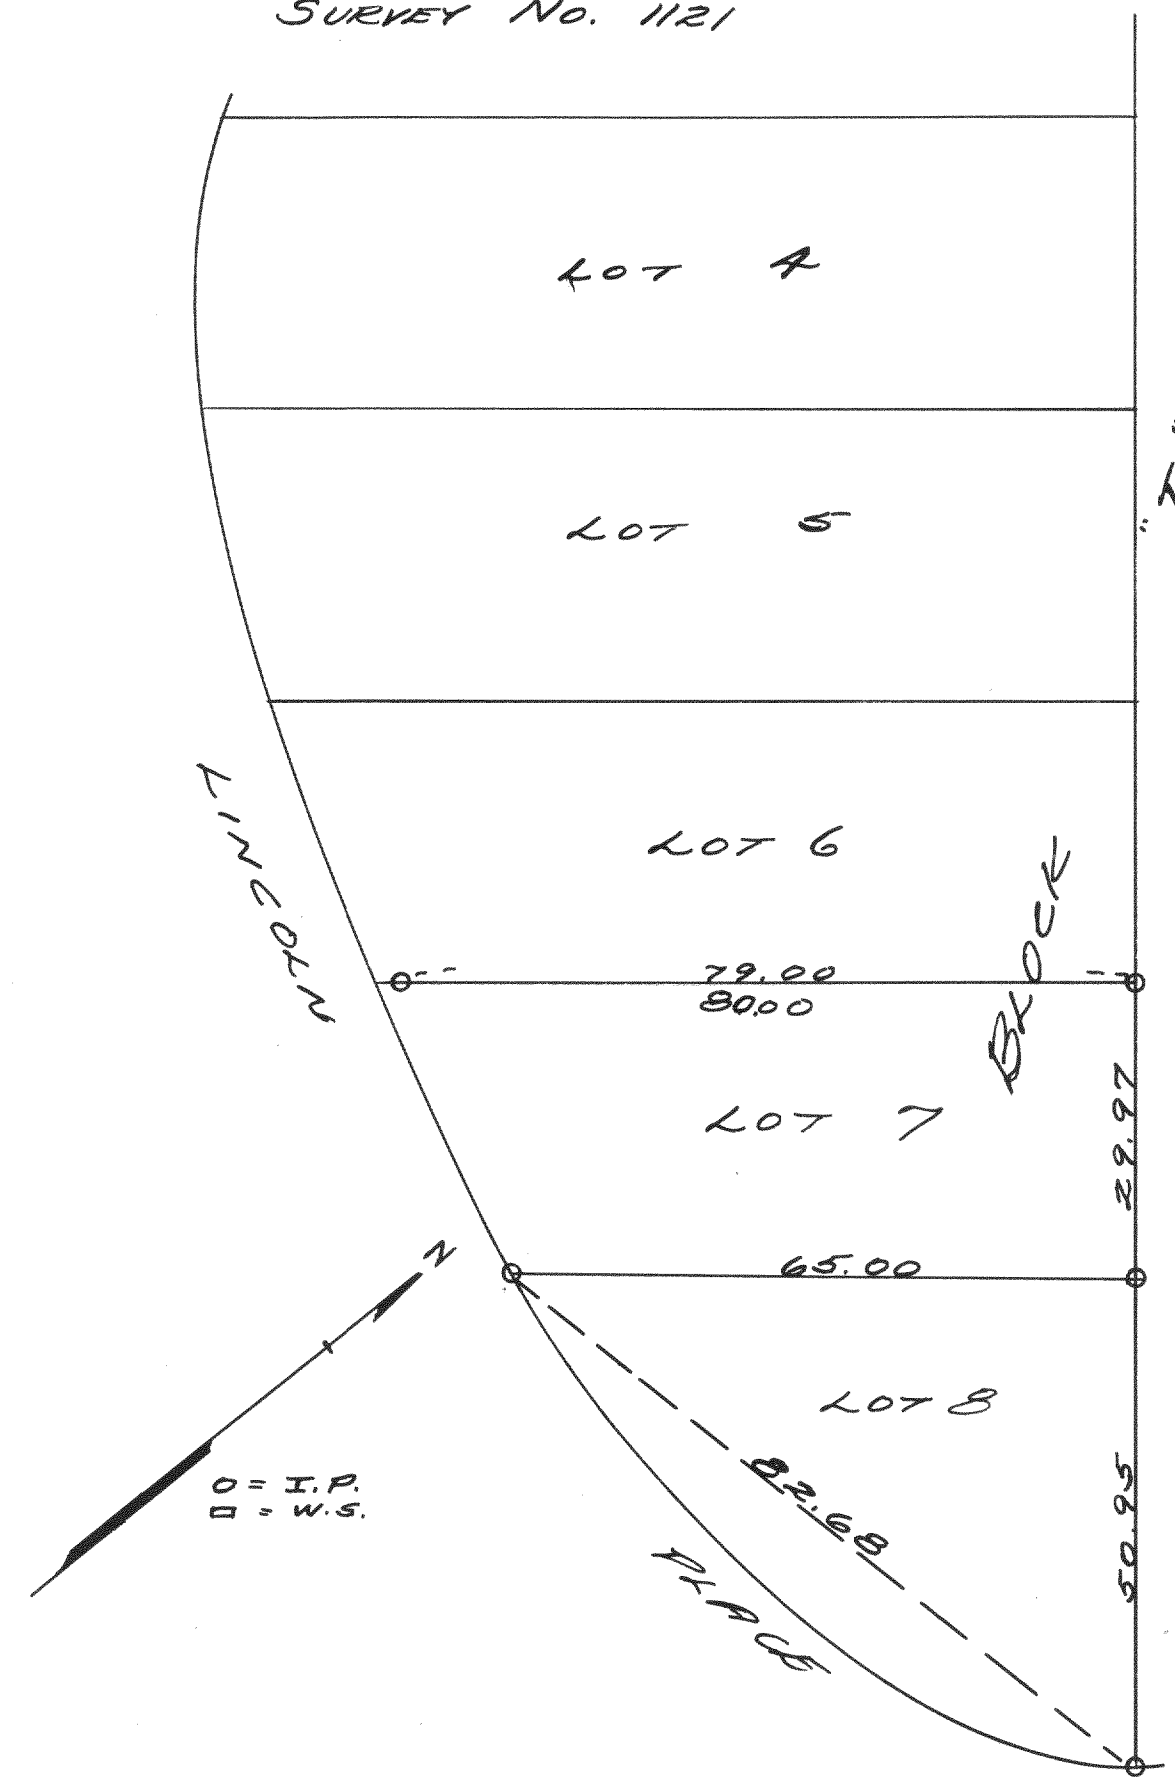

PLAT OF SURVEY OF LOTS 7 & 8
OF BLOCK "I", DELAVAN LAKE
ASSEMBLY PARK, WAH. CO., WISC.
JULY 6, 1940

Lloyd L. Jensen
N.E.S.