


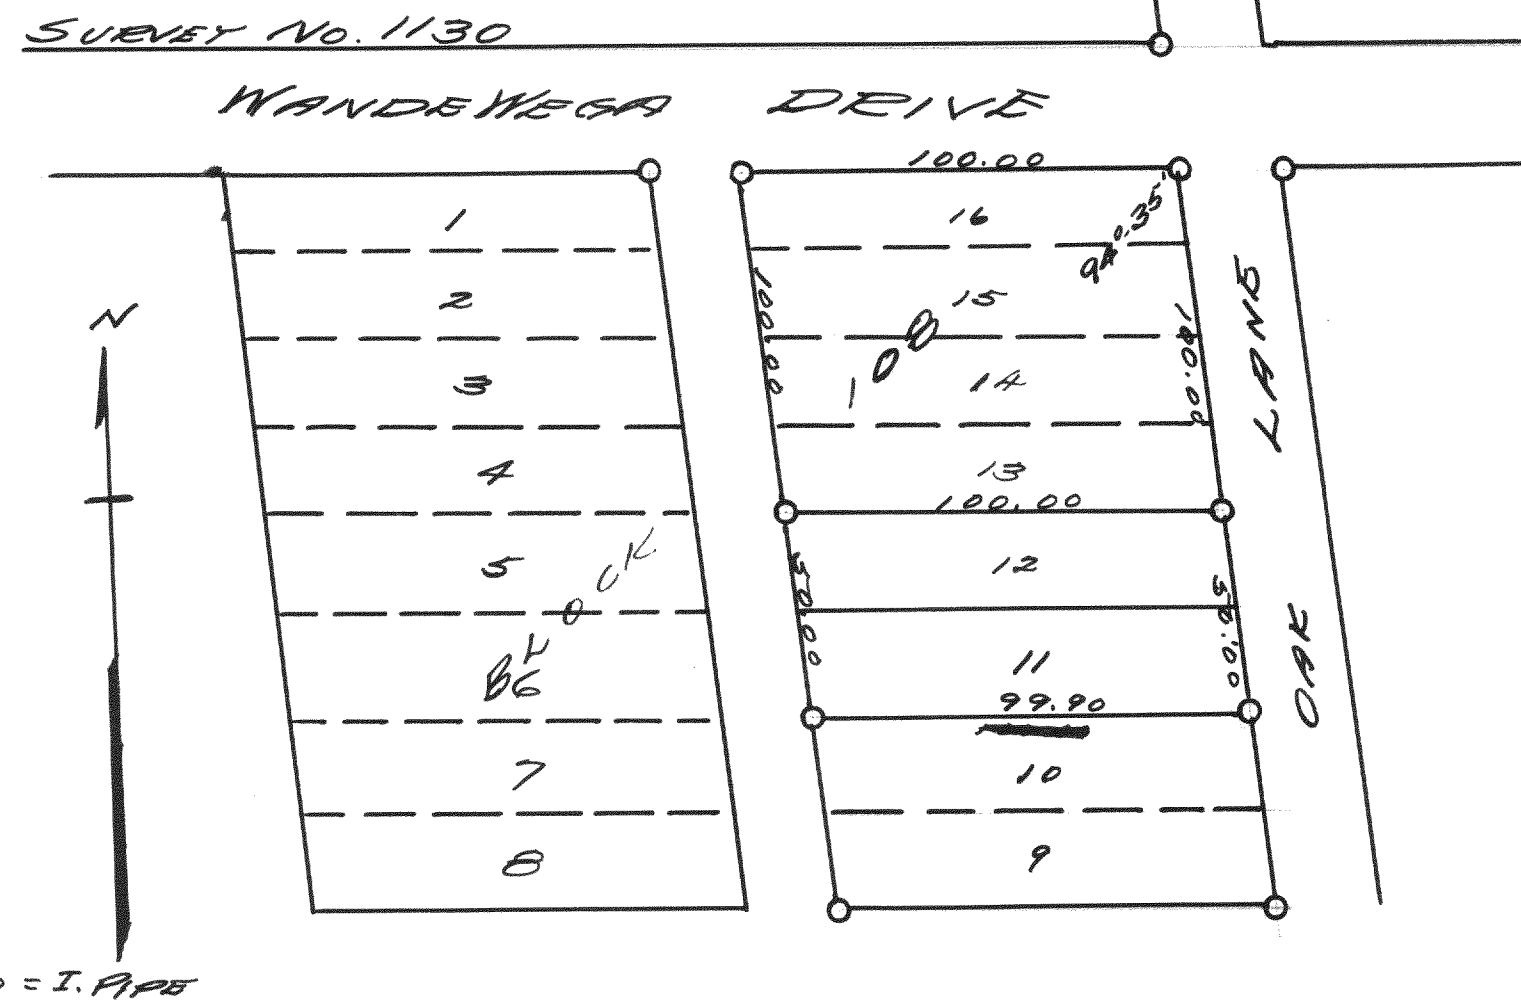

PLEASANT LAKE

N 75° 13' W 121.10

S 82° 04' W 67.95

94.09 N 88° 33' W 50'

52° 00' E 62.32

52° 31' E 69.65

53° 52' E 85.18

54° 42' 90.40

52° 35' E 90.35

58° 30' W 84.58

58° 30' W 91.10

58° 30' W 50'

140' NORTH

140' NORTH

115.40

31.70

292.10

POINT 2125 FT NORTH
SE. COR. OF THE WEST 1/2
OF THE NE 1/4 OF SECTION 25
TAN RILEY TR. CO. WASE

0 = I. PIPE

LINE OF DESCRIPTION

LINE OF OCCUPATION

PLAT OF SURVEY OF LAND IN THE
NE 1/4 25-4-16
1940

Lloyd L. Jensen
H.E.