



SURVEY NO. 1132

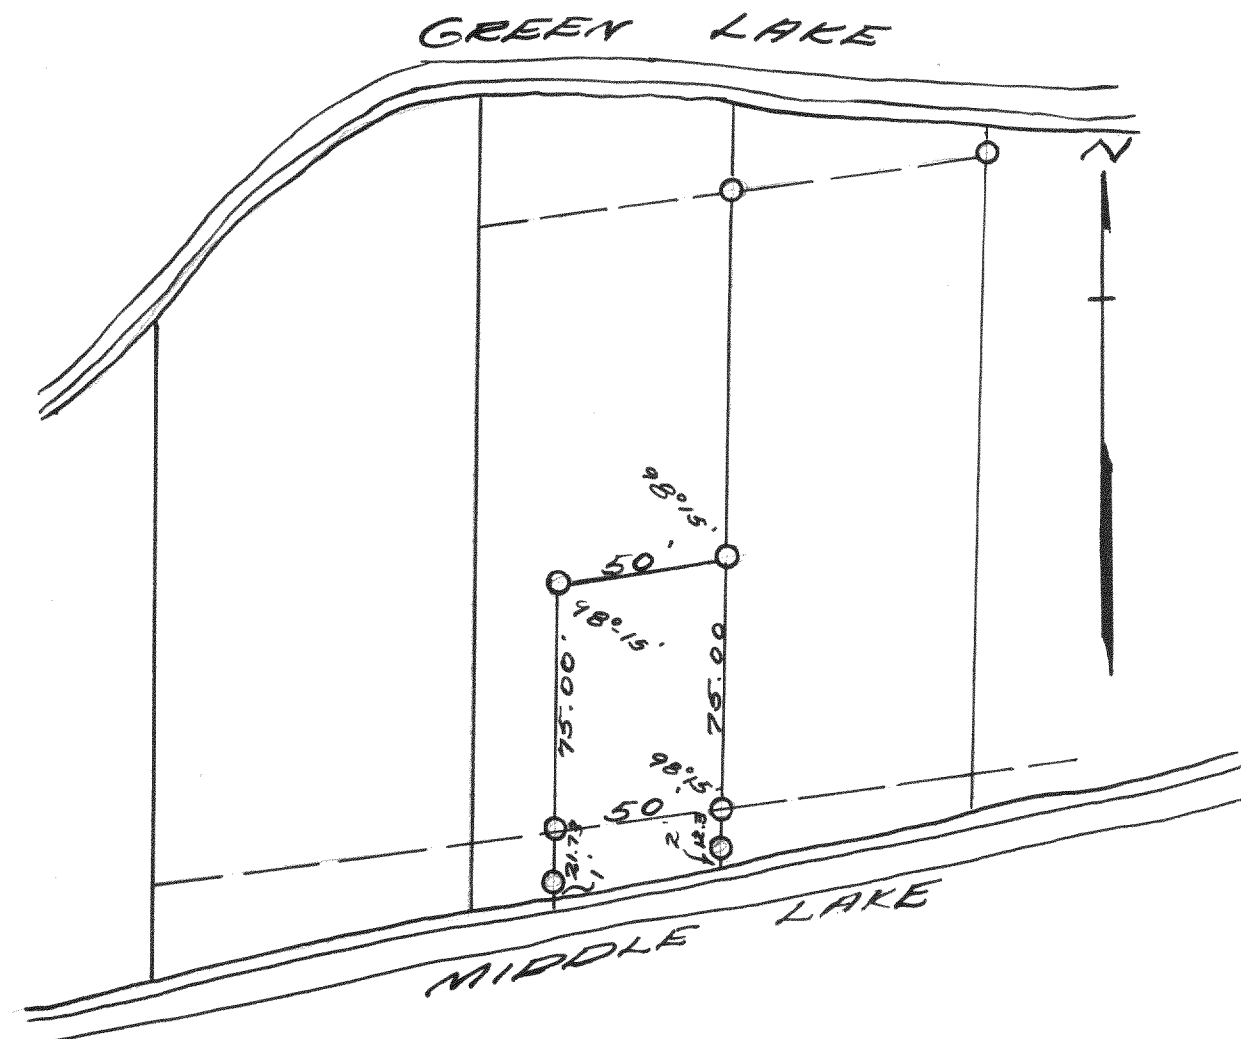

PLAT OF SURVEY OF PART OF LOT 2
OF LAUDEEDALE PARK T4N R16E,
WALWORTH CO. WISC.

AUG. 1940


Lloyd L. Jensen
H.E.J.

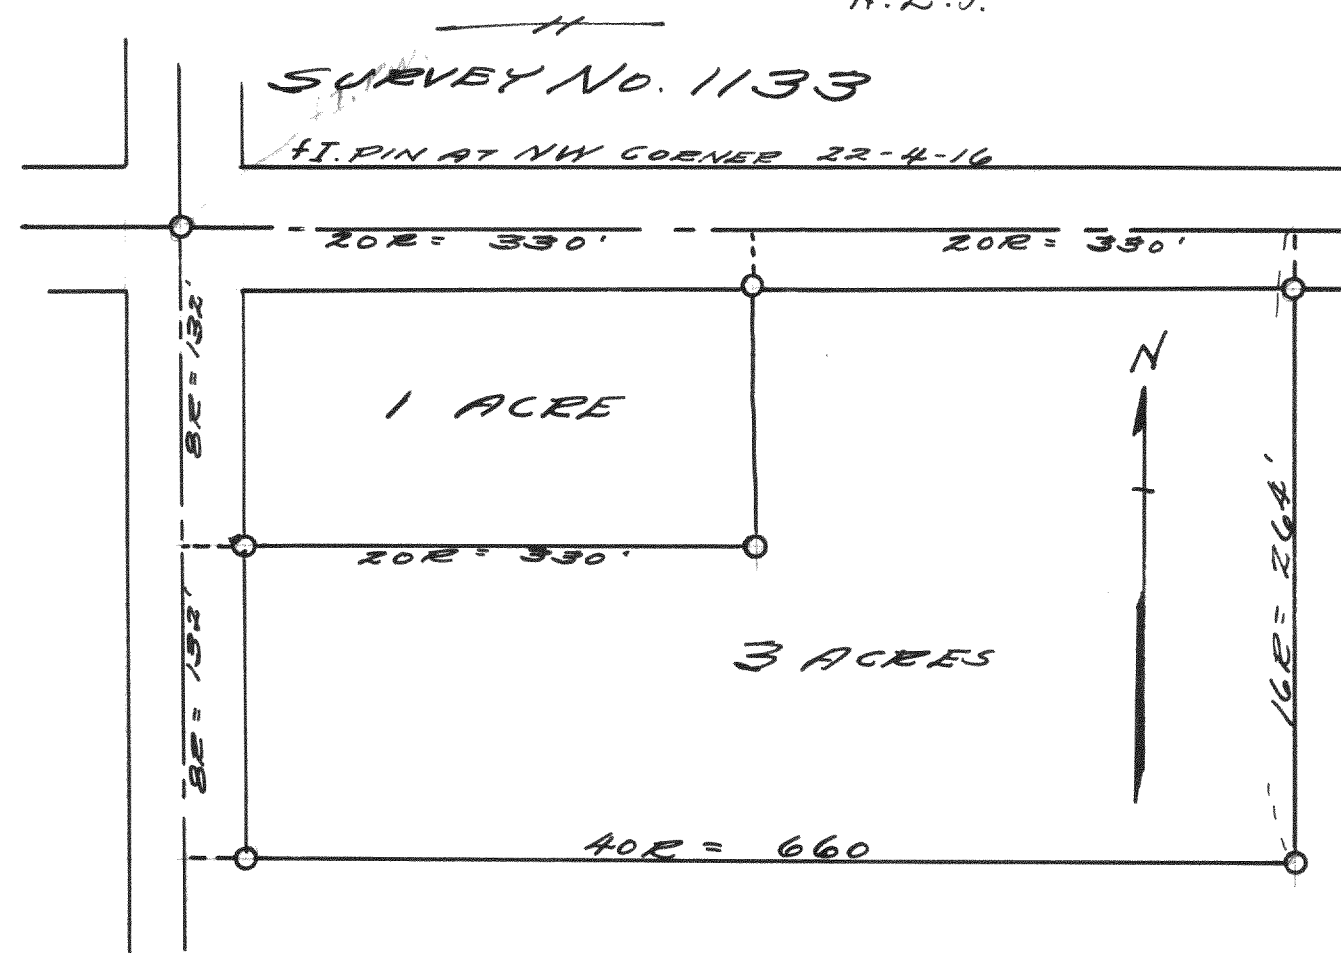

PLAT OF SURVEY OF 3.00 ACRES
OF LAND IN THE NW 1/4 22-4-16, WAL.
CO. WISC.
JAN 31 1940

Lloyd L. Jensen
H.E.J.


SURVEY NO. 1134

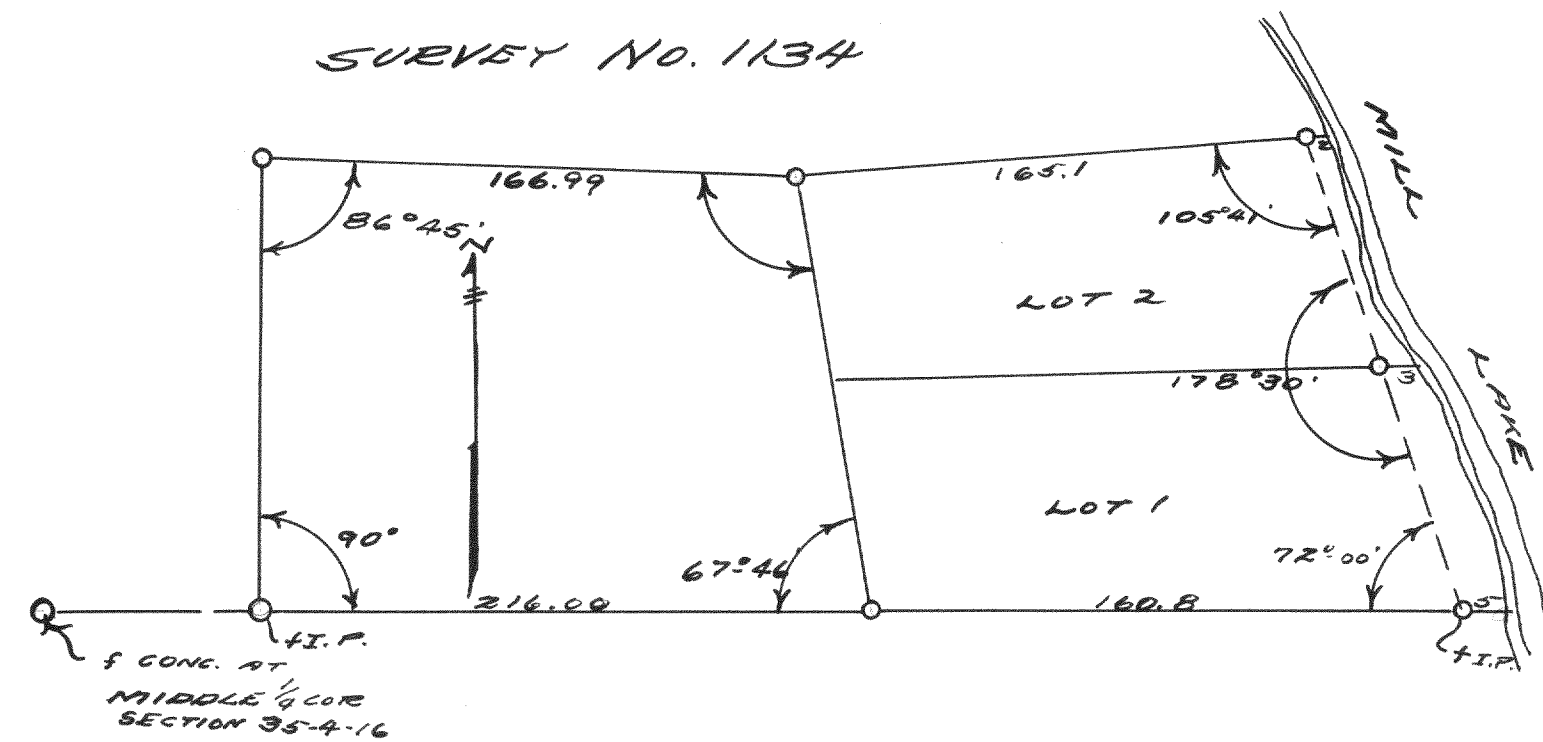

PLAT OF SURVEY OF LOTS 1 & 2 OF
LOST NATION PARK, SECTION 35
T4N R16E, WALWORTH COUNTY WISC.
NOV. 1939

Lloyd L. Jensen
H.E.J.

SURVEY NO. 1135

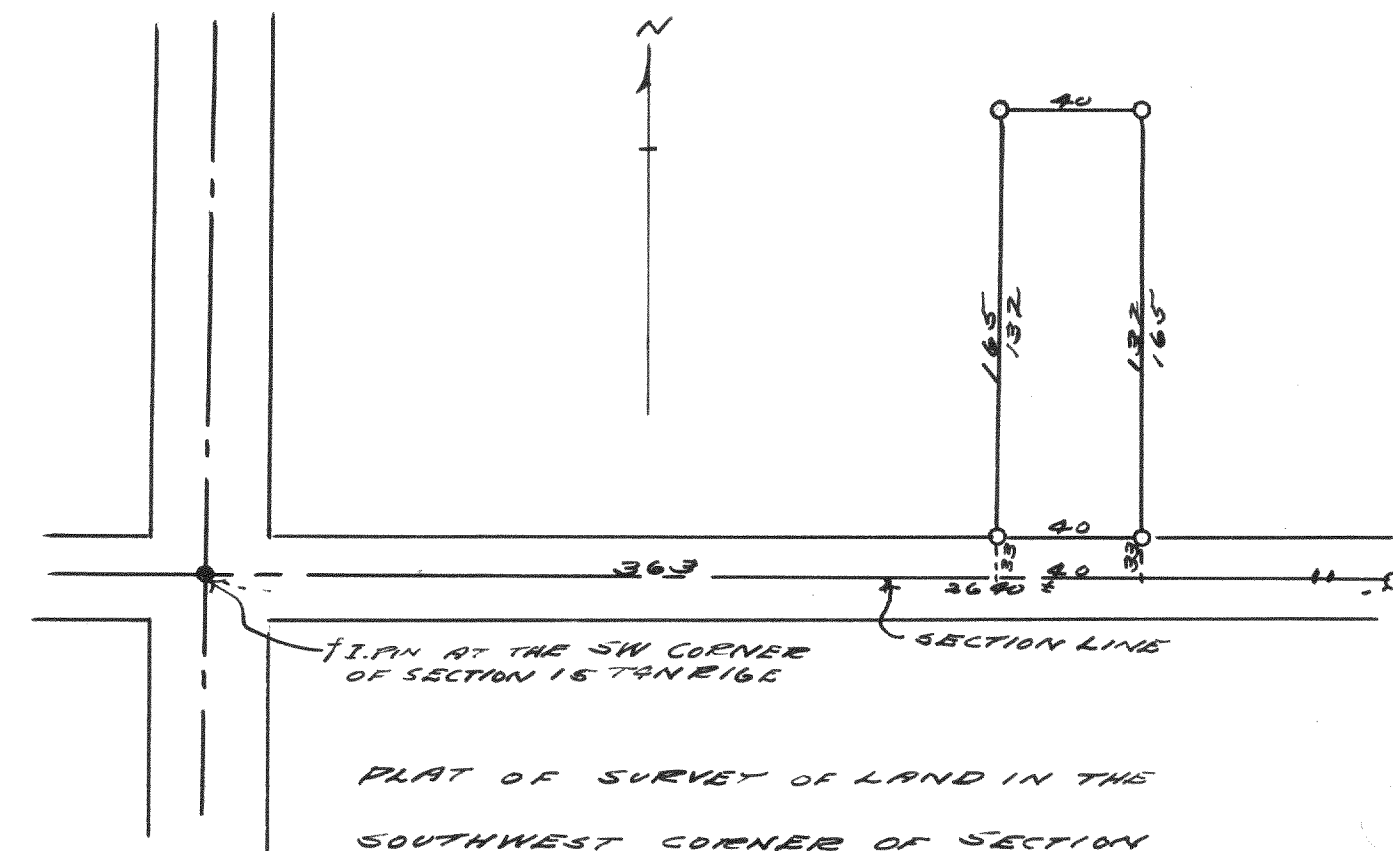

PLAT OF SURVEY OF LAND IN THE
SOUTHWEST CORNER OF SECTION
15 T4N R16E, WAL. CO. WISC.

MAY, 1940

Lloyd L. Jensen
H.E.J.