


SURVEY NO. 1143


NW CORNER OF SECTION
20 TAN RIBE

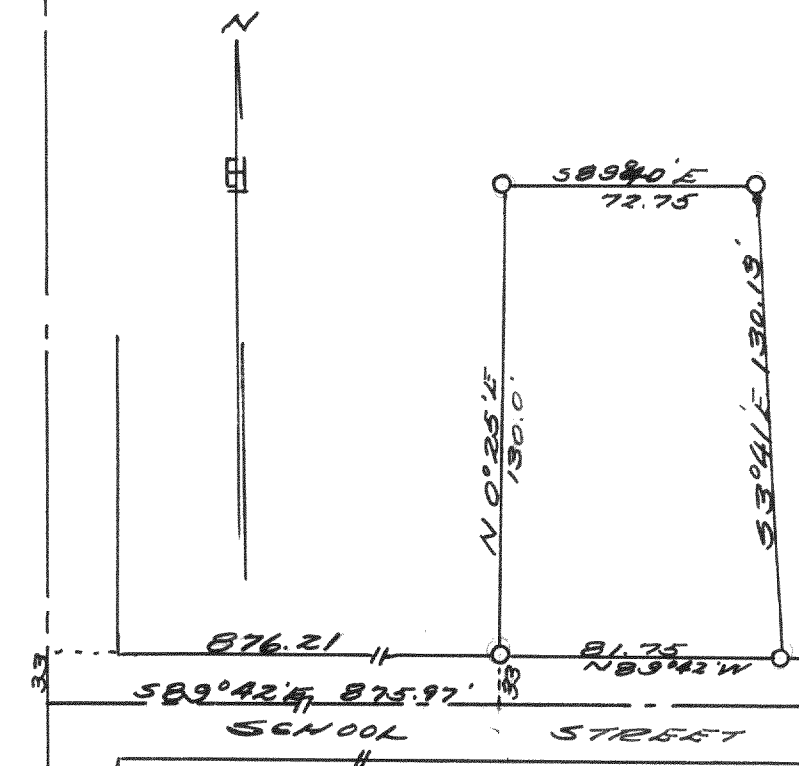

SOUTHWEST CORNER OF
SECTION 20 TAN RIBE


PLAT OF SURVEY OF LAND IN
THE SOUTHWEST QUARTER OF
SECTION 20 TAN RIBE
JUNE 22, 1940 Lloyd L. Jensen
N.E.J.

SURVEY NO. 1144

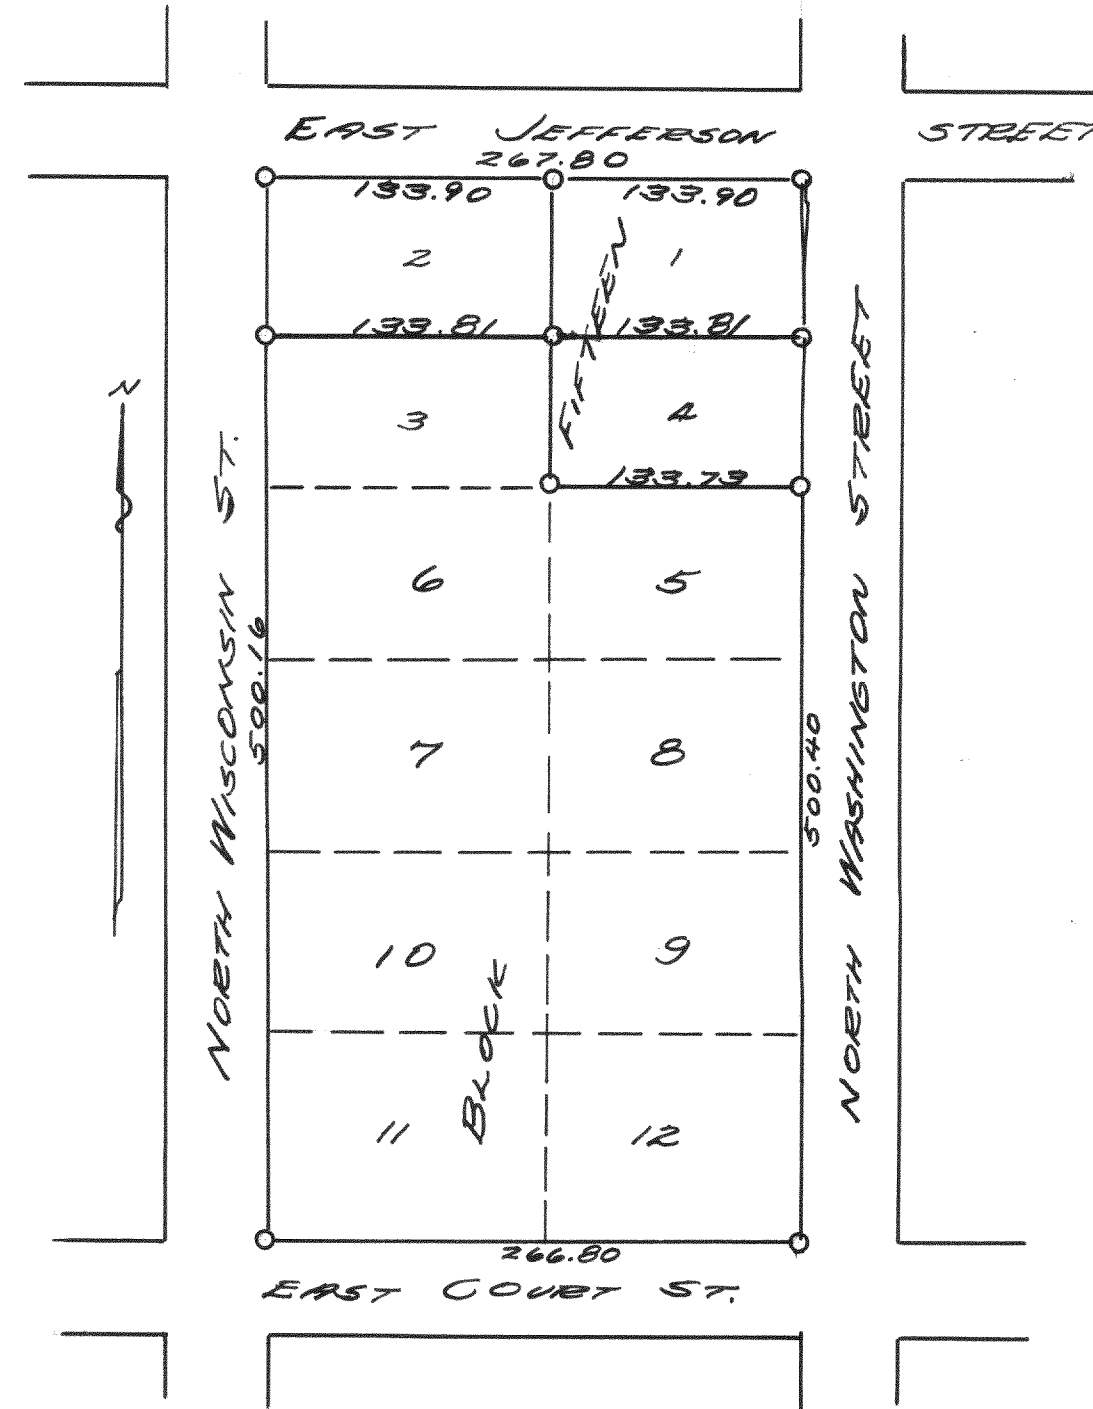


PLAT OF SURVEY OF LOTS
1, 2 & 4 OF BLOCK 15 OF THE
ORIGINAL PLAT OF ELKHORN,
WALWORTH COUNTY, WISCONSIN.
AUG. 1940 Lloyd L. Jensen
N.E.J.

SURVEY NO. 1145

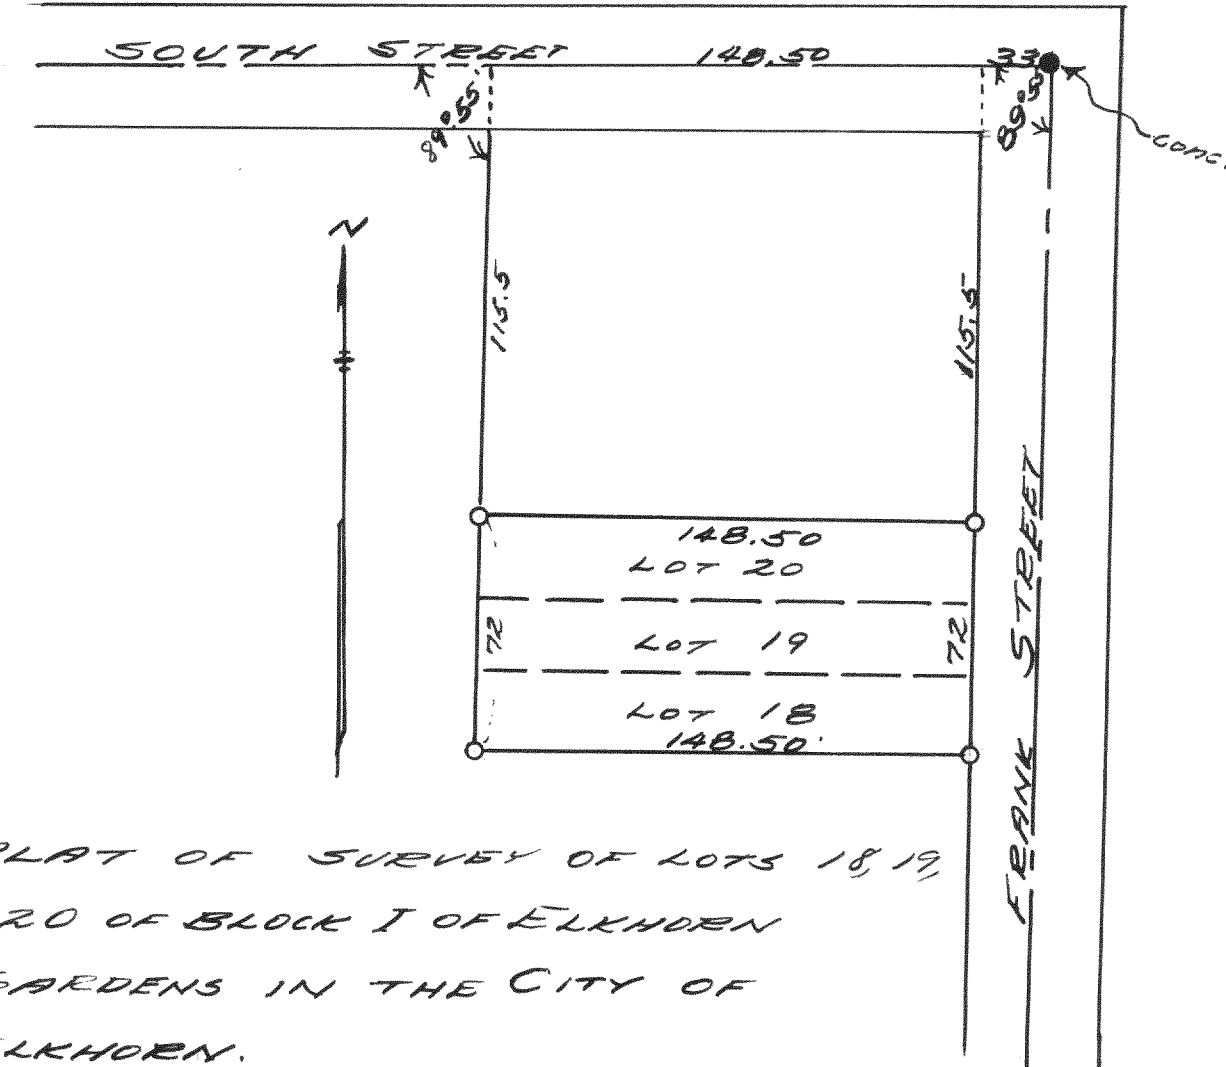

PLAT OF SURVEY OF LOTS 18, 19
& 20 OF BLOCK I OF ELKHORN
GARDENS IN THE CITY OF
ELKHORN.
1940 Lloyd L. Jensen
N.E.J.

SURVEY NO. 1146

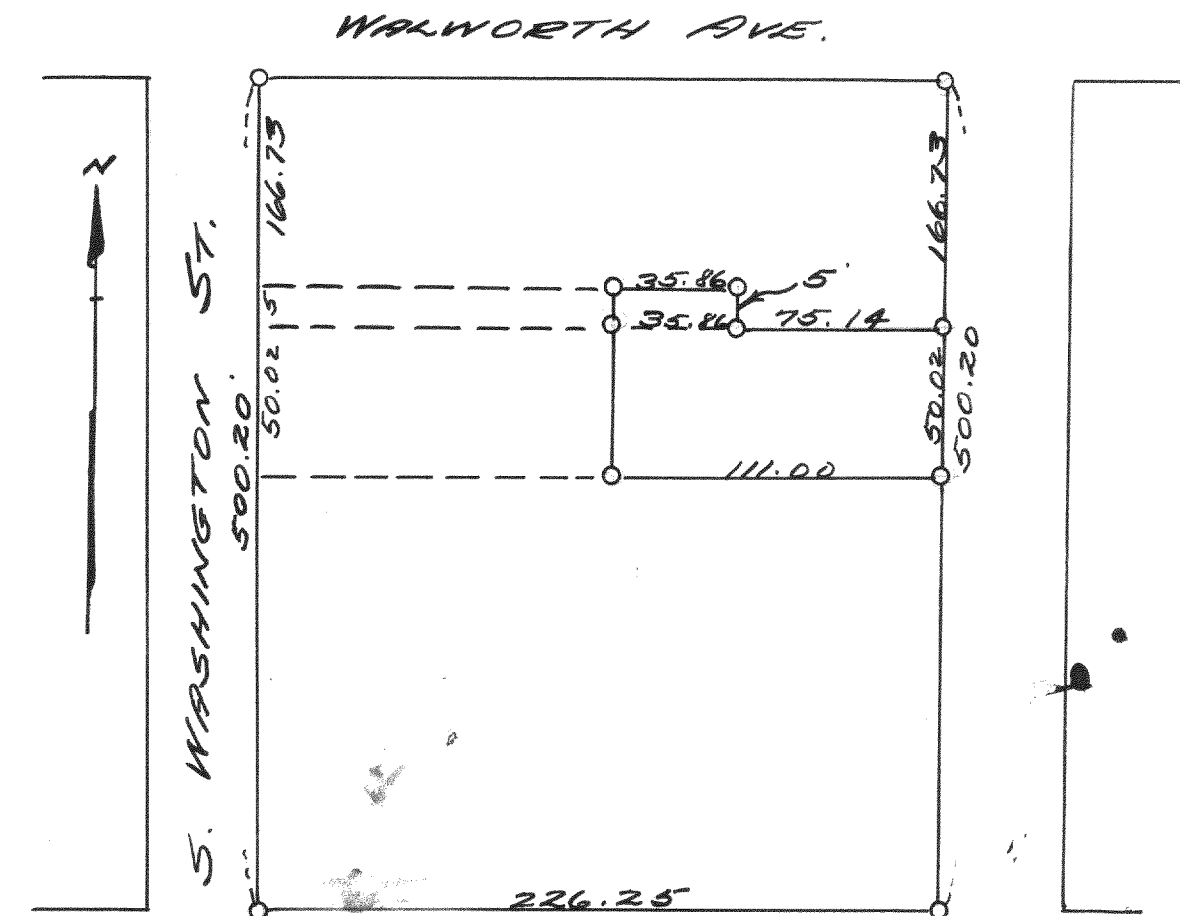

PLAT OF SURVEY OF THE
EAST 111' OF THE N. 3/4 OF LOT
4 & 5.5 OF LOTS 2 & 3, BLOCK 15, ELKHORN