



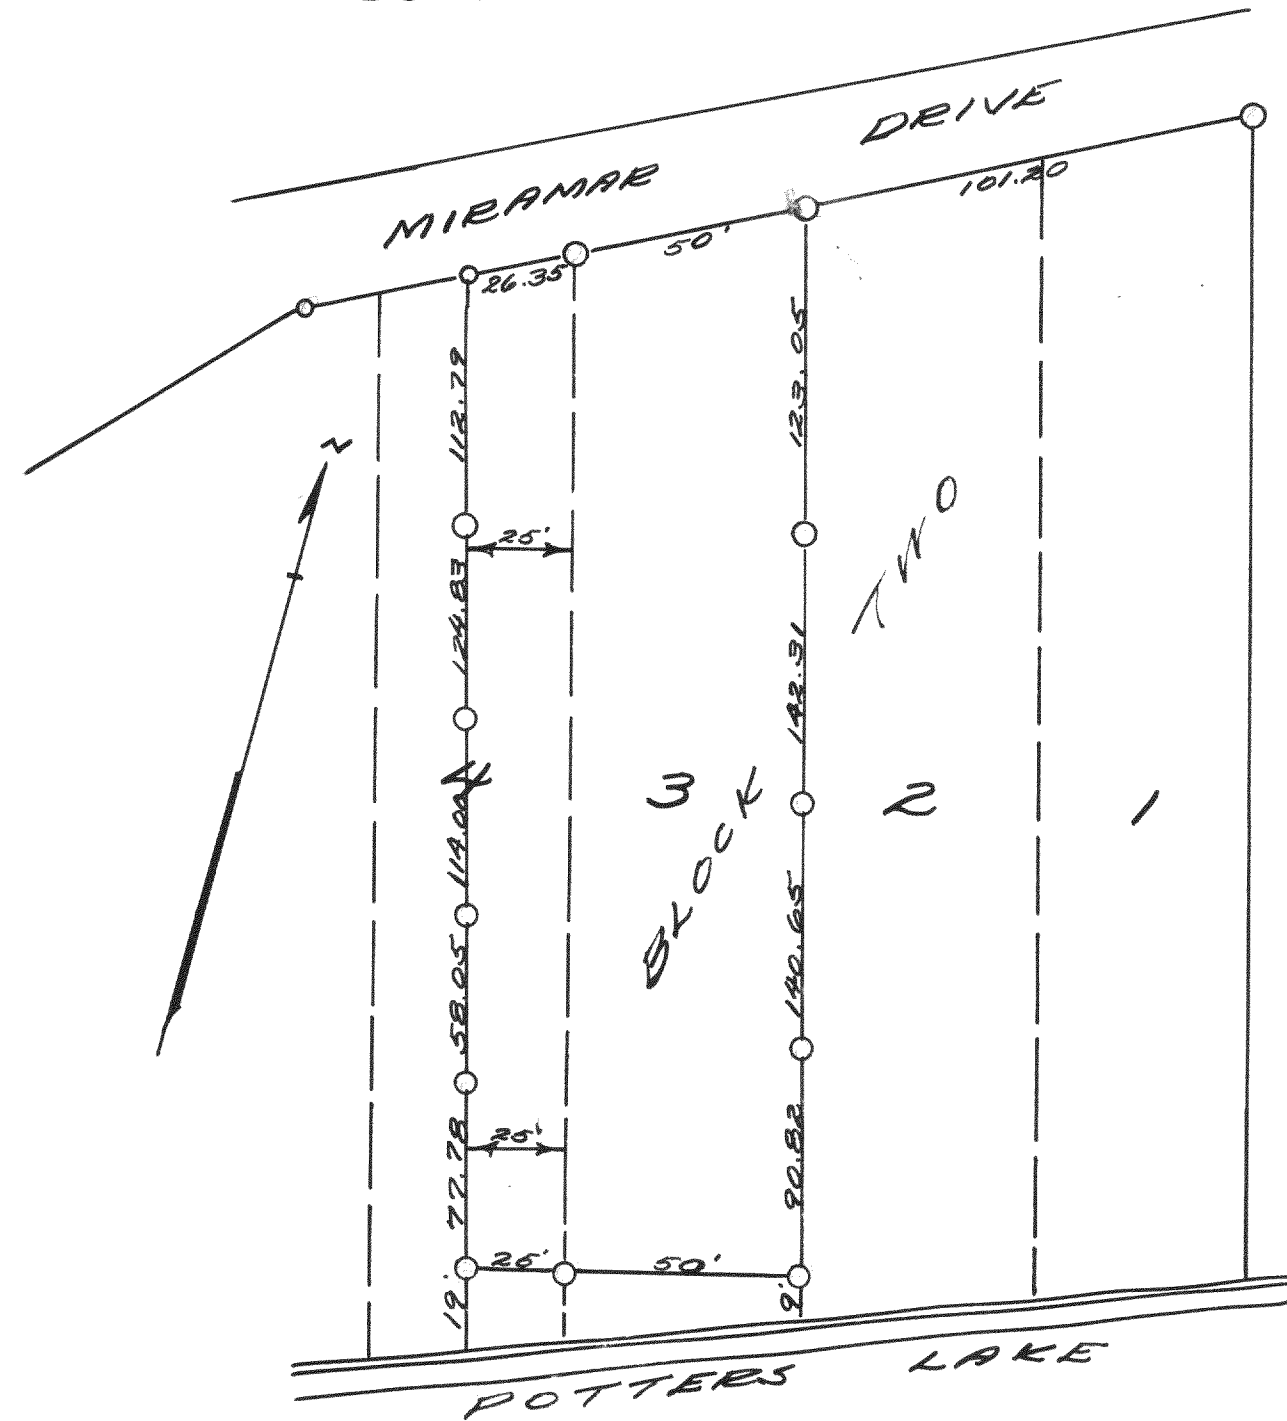


PLAT OF SURVEY OF LOT 3 and
the East 25 feet of Lot 4 of
MIRAMAR SUBDIVISION
OCT. 25, 1940

Lloyd L. Jensen
S.E.J.

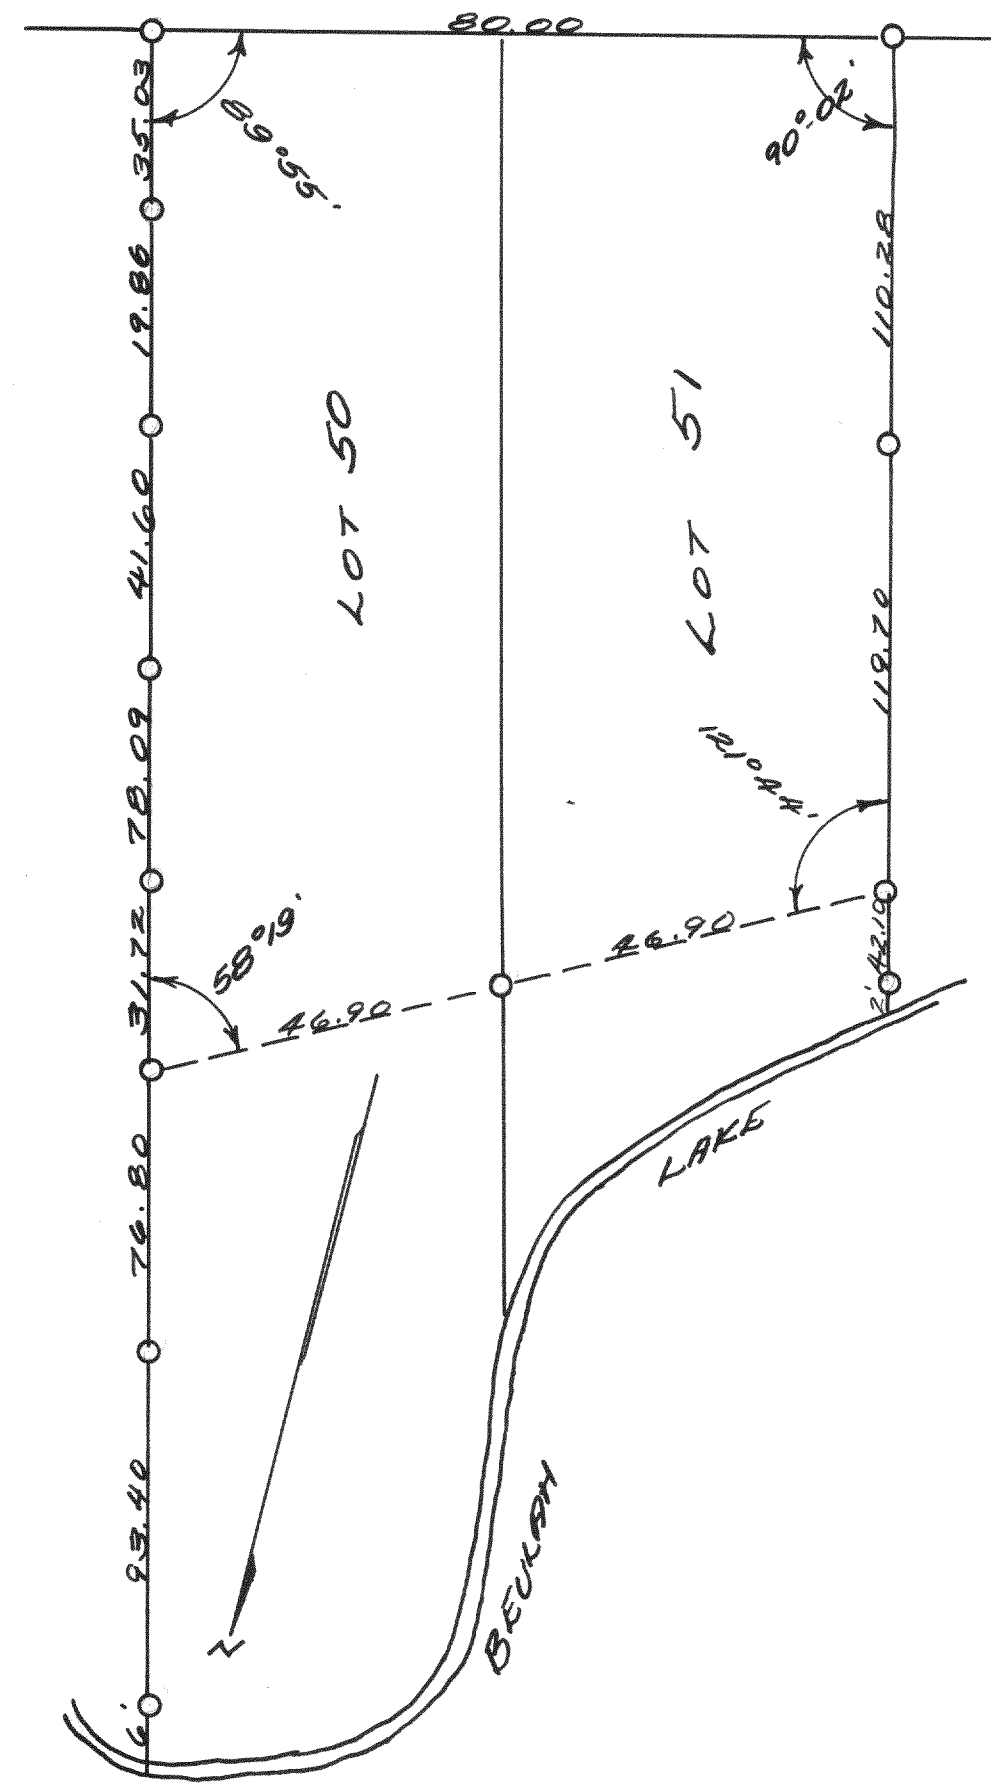

PLAT OF SURVEY OF LOTS 50
& 51 OF WILMER GROVE
BEACH
AUGUST 1940

Lloyd L. Jensen
S.E.J.

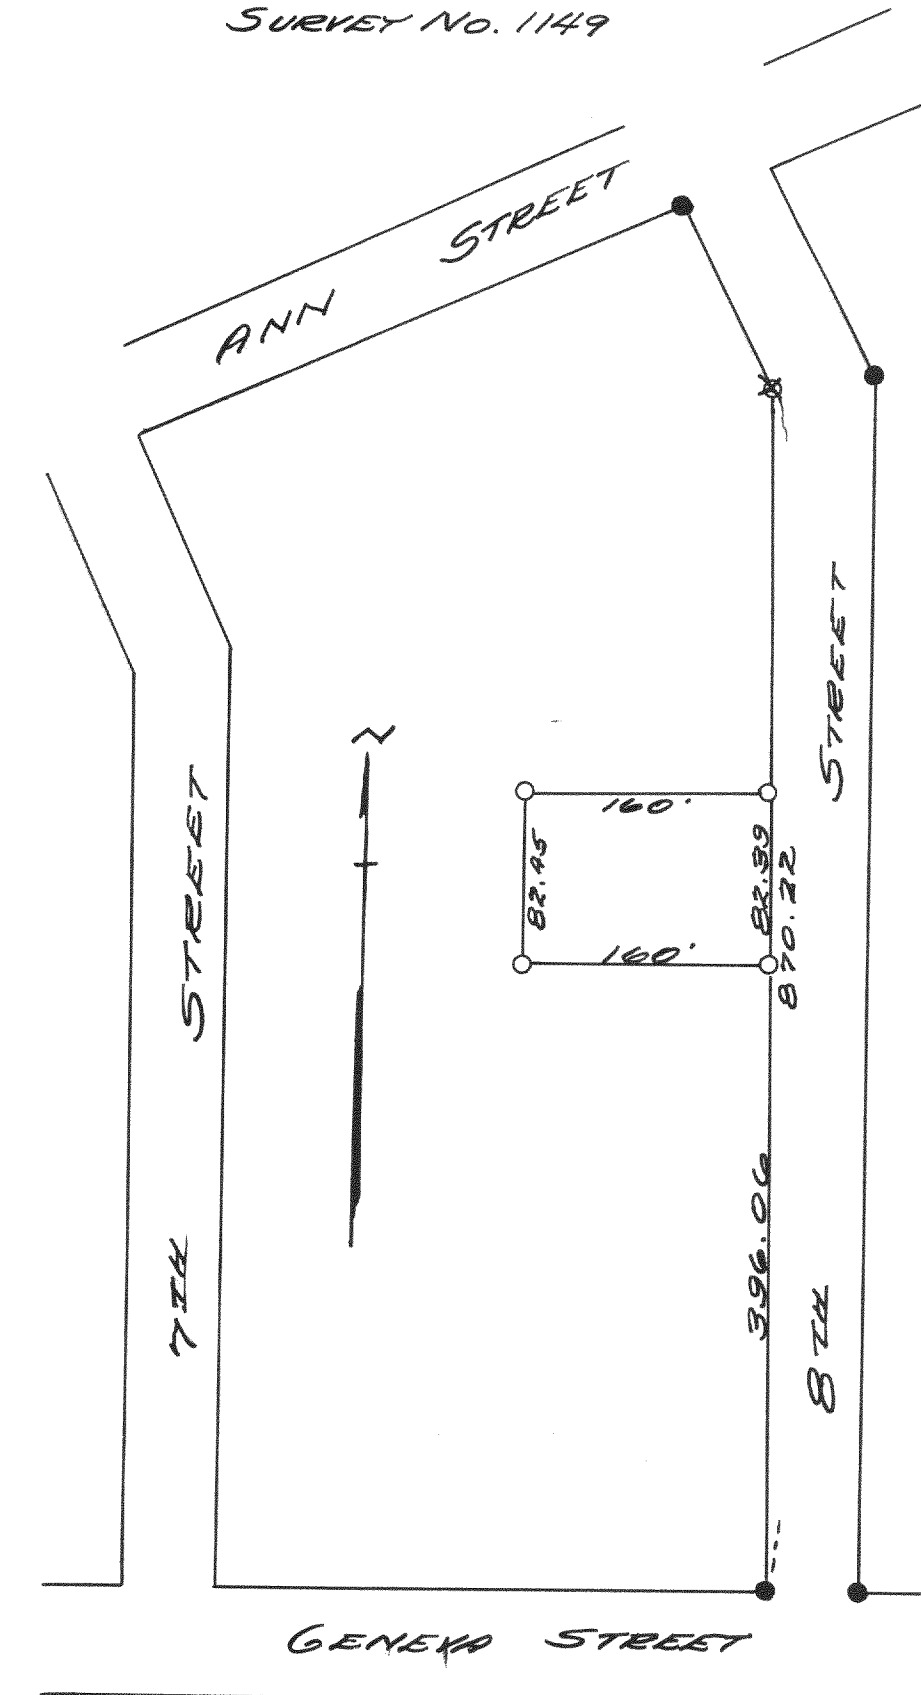

THE EAST 160'
PLAT OF SURVEY OF LOT 26
AND THE NORTH 1/4 OF LOT 27 OF
BLOCK 13 OF PASSAGE ARAM
DOWNIES ADDITION TO THE
CITY OF DELAVAN.
JULY 1940

Lloyd L. Jensen
S.E.J.