



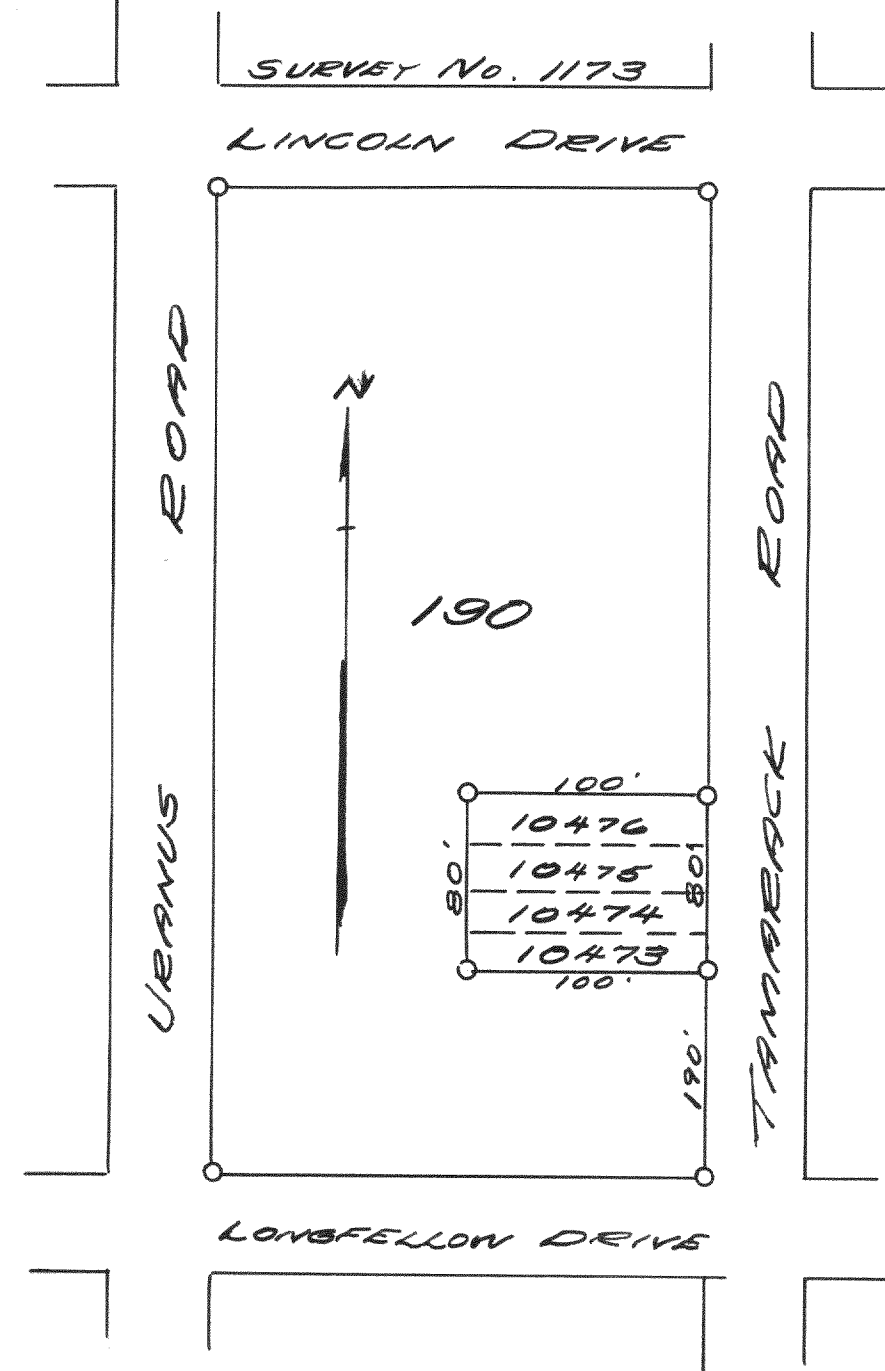

PLAT OF SURVEY OF LOTS 10473
TO 10476 OF LAKE COMO BEACH
SUBDIVISION
JULY 16, 1940

Lloyd L. Jensen
N.E.J.

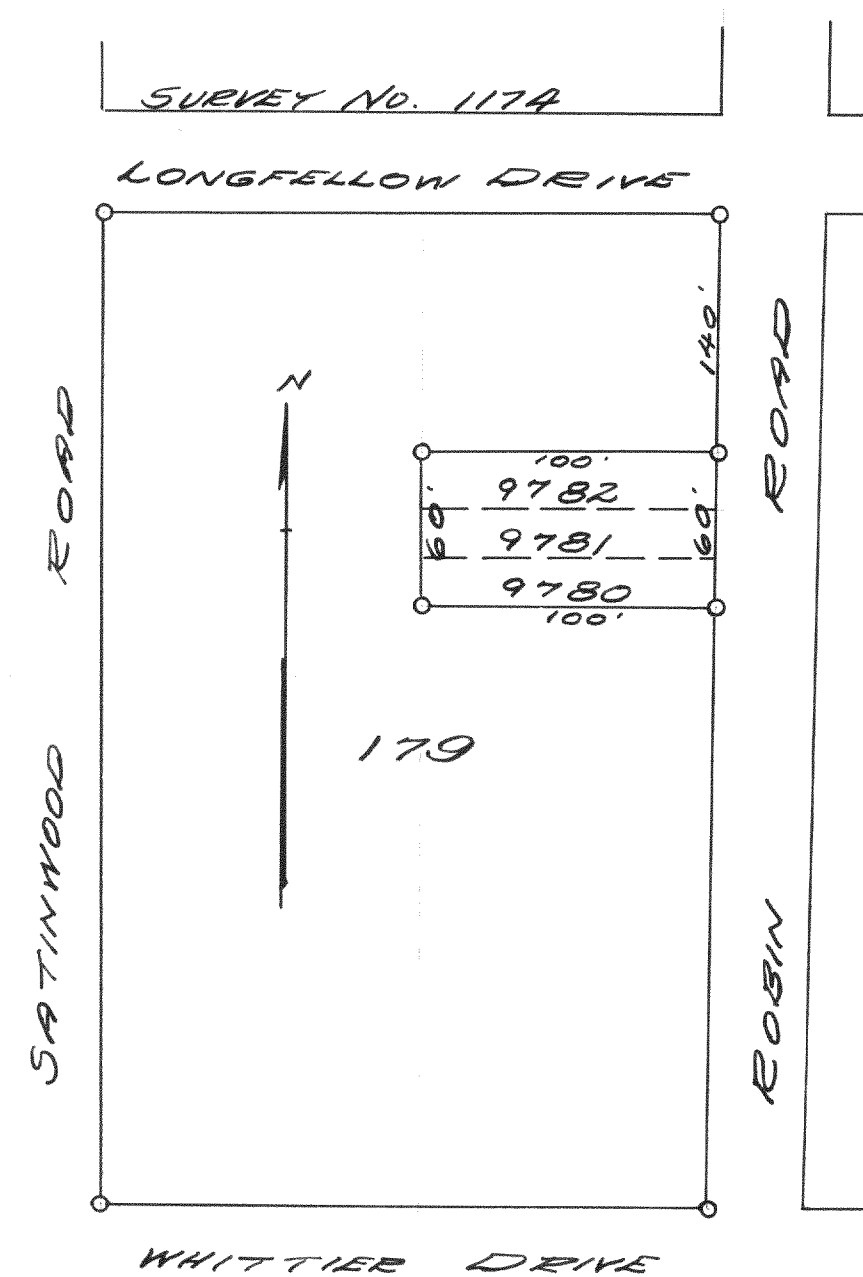

PLAT OF SURVEY OF LOTS
9780 TO 9782 OF LAKE COMO
BEACH SUBDIVISION

JULY, 1940


Lloyd L. Jensen
N.E.J.



PLAT OF SURVEY OF LOTS
6160 TO 6164 OF LAKE COMO
BEACH SUBDIVISION


JULY, 1940

Lloyd L. Jensen
N.E.J.

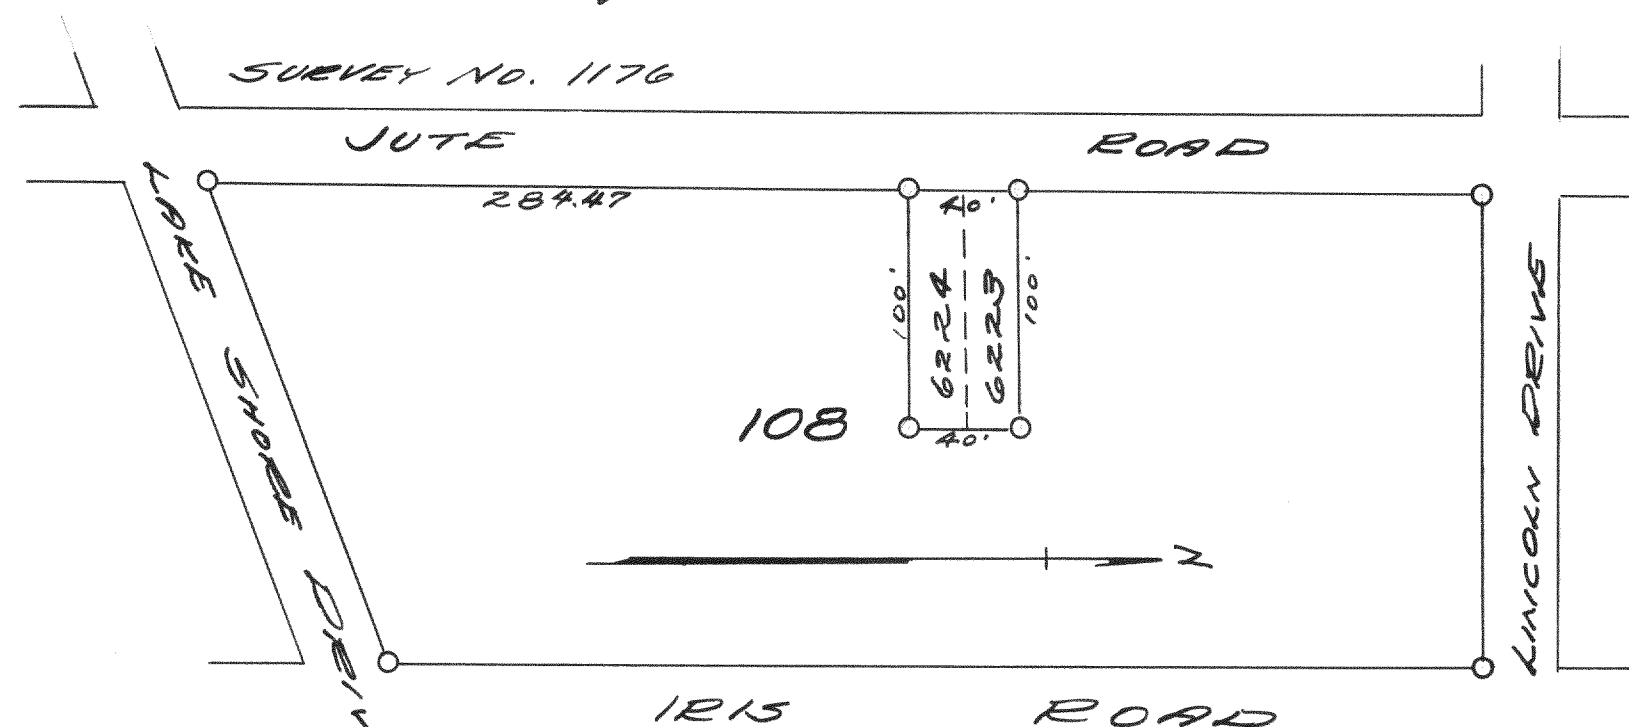

PLAT OF SURVEY OF LOTS 6223 & 6224
OF LAKE COMO BEACH SUBDIVISION
1940

Lloyd L. Jensen
N.E.J.

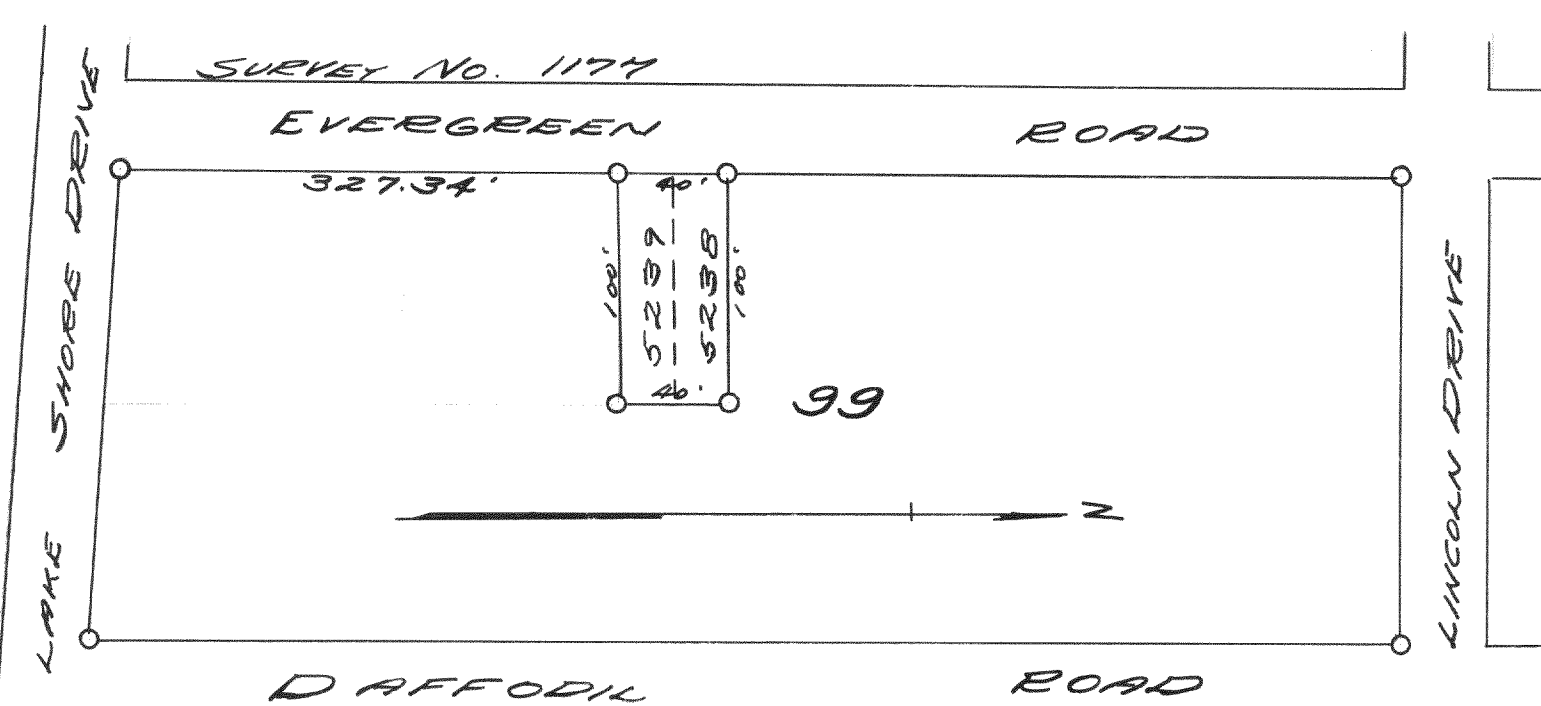

PLAT OF SURVEY OF LOTS 5238 & 5239 OF
LAKE COMO BEACH SUBDIVISION
1940

Lloyd L. Jensen
N.E.J.