



SURVEY NO. 1179

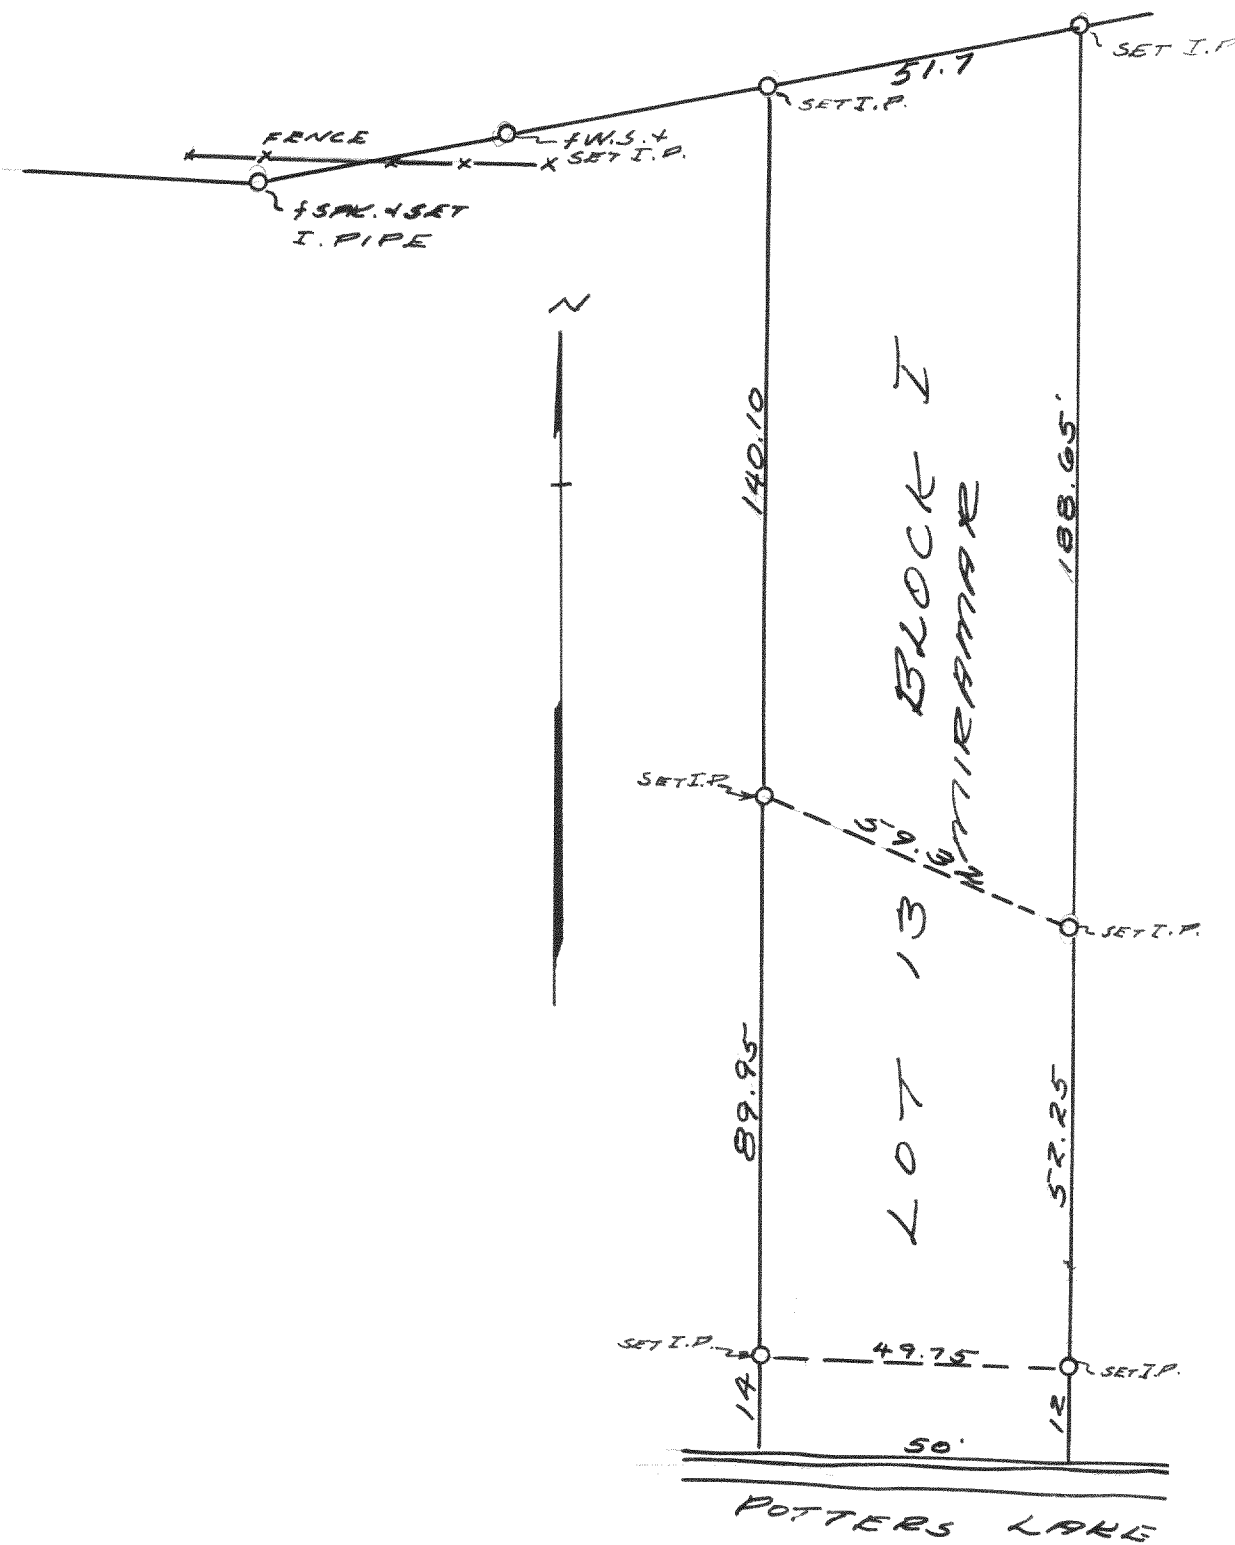

PLAT OF SURVEY OF MIRAMAR
LOT 13, BLOCK ONE
FEB. 1941

Lloyd L. Jensen
S.E.S.

SURVEY NO. 1180

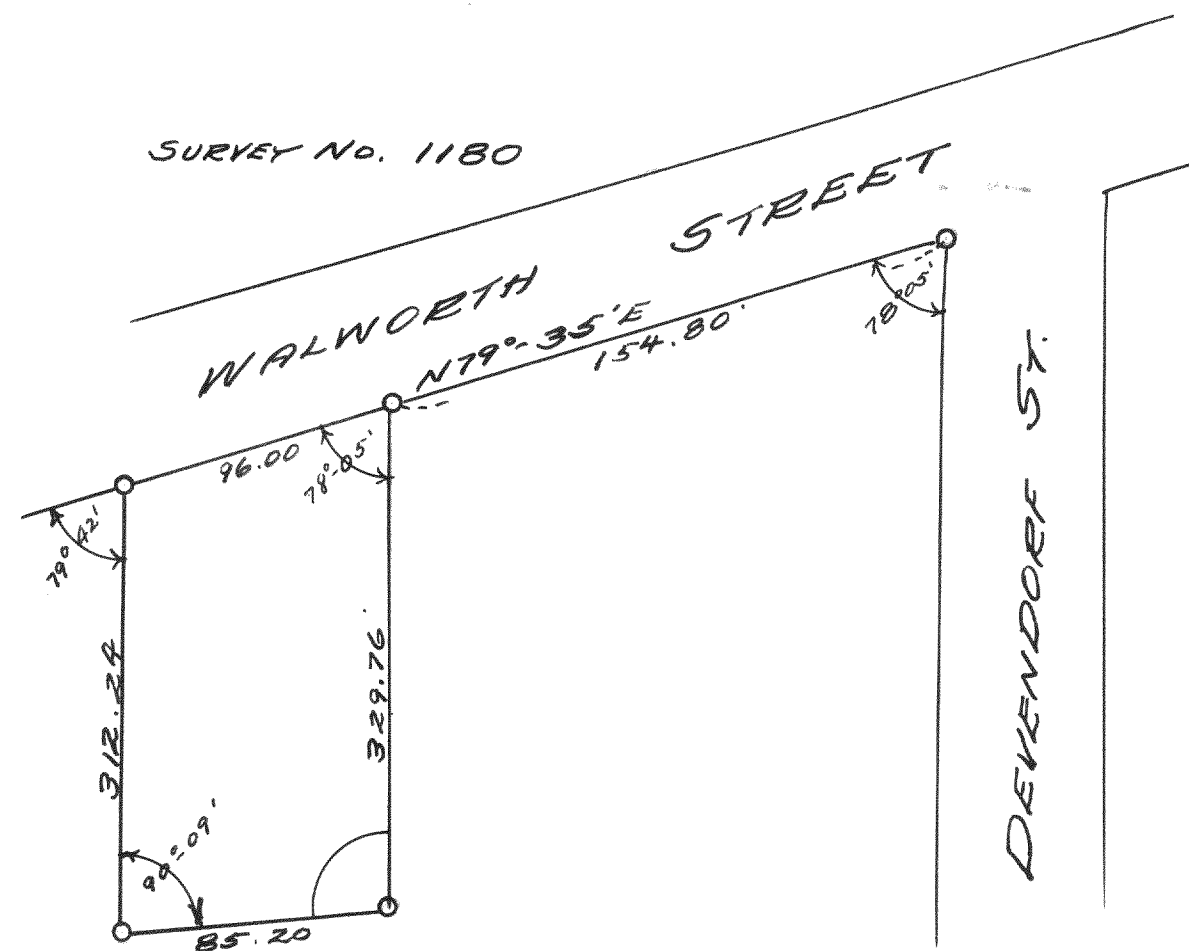

PLAT OF SURVEY OF LAND IN THE
SW 1/4 OF SECTION 36 T3N R16E,
IN THE CITY OF ELKHORN, WALWORTH
COUNTY, WISCONSIN
SEPT., 1940

Lloyd L. Jensen
S.E.S.