

Record of Survey.

DESCRIPTION

OF SECTION, QUARTER SECTION AND QUARTER QUARTER SECTION CORNERS

No. 116

4-4-15


Township....., North of Range..... of 4 Principal Meridian
as presented by the courses and distances on the following plat, and annexed field-notes of survey:
Established the center of the section at the point of intersection of STRAIGHT quarter lines.
Established all quarter-quarter corners upon the section boundary at proportional distances between known section and quarter section corners, according to the original field-notes of the Government survey.
Established all lost corners at proportionate distances between known corners, according to the original field notes of the Government survey.

Description of said piece

Lot 4 in Block no I of original plat.

All of that certain piece or parcel of land lying and being in the City of Whitewater, Walworth County, Wisconsin, and being also a part of Lot no. 4 in Block no. I of the recorded plat of the resurvey of the village (now City) of Whitewater, said plat being on record in the Register of Deeds office in and for the said Walworth County in Vol. 3 of plats on pages 46 & 47 and more fully described as follows to wit:

Beginning at an iron stake on the east line of the said lot no. 4 129.4 feet north of the northeast corner thereof; Thence north on said east line to the northeast corner of the said lot no. 4; Thence west on the north line of said lot 4 to the northwest corner thereof; Thence south on the West line of said lot to a pt. 129.4 feet north of the SW. corner of said lot; Thence easterly on a line parallel with the South line of said lot no. 4 to the place of beginning.

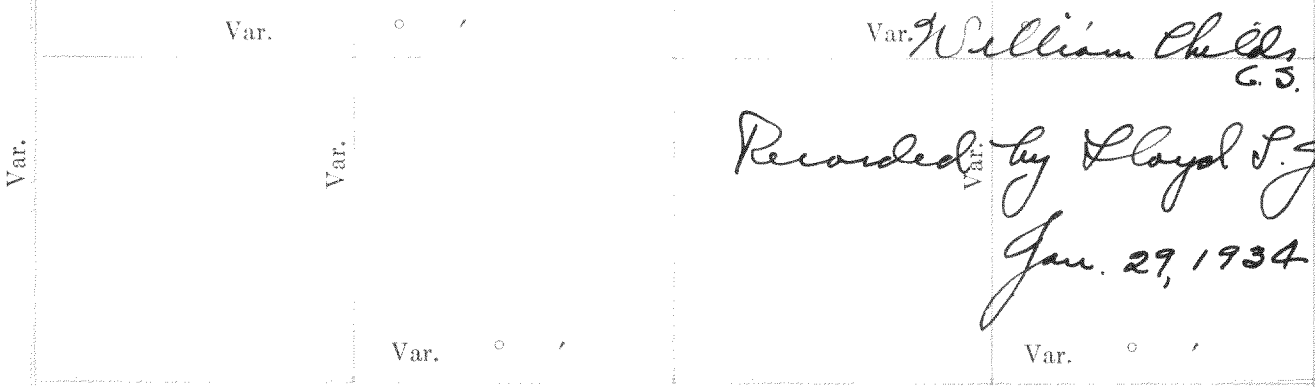

Recorded by Lloyd S. Jensen C.S.
Jan. 29, 1934

Plat of Section....., Township..... North, Range..... of 4 Principal Meridian Scale
80 chains to 6 inches. The figures in red ink are the lengths of the lines as stated in the field-notes of the Government survey.
Declination of the Magnetic Meridian from the True Meridian.....
Surveyed and sub-divided..... A. D. 1....., in accordance
with the State Laws and Instructions of the Commissioner of the General Land office, and recorded on pages..... of Register in the County Clerk's office.
Witness my hand this..... day of..... A. D. 1.....
..... SURVEYOR.

GOVERNMENT CORNERS				H. C. MILLER CO., MFG. STATIONERS, MILWAUKEE WISCONSIN				
No.	Bearing	In. Dia.	Courses they bear	Links Distant	Bearing	In. Dia.	Courses they bear	Links Distant
1.	N. W. Sec. Cor. identified,							
2.	N. E. Sec. Cor. identified,							
3.	S. E. Sec. Cor. identified,							
4.	S. W. Sec. Cor. identified,							
5.	N. 1/4 Sec. Cor. identified,							
6.	E. 1/4 Sec. Cor. identified,							
7.	S. 1/4 Sec. Cor. identified,							
8.	W. 1/4 Sec. Cor. identified,							
Subdivision Corners								
1.	Center 1/4 Sec. of							
2.	North 1/4-1/4 S. N. E. cor.							
3.	East 1/4-1/4 S. N. E. cor.							
4.	South 1/4-1/4 S. N. E. cor.							
5.	West 1/4-1/4 S. N. E. cor.							
6.	Center 1/4-1/4 S. N. E. cor.							
7.	North 1/4-1/4 S. N. E. cor.							
8.	East 1/4-1/4 S. N. E. cor.							
9.	South 1/4-1/4 S. N. E. cor.							
10.	Center 1/4-1/4 S. N. E. cor.							
11.	East 1/4-1/4 S. N. E. cor.							
12.	South 1/4-1/4 S. N. E. cor.							
13.	West 1/4-1/4 S. N. E. cor.							
14.	Center 1/4-1/4 S. N. E. cor.							
15.	South 1/4-1/4 S. N. E. cor.							
16.	West 1/4-1/4 S. N. E. cor.							
17.	Center 1/4-1/4 S. N. E. cor.							

No. 117 Description of South piece.

1. N. W. Sec. Cor. identified, All of that certain piece or parcel of land lying and being in the City of Whitewater, Walworth Co., Wis., & also being a part of lot 4 in Blk I of the plat of the resurvey of the City of Whitewater, beginning at an iron stake on the East line of said lot 4, 66 1/2 ft. of the S.E. cor. of said lot. Said iron stake being the Southeast corner of that certain parcel of land conveyed by George & Stella Rosman to J. C. & Mary C. Chamberline. The deed of which conveyance is on record in the above mentioned Register of Deeds office in Vol. 113 Page 471 of Deeds, & being also the N.E. corner of that certain parcel of land known in the above mentioned deed of Rosman to Chamberline as the Clapp & Lewy Stable and also the N.E. corner of that certain parcel of land conveyed by Jason Fryer & Mary C. Chamberline to J. C. Chamberline & John S. Lewy. The deed for the last mentioned conveyance is on record in the Register of Deeds office in Vol. 113 of Deeds page 378, and subsequently conveyed to Cummings & Hickey, the deed of which conveyance is on record in the said register of Deeds office in Vol. 163 of Deeds on page 366; Thence N. on E. line of said lot 4, 63.4 feet to an iron stake; Thence West on a line parallel with and to the N. line of the above mentioned Cummings & Hickey lot to the W. line of said lot no. 4, a part of the S.W. corner of said lot 4; Thence S. on the W. line 63.4 feet to a pt., said pt. being on the North side of the wall of the building now standing on the said Cummings & Hickey lot; and being also on the S. line of the above described land in deed of conveyance from Rosman to Chamberline; Thence East on the said line to the place of beginning.

NAMES OF SWORN ASSISTANTS

No 117 Description of South piece.
All of that certain piece or parcel of land lying and being in the City of Whitewater, Walworth Co., Wis. & also being a part of lot 4 in Blk I of the plat of the resurvey of the City of Whitewater, Beginning at an iron stake on the East line of said lot 4, 66' N. of the S.E. cor. of said lot. Said iron stake being the Southeast corner of that certain parcel of land conveyed by Deed of J. & Stella Rorman to J. C. & Mary C. Chamberline. The deed of which conveyance is on record in the above mentioned Register of Deeds office in Vol. 113 Page 471 of Deeds, & being also the N.E. corner of that certain parcel of land known in the above mentioned deed of Rorman to Chamberline as the Clapp Farming Stable and also the N.E. corner of that certain parcel of land conveyed by Jason Fryer & Mary C. Chamberline & J. C. Chamberline to Elba S. Sluvey. The deed for the last mentioned conveyance is on record in the Register of Deeds office in Vol. 113 of Deeds page 378, and subsequently conveyed to Cummings & Hickey, the deed of which conveyance is on record in the said register of Deeds office in Vol. 163 of Deeds on page 366; Thence N. on the E. line of said lot 4, 63.4 feet to an iron stake; Thence West on a line parallel with and the N. line of the above mentioned Cummings & Hickey lot to the W. line of said lot no. 4, a pt. 66' N. of the SW. corner of said lot 4; Thence S. on the W. line 63.4 feet to a pt, said pt. being on the north side of the wall of the building now standing on the said Cummings & Hickey lot; and being also on the S. line of the above described land in deed of conveyance from Rorman to Chamberlain; Thence easterly on the said line to the place of beginning.

CHAINMEN
FLAGMEN
AXMEN
Recorded by Lloyd S. Jensen C.S.
Jan. 29, 1934

No. 118

Block 4 of Berges Addition to City of Whitewater

This is to certify that I William Childs, County Surveyor of Walworth County Wisconsin have this day completed a survey of part of block 4 of Berges Addition To the Village, now City of Whitewater. Which survey is as follows: At the northeast corner of said block 4 found remains of old post and drove iron stake in place

At the northeast of Block 3 found stake set by former survey and from this survey stake ran South over iron stake at northeast corner of Block 4 to southeast corner. At southeast corner found remains of old post and drove stake being in line with stakes at northeast corner of blk. 3 and 4. From this last stake measured west 397.7 feet and find post hole in line fence north. Drove small stake in this post hole and from this stake measure west 198.8 feet to line of fence running North and 395.7 ft. and find post hole & stake for corner of blk. Making the South side of said blk. 793.4 ft. From the northeast corner of said blk 4 west 315 feet and find post hole in line of fence running South. The line of this fence I believe to be the center of said blk. At the Southwest corner of blk 3 I find stake and stone set by former survey and 60 ft. South of this stake I find post hole which I believe to be the north line of blk, and from this point on line to northeast corner of blk. set good oak stake at 395 feet West of N.E. cor. for the N.W. cor. of lot 3 said blk. From this Oak stake measured East and set limestone at 82.8, 165.6 & 248.4 leaving 146.6 for last lot. Found East side of blk to be 513.6. Found point 256.8 to be on South side of ditch and in line of fence running West. Found West line of blk. to be 522 feet. Found point 261 feet to be in line of fence East. Also found that line from this point to point in center of East line would hit fence post which fence post is in line of fence running North and South. I have already taken as being the center line North and South through said blk. Making said fence post the true center of blk. From this center measured East 396 feet to East line of blk. Began at center and measured East 83.04 ft. and set stake, 166.08 and set fence post. The center of said fence post being the North and South line and 249.12 and made point leaving 146.9 for last lot. From this last mentioned point North to point on North side of blk. 146.6 feet West of N.E. corner drove stake at 99 feet North, for Southwest corner of Buering piece. Also from point in center of east line of blk. North 99 feet and set stake for southeast corner of Buering piece. A line from last mentioned stake west to stake set for Southwest corner of Buering piece strikes old fence post and fence post at Southwest corner of Buering piece as fenced True Southwest corner being 1 foot west of corner post.

William Childs
C.S.

Recorded by Lloyd S. Jensen
C.S.
Jan. 29, 1934