

Record of Survey.


no 142

Township....., North of Range.....of 4 Principal Meridian
as presented by the courses and distances on the following plat, and annexed field-notes of survey:

Established the center of the section at the point of intersection of STRAIGHT quarter lines.

Established all quarter-quarter corners upon the section boundary at proportional distances between known section and quarter section corners, according to the original field-notes of the Government survey.

Established all lost corners at proportionate distances between known corners, according to the original field notes of the Government survey.

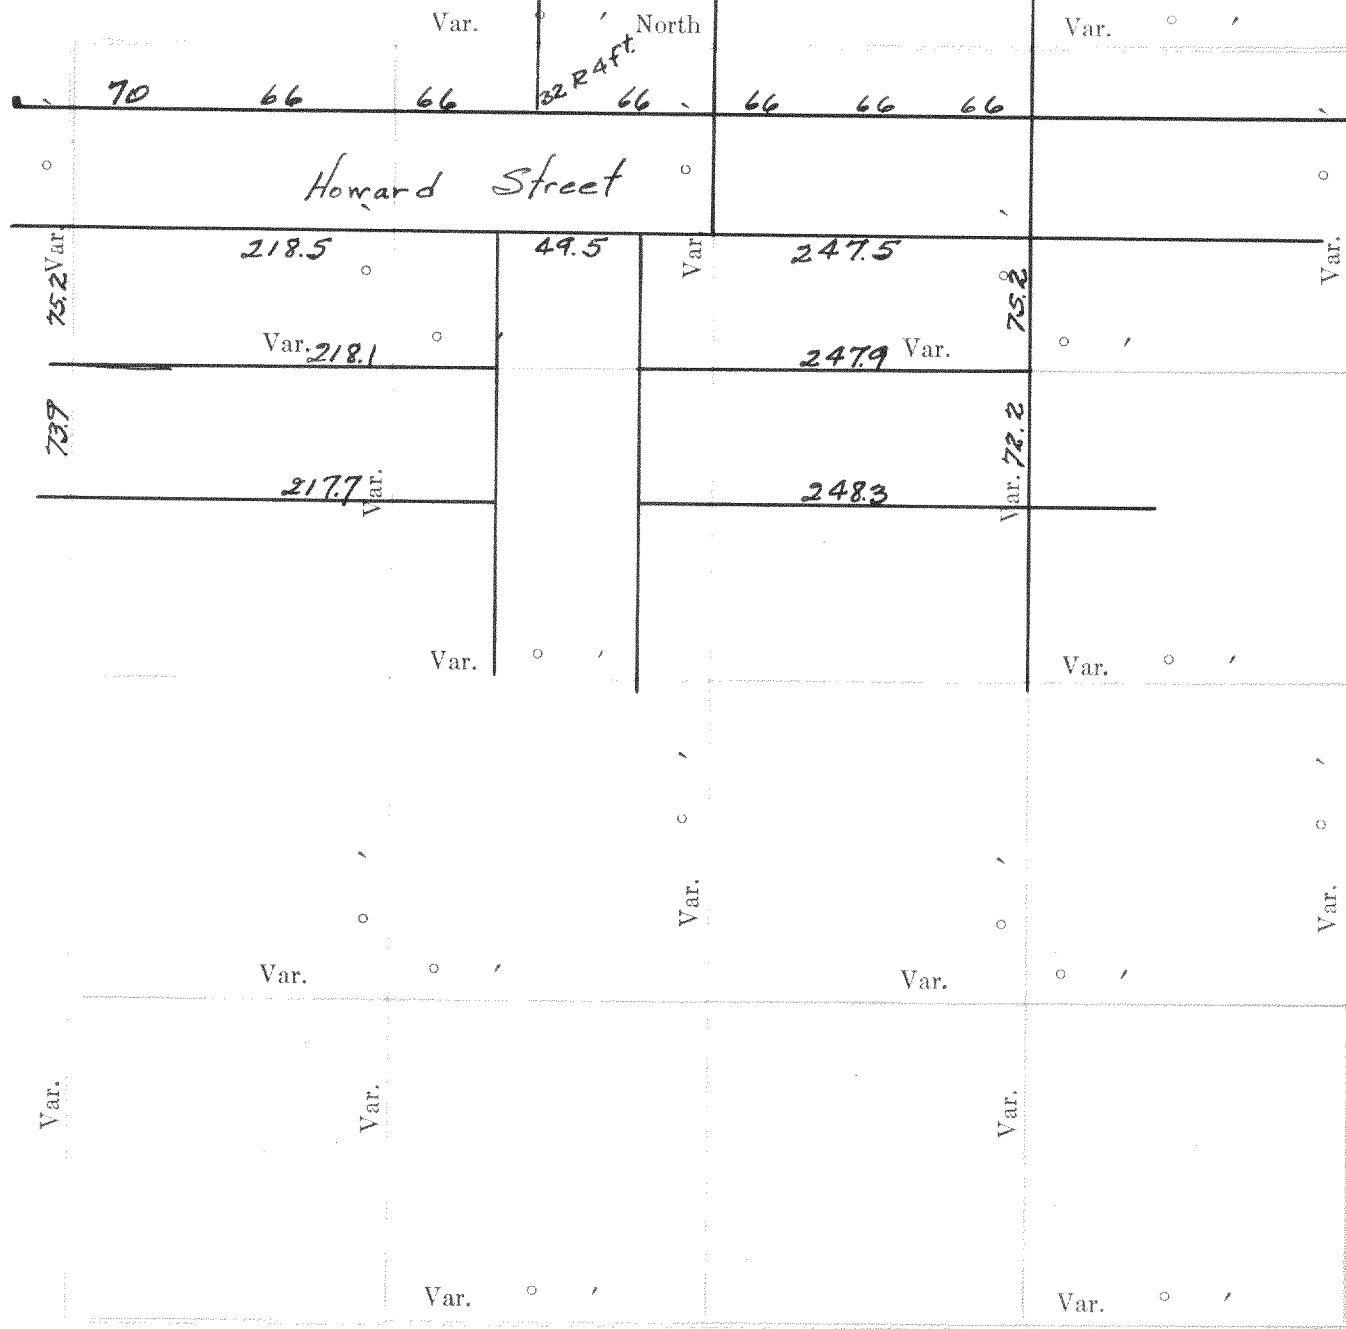

Plat of Section....., Township.....North, Range.....of 4 Principal Meridian Scale
80 chains to 6 inches. The figures in red ink are the lengths of the lines as stated in the field-notes of the
Government survey.

Declination of the Magnetic Meridian from the True Meridian.....

Surveyed and sub-divided.....A. D. 1....., in accordance
with the State Laws and Instructions of the Commissioner of the General Land office, and recorded on pages
.....of Register in the County Clerk's office.

Witness my hand this.....day of.....A. D. 1.....

.....SURVEYOR.

DESCRIPTION

49

OF SECTION, QUARTER SECTION AND QUARTER QUARTER SECTION CORNERS

GOVERNMENT CORNERS				H. C. MILLER CO., MFG. STATIONERS, MILWAUKEE WISCONSIN								
No.	Bearing Trees	In. Dia.	Courses they bear	Links Distant	Bearing Trees	In. Dia.	Courses they bear	Links Distant	Bearing Trees	In. Dia.	Courses they bear	Links Distant
1.	N. W. Sec. Cor. identified,											
2.	N. E. Sec. Cor. identified,											
3.	S. E. Sec. Cor. identified,											
4.	S. W. Sec. Cor. identified,											
5.	N. 1/4 Sec. Cor. identified,											
6.	E. 1/4 Sec. Cor. identified,											
7.	S. 1/4 Sec. Cor. identified,											
8.	W. 1/4 Sec. Cor. identified,											
Subdivision Corners												
No.												
1.	Center 1/4 Sec. Cor.											
2.	North 1/4-1/4s N. W. qr.,											
3.	East 1/4-1/4s N. W. qr.,											
4.	South 1/4-1/4s N. W. qr.,											
5.	West 1/4-1/4s N. W. qr.,											
6.	Center 1/4-1/4s N. W. qr.,											
7.	North 1/4-1/4s N. E. qr.,											
8.	East 1/4-1/4s N. E. qr.,											
9.	South 1/4-1/4s N. E. qr.,											
10.	Center 1/4-1/4s N. E. qr.,											
11.	East 1/4-1/4s S. E. qr.,											
12.	South 1/4-1/4s S. E. qr.,											
13.	West 1/4-1/4s S. E. qr.,											
14.	Center 1/4-1/4s S. E. qr.,											
15.	South 1/4-1/4s S. W. qr.,											
16.	West 1/4-1/4s S. W. qr.,											
17.	Center 1/4-1/4s S. W. qr.											

A. H. Hitchcock - Walworth

Found stake (auger bit) at NE corner of Blk being 195 feet East of line 20 R. east of gr. line also an iron stake (auger bit) 49.5 feet E. This is South line of 20 foot strip and measure E. on this line 50 & set iron pipe. South from corner on a line parallel to a line, that is from first stake mentioned to pt. 4 E of iron stake at NE corner of Blk. South 89 ft. and drove iron stake. East 50 feet iron stake & 89 ft. lot goes 20 feet N. of N. stakes & S rail of track is 8 feet more.

Surveyed by William Child
CS
June 20, 1912

Recorded by Lloyd S. Jensen
CS
Feb. 1, 1934

A. H. Hitchcock - Walworth
Found stake (auger bit) at NE corner of Blk
being 195 feet East of line 20 R. east of gr. line
also an iron stake (auger bit) 49.5 feet E.
This is south line of 20 foot strip and measured
E. on this line 50 ft set iron pipe. South from
corner on a line parallel to a line, that is from
first stake mentioned to pt. 4 E of iron stakes
at NE corner of Blk. South 89 ft. and
drew iron stake. East 50 feet iron stake 189,
lot goes 20 feet N. of N. stakes & S. rail of
track is 8 feet more.


Surveyed by William Child
CS.
June 20, 1912
Recorded by Lloyd S. Jensen
CS.
Feb. 1, 1934

NAMES OF SWORN ASSISTANTS

CHAINMEN

FLAGMEN

AXMEN

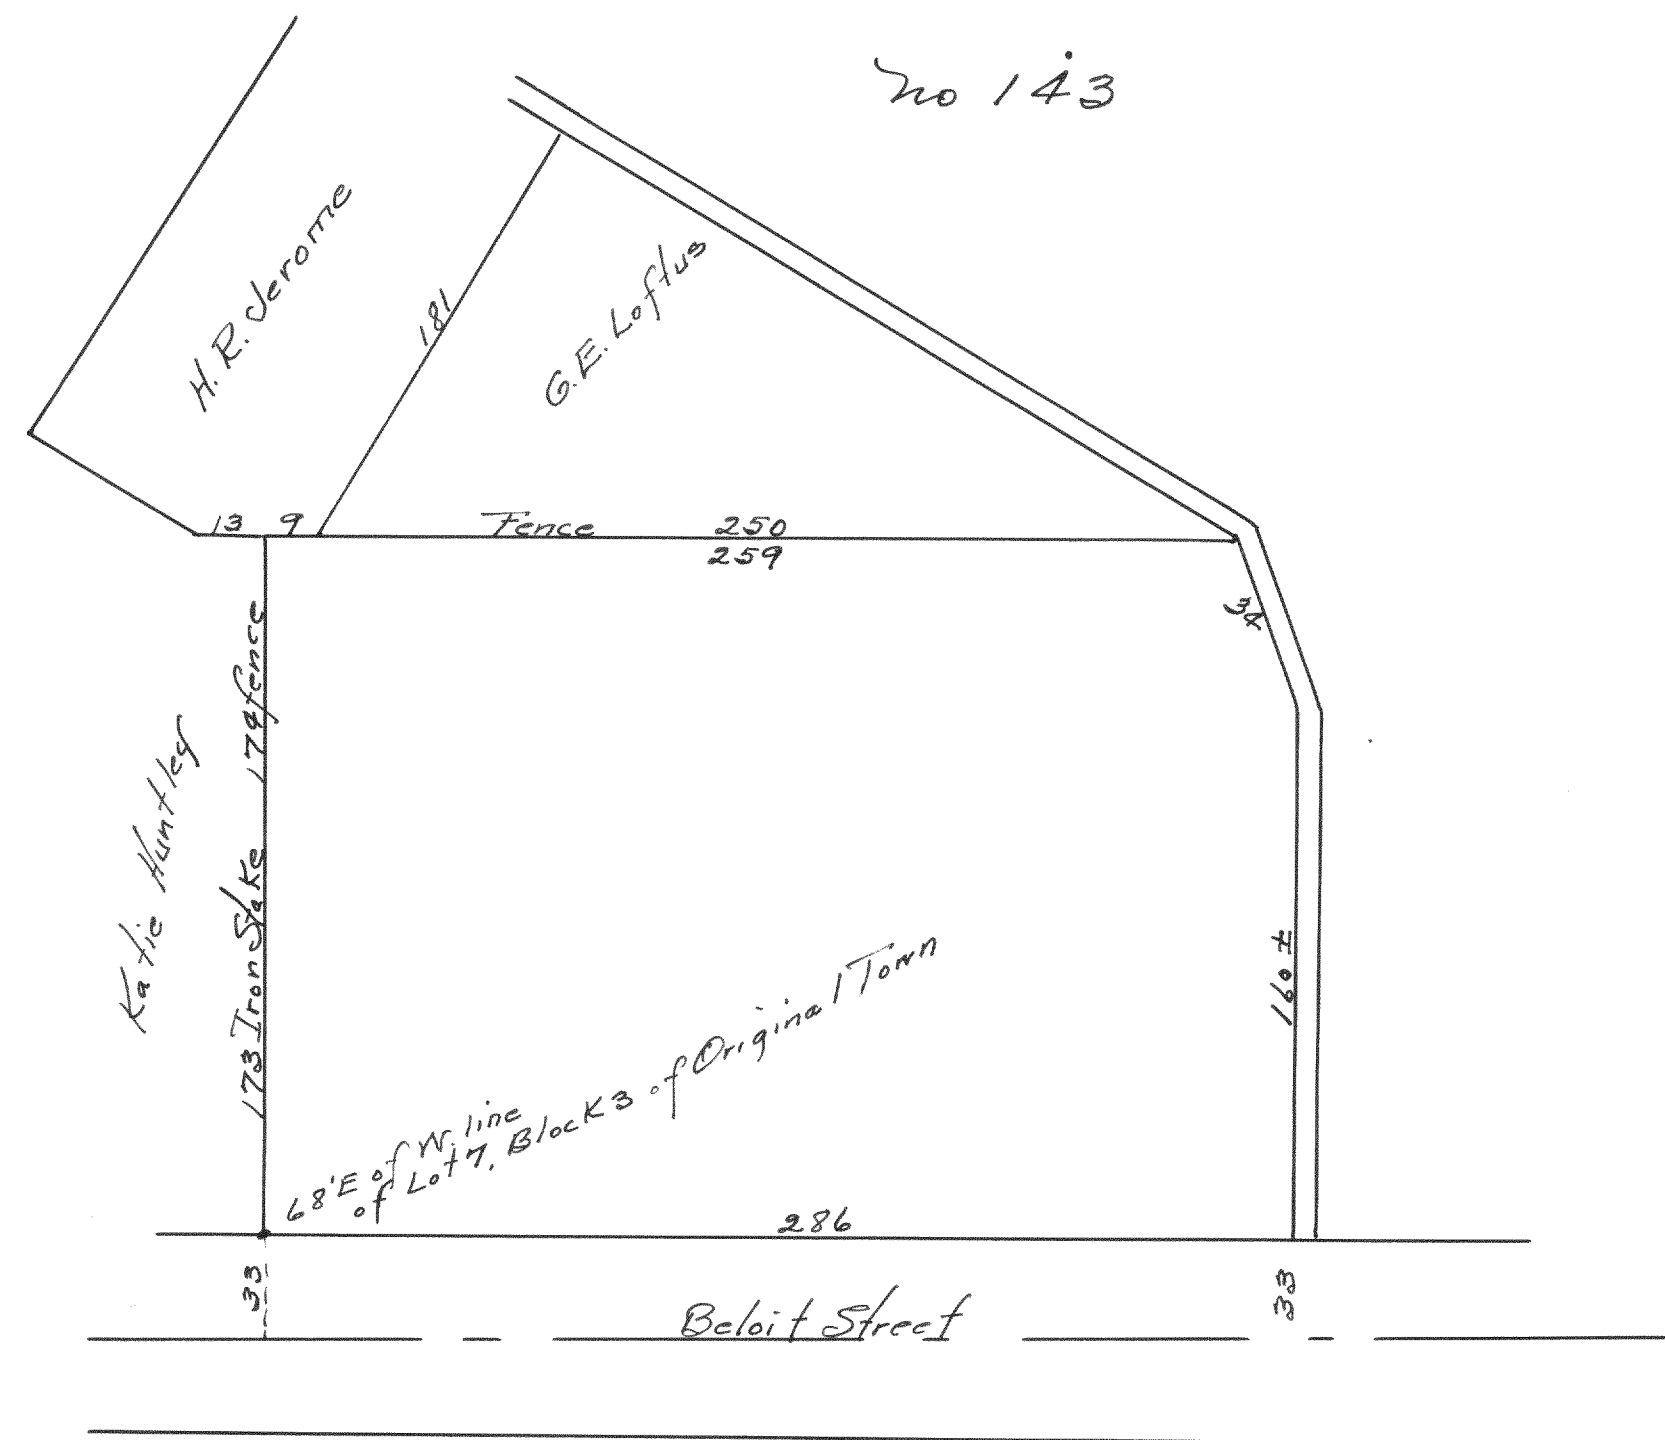

All that certain piece or parcel of land lying and being in Blk No 3 of The Village of Walworth according to the Recorded Plat thereof and which plat is on record in the Register of Deeds Office in and for Walworth County, Wisconsin in Volume 3 of Plats on Page 39 and said Plat being also a part of the NE $\frac{1}{4}$ of 21-1-16 being The Town of Walworth, Walworth Co. Wis. described as follows to wit:— Beginning at an iron stake on the north line of Beloit Street and which iron stake is 68 feet East of the West line of Lot No 7 in the said Blk 3, and being also on the East line of the lot owned and occupied by Mrs. Katie Huntley 3rd; Thence north being along the East line of the said 3rd property 173' to an iron stake in line of one certain fence which fence is the South line of the land owned and occupied by H. R. Jerome, Thence East being along the E. line of the Jerome lot and also the south line of the lot owned & occupied by J. C. Loftus 259' $\pm$ to the Southwesterly line of Madison Street in the said recorded plat; Thence Southeastly being along the Southwesterly line of the said Madison St. 34' $\pm$ to the westerly line of the Cementwalk; Thence S being along the W. line of said walk 160' $\pm$ to the N. line of the said Beloit Street and continuing on the same course 33' to the center of the said street, being the $\frac{1}{4}$ section line; Thence West being along the said line 285' $\pm$ to a point in line with the East line of the said 3rd lot; Thence North 33' to the place of beginning.

Surveyed by William Child
 Recorded by Lloyd J. Jensen
 Feb. 1, 1934