


Record of Survey.

no. 11
Township 37, North of Range 17 East of 4 Principal Meridian
as presented by the courses and distances on the following plat, and annexed field-notes of survey:

Established the center of the section at the point of intersection of STRAIGHT quarter lines.

Established all quarter-quarter corners upon the section boundary at proportional distances between known section and quarter section corners, according to the original field-notes of the Government survey.

Established all lost corners at proportionate distances between known corners, according to the original field notes of the Government survey.

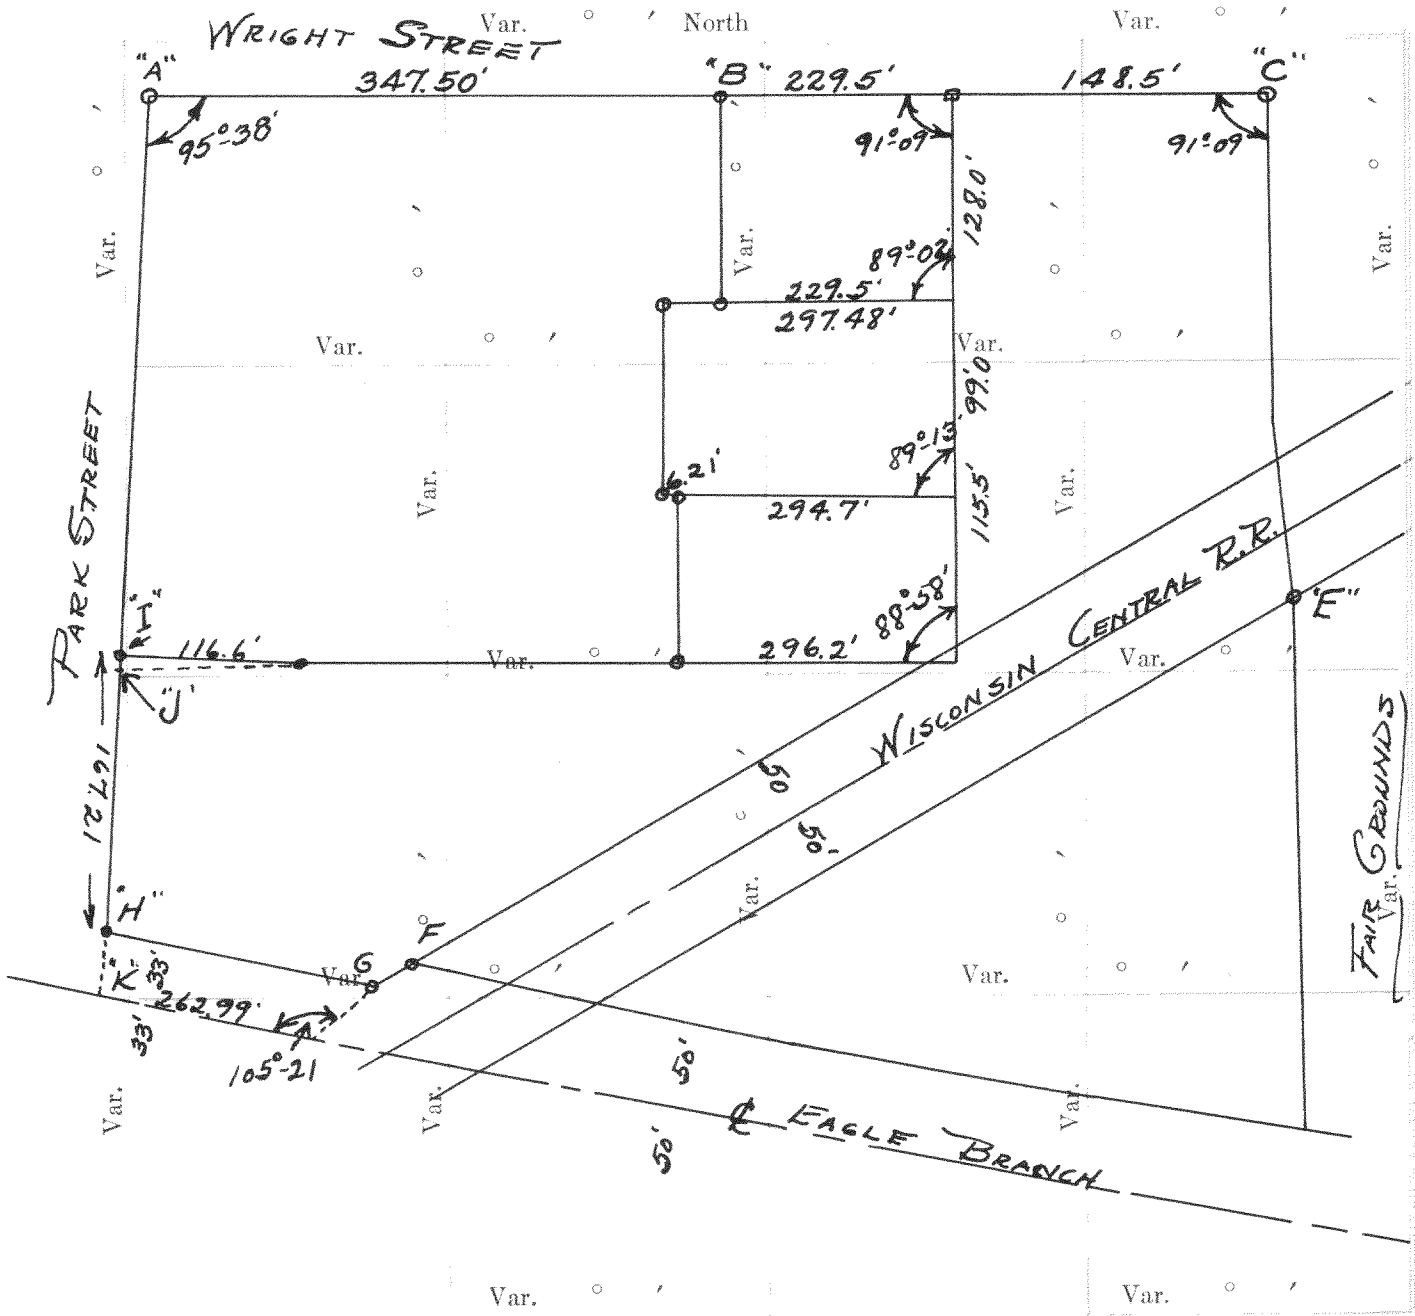

Plat of Section 31, Township 3 North, Range 17E of 4 Principal Meridian Scale
80 chains to 6 inches. The figures in red ink are the lengths of the lines as stated in the field-notes of the
Government survey.

Declination of the Magnetic Meridian from the True Meridian.....

Surveyed and sub-divided..... A. D. 1, in accordance
with the State Laws and Instructions of the Commissioner of the General Land office, and recorded on pages
..... of Register in the County Clerk's office.

Witness my hand this 20 day of Feb. 1933 A. D. 1

Lloyd L. Jensen County Surveyor.
Surveyed Sept 4 Oct, 1932.

DESCRIPTION

OF SECTION, QUARTER SECTION AND QUARTER QUARTER SECTION CORNERS

H. C. MILLER CO. MFG. STATIONERS, MILWAUKEE WISCONSIN															
GOVERNMENT CORNERS				Bearing	In.	Courses	Links	Bearing	In.	Courses	Links	Bearing	In.	Courses	Links
				Trees	Dia.	they bear	Distant	Trees	Dia.	they bear	Distant	Trees	Dia.	they bear	Distant
No.															
1. N. W. Sec. Cor. identified,															
2. N. E. Sec. Cor. identified,															
3. S. E. Sec. Cor. identified,															
4. S. W. Sec. Cor. identified,															
5. N. 1/4 Sec. Cor. identified,															
6. E. 1/4 Sec. Cor. identified,															
7. S. 1/4 Sec. Cor. identified,															
8. W. 1/4 Sec. Cor. identified,															
Subdivision Corners															
No.															
1. Center 1/4 Sec. Cor.															
2. North 1/4-1/4s N. W. qr.,															
3. East 1/4-1/4s N. W. qr.,															
4. South 1/4-1/4s N. W. qr.,															
5. West 1/4-1/4s N. W. qr.,															
6. Center 1/4-1/4s N. W. qr.,															
7. North 1/4-1/4s N. E. qr.,															
8. East 1/4-1/4s N. E. qr.,															
9. South 1/4-1/4s N. E. qr.,															
10. Center 1/4-1/4s N. E. qr.,															
11. East 1/4-1/4s S. E. qr.,															
12. South 1/4-1/4s S. E. qr.,															
13. West 1/4-1/4s S. E. qr.,															
14. Center 1/4-1/4s S. E. qr.,															
15. South 1/4-1/4s S. W. qr.,															
16. West 1/4-1/4s S. W. qr.,															
17. Center 1/4-1/4s S. W. qr.															

NAMES OF SWORN ASSISTANTS

CHAINMEN

FLAGMEN

AXMEN

No. 11. Survey of lots and other land for John H. Harris.
 Location S. W. $\frac{1}{4}$ sec 31, T3N, R17E. being lots 1 & 2
 5- blk 7, lots 10, 11, 12, 5 & 4, lots 9, 4, 6, & 7- blk 5
 all of Arnold's Add to the city of Elkhorn, and
 land N.E. of these lots and South of the fair
 grounds.

Monuments - Could not locate any.


Procedure - Found the block corner at the
 intersection of Wright & Park Streets by measuring
 from the curb as directed by the city Engineer. Also
 used the fair grounds fence on Wright Street for the
 street line as directed by above mentioned party.

Obtained Park street line by measuring from curbs.



Found that the lot measurements on Park St. didn't
 check with plat so proportioned them according to
 recorded plat.

T. E. was obtained by finding the intersection of Court
 Street & the Wis. Central R.R. and then measuring that
 angle and determining the old lines of a triangular 2
 acres that was owned by Fryer. The south pt. of the
 triangle comes at E which is 7.2' N. of the fair grounds fence.
 The tree at this pt. has old wires in it & we found old post
 holes which showed the position of the old fence to be on
 this line & that no 7.5' fog in the fence existed as is now
 found in present fence.


The E. of the old Wis. Central road was located by using the
 lines of construction, there being no old pts. known. The location
 of the change in R.O.W. was obtained from the Milwaukee
 office of the C.M. & St. P. & P.R.R.

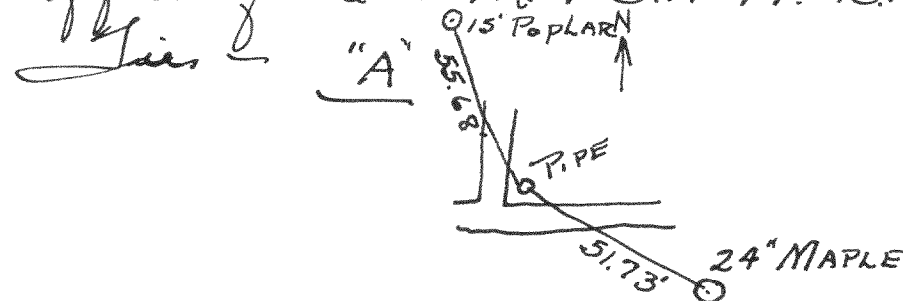

"J" - is a cross in the concrete drive. "C"

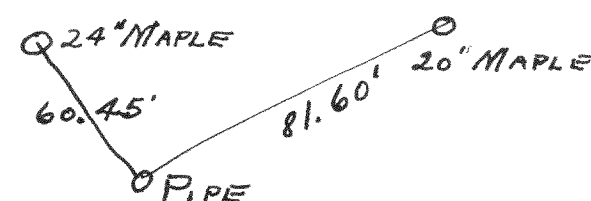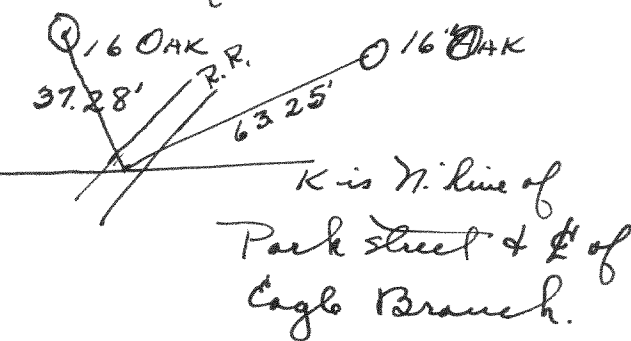

No. 12. Resurvey of lots 27-21 for Mrs. Jagers of Cedar Tr. Park.
 Location Lots, 28, 27, 26, Walk, 25, 24, 23, 22, 21 in 1st. Add to Cedar
 Tr. Park. Sec. 6, T1N, R17E.

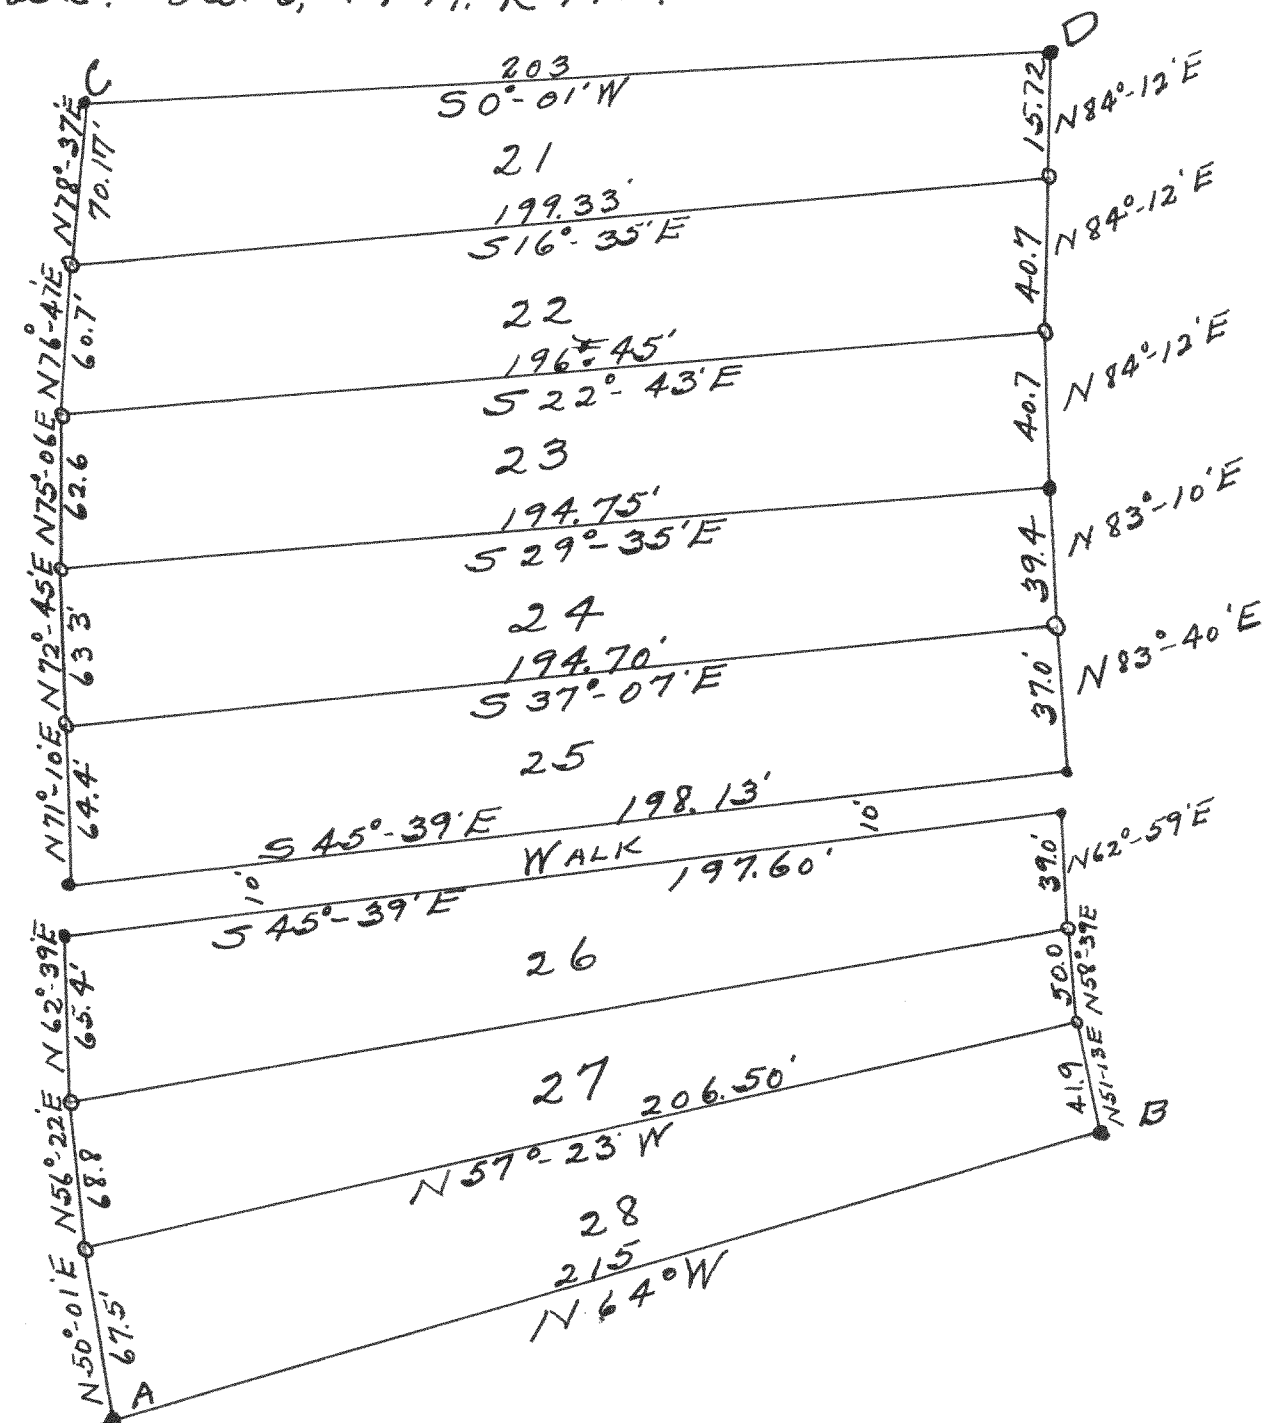

Monuments - found permanent concrete monuments at A, B,
 C & D and at ~~each~~ ^{both} ends of the walk.

Procedure - The monuments at A, B, C & D remained fixed
 and the other pts. were changed enough to obtain the
 end lengths as given in the original plat except
 lot 21 which took the error that existed in lot
 27.

- concrete monuments.
- iron pipes.

Surveyed Sept 19 & 20, 1932
 Recorded Feb 20, 1933
 Lloyd S. Jensen
 Co. Surveyor.