




no 149

# Block 7 East Lay

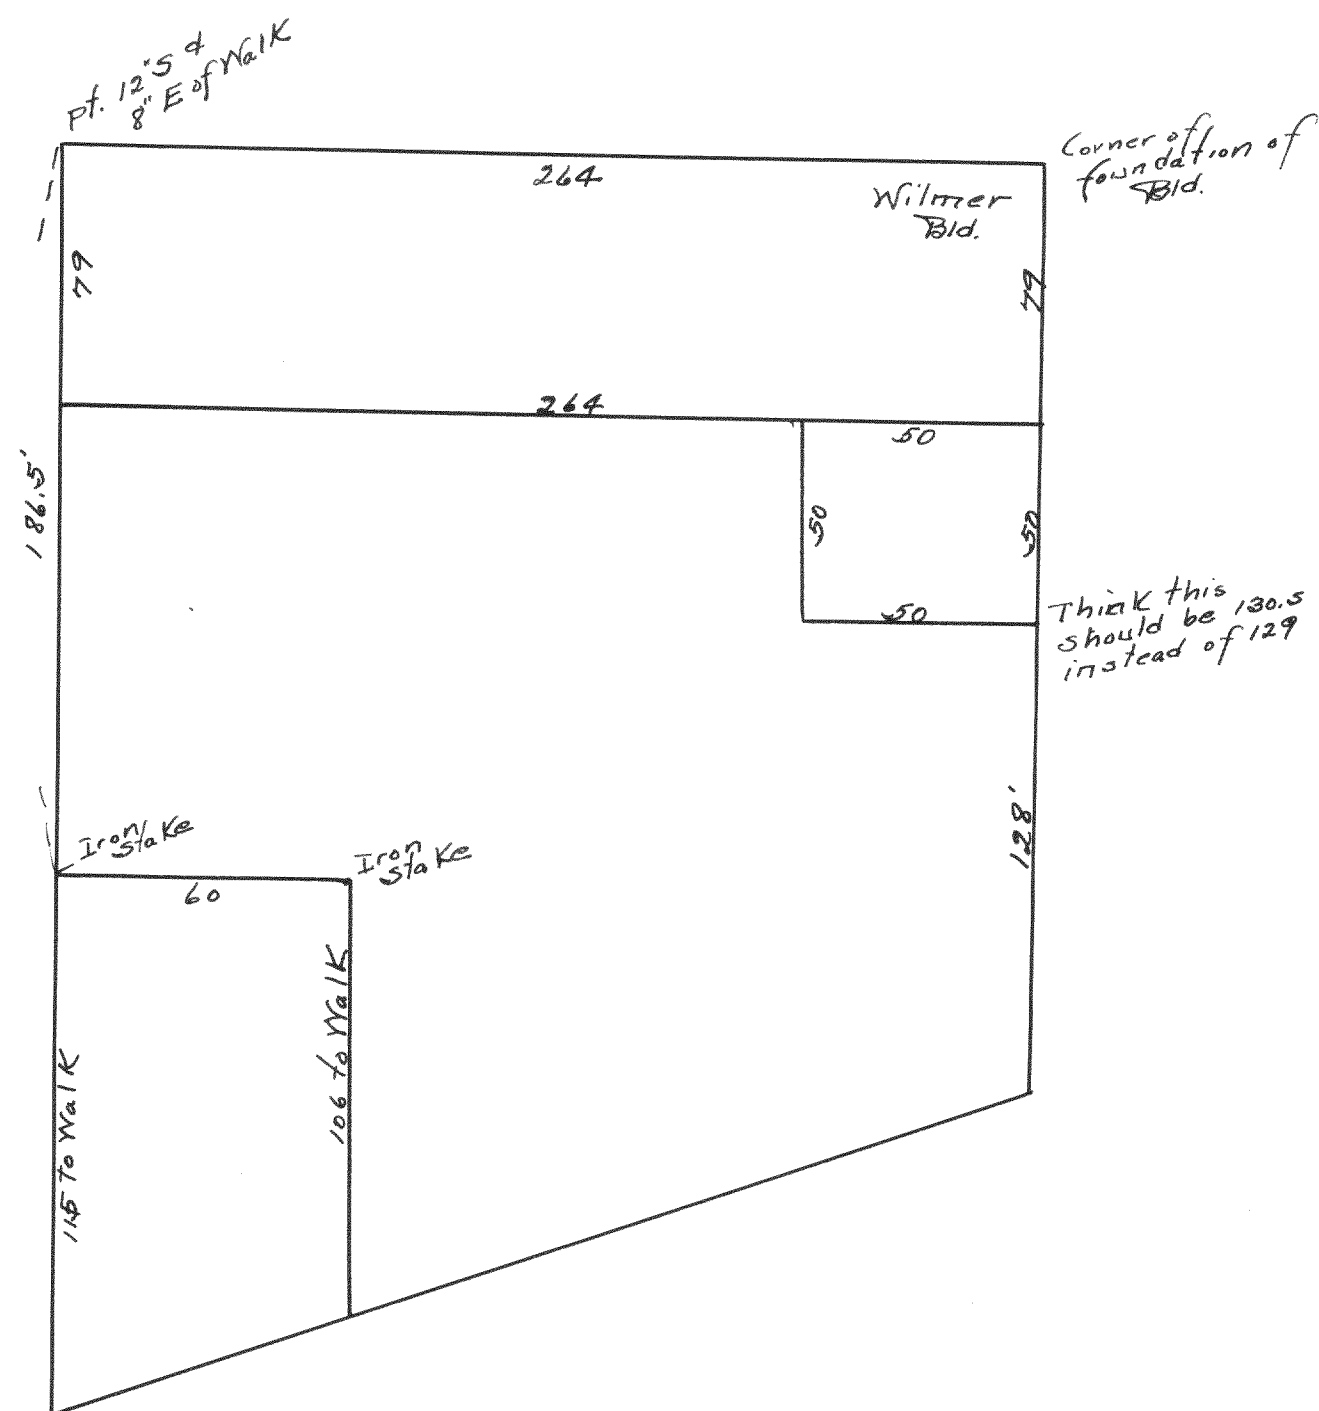

Otto Zinn

From NE corner being NE corner of brick work of Wilmer Bros. Store W. 264' and made point for NW cor. of blk., 66 more made pt. for NE of blk. 8, from best of evidence I can gain I believe point at SE corner is corner of Blk. Drive tracks in side of this post, make line 66' E of this for W. of blk. 7

By referring to deed of Shayer to - given before the village was platted, I find a description, Beginning 2.55 chains N. of section corner N 83' N 50' E 83 S 50, I believe this to be lot 3 and from sec. N 2.55 = 168.34 make pt. being 130'-7 1/2' S. of N. line of block, make pt. 32' S of this & run W parallel with N. line of Blk. 83' for SW corner of Zinn & set iron pipe, 32' N. & set pipe not on corner, made pt. in walk 33' W for SE of lot & 32' N of this marked walk for S line of lot 3.

This leaves 130'-7 1/2" across lots 1 & 3 against 129 as in Plat & 128'-6" against 128 as in Plat, There being 2'-1" overplus in Blk.

Surveyed by William Child.  
April 8, 1912

Recorded by Floyd S. Jensen  
Feb. 2, 1934