


Record of Survey.
Troy Center

no 208

Township....., North of Range.....of 4 Principal Meridian
as presented by the courses and distances on the following plat, and annexed field-notes of survey:
Established the center of the section at the point of intersection of STRAIGHT quarter lines.
Established all quarter-quarter corners upon the section boundary at proportional distances between known section and quarter section corners, according to the original field-notes of the Government survey.
Established all lost corners at proportionate distances between known corners, according to the original field notes of the Government survey.

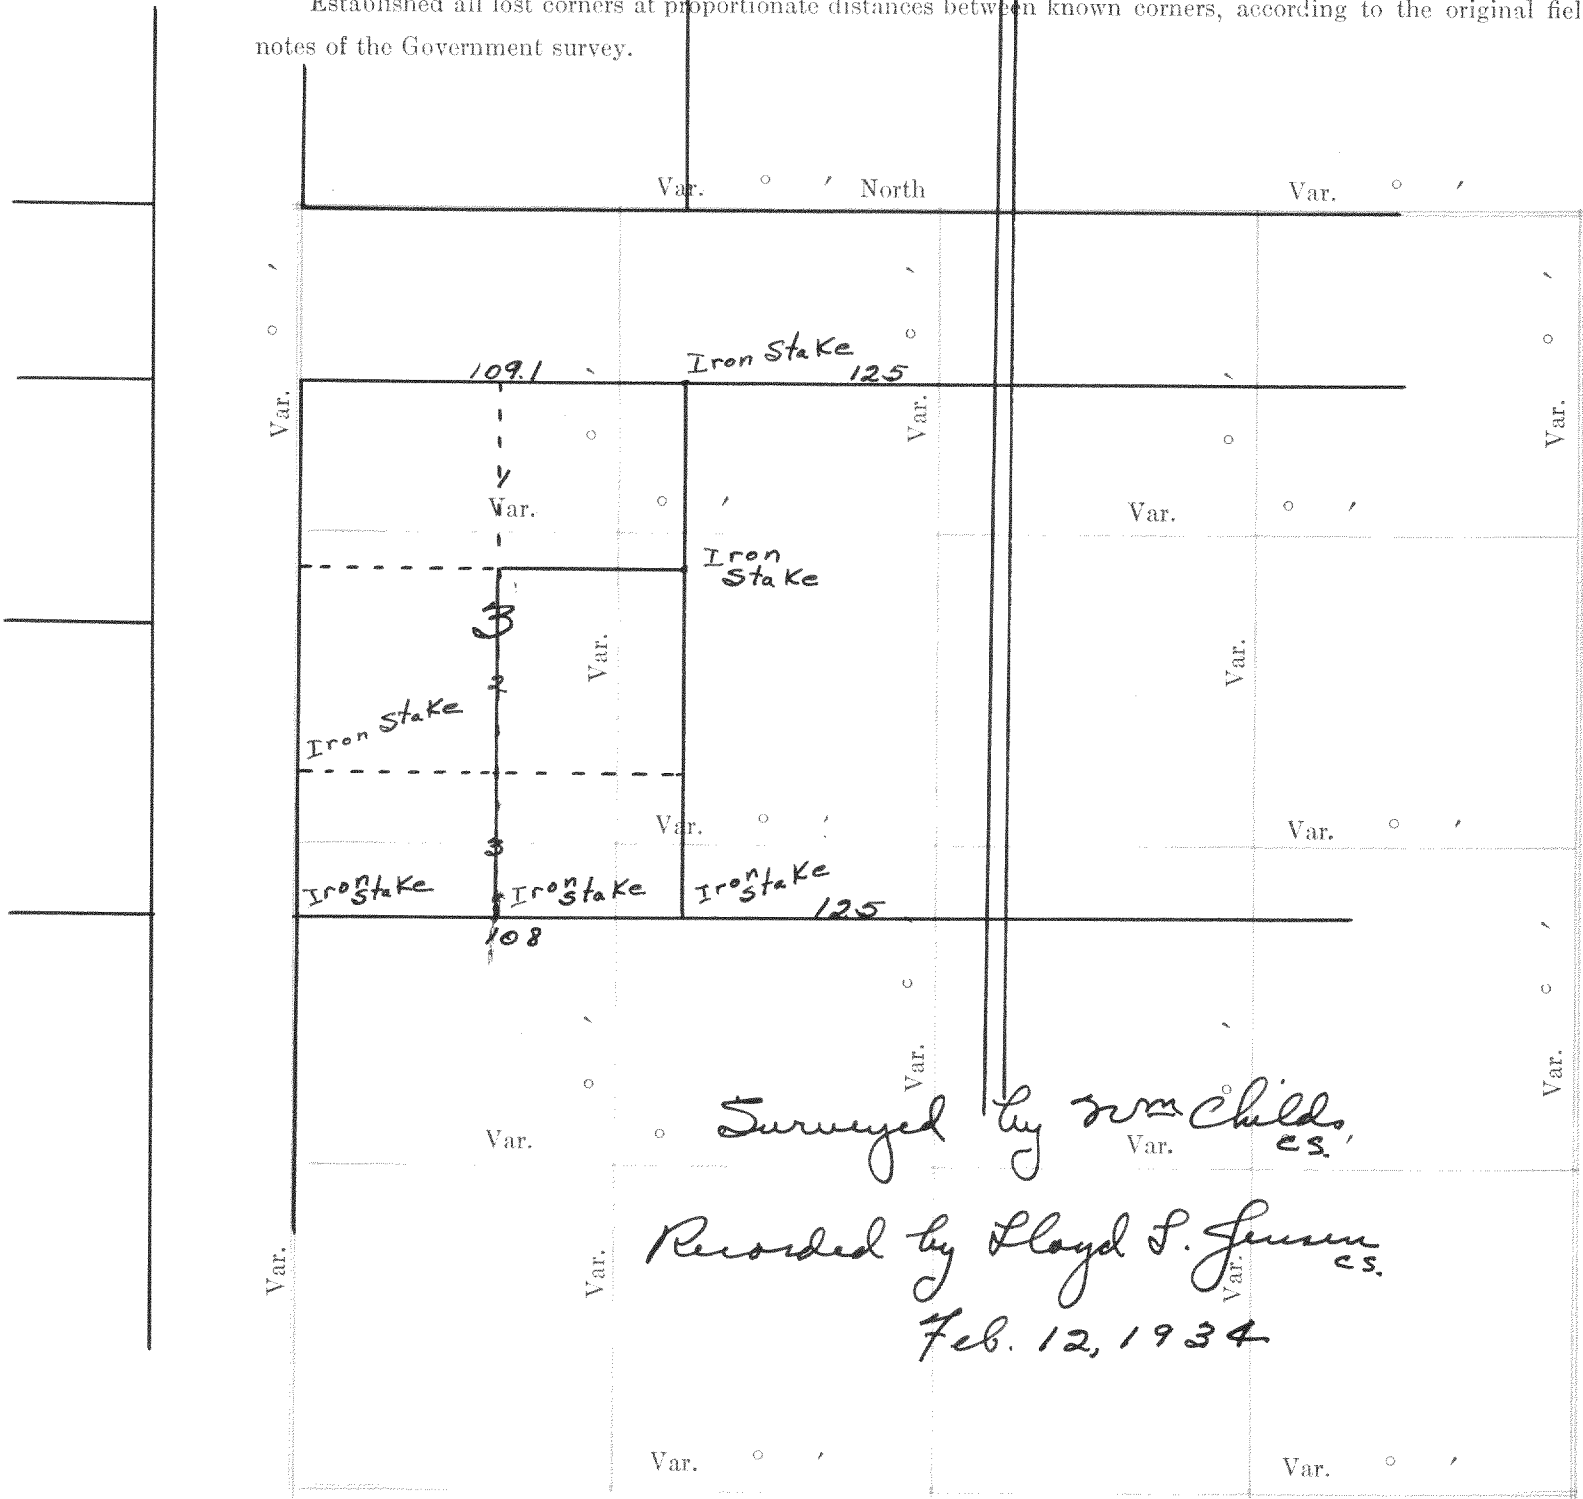

Plat of Section....., Township.....North, Range.....of 4 Principal Meridian Scale
80 chains to 6 inches. The figures in red ink are the lengths of the lines as stated in the field-notes of the Government survey.

Declination of the Magnetic Meridian from the True Meridian.....
Surveyed and sub-divided.....A. D. 1, in accordance
with the State Laws and Instructions of the Commissioner of the General Land office, and recorded on pages
.....of Register in the County Clerk's office.
Witness my hand this.....day of.....A. D. 1
.....SURVEYOR.

DESCRIPTION

OF SECTION, QUARTER SECTION AND QUARTER QUARTER SECTION CORNERS

GOVERNMENT CORNERS				H. C. MILLER CO. MFG. STATIONERS, MILWAUKEE WIS. 5000								
No.	Bearing Trees	In. Dia.	Courses they bear	Links Distant	Bearing Trees	In. Dia.	Courses they bear	Links Distant	Bearing Trees	In. Dia.	Courses they bear	Links Distant
1. N. W. Sec. Cor. identified,												
2. N. E. Sec. Cor. identified,												
3. S. E. Sec. Cor. identified,												
4. S. W. Sec. Cor. identified,												
5. N. 1/4 Sec. Cor. identified,												
6. E. 1/4 Sec. Cor. identified,												
7. S. 1/4 Sec. Cor. identified,												
8. W. 1/4 Sec. Cor. identified,												
Subdivision Corners												
1. Center 1/4 Sec. Cor.												
2. North 1/4-1/4s N. W. qr.,												
3. East 1/4-1/4s N. W. qr.,												
4. South 1/4-1/4s N. W. qr.,												
5. West 1/4-1/4s N. W. qr.,												
6. Center 1/4-1/4s N. W. qr.,												
7. North 1/4-1/4s N. E. qr.,												
8. East 1/4-1/4s N. E. qr.,												
9. South 1/4-1/4s N. E. qr.,												
10. Center 1/4-1/4s N. E. qr.,												
11. East 1/4-1/4s S. E. qr.,												
12. South 1/4-1/4s S. E. qr.,												
13. West 1/4-1/4s S. E. qr.,												
14. Center 1/4-1/4s S. E. qr.,												
15. South 1/4-1/4s S. W. qr.,												
16. West 1/4-1/4s S. W. qr.,												
17. Center 1/4-1/4s S. W. qr.,												

No. 209 35426-4-17 Hart and Hewitt

Began at south gr. post of 26 found stake and stones set new stake and stones, ran C, at 20.3 found stake for 1/8 post set by former survey, ran on to 40.70 and made post on bridge for corner, 3-10 N. of S. of bridge, ran back 11.50 and set stake, from this stake C. 3.72 Then north 8.54 + 4.40 + 3.78 to a point 1.16 E. of a point that is 582 1/2 W 9.00 from a point on East line of section 17.80 W. of S.E. corner from S. W. corner ran north parallel to this line 8.5 and set stake East of fence corner, then north East to point on line. Ran 8.54 + 4.40 N 5.76 and set stake 16 in. North of post, then north west 3.95 to point 9.00 582 1/2 W of NE corner of piece and set stake, being 3-8 N. of post, stake at NE corner is 23-9 E of tree and at SW corner 4-10 SE. of tree.

From 1/8 post 519.81 NW corner of Odell 39.81 fence, C. along fence 20.34 stake, N 20.1 N. line of Odells, 40.09 corner.

Surveyed by Wm Child CS.
Nov. 22, 1907
Recorded by Lloyd S. Turner

no 209 35 + 26 - 4 - 17
Hart and Hewitt
Began at south q. post of 26 found stake and
stones set new stake and stones, ran E, at 20.35
found stake for 1/8 post set by former survey,
ran on to 40.70 and made post on ridge for
corner, 3-10 N. of S. of ridge, ran back 11.50
and set stake, from this stake E. 3.72
Then north 8.54 + 4.40 + 3.78 to a point 1.16 E
of a point that is 582 1/2 W 9.00 from a point on
East line of section 17.80 W. of SE. corner from
S. W. corner ran north parallel to this line 8.54
and set stake East of fence corner, Then north
East to point on line. Ran 8.54 + 4.40 N 5.76 and
set stake 16 in. North of post, Then north west
3.95 to point 9.00 582 1/2 W of NE corner of piece
and set stake, being 3-8 N. of post, Stake at
NE corner is 23-9 E of tree and at SW cor.
4-10 SE. of tree.
From 1/8 post 519.81 NW corner of Odell
39.81 fence, E. along fence 20.34 stake, N 20.15
N. line of Odells, 40.09 corner.

Surveyed by Wm Childs
CS.
Nov. 22, 1907
Recorded by Lloyd S. Jensen
CS.
Feb. 12, 1934

NAMES OF SWORN ASSISTANTS

CHAINMEN

FLAGMEN

AXMEN

no 210

Troy E. T. Adkins

N 139, S 12 W 187.5, 179.5 30 from
corner of strip, N 203.5 ada 8.5, 26 from dm

Adkins description - Beginning 126 rods 3'-10"
South of northeast corner Then N 53'-10", leaving
122 rods 16' from corner, find iron stake set for this
point, point agreed on is 8.5' South of this = 123 rods
8 feet from N.E. corner, N 139' S 12° W 187.5 to fence
post at southwest of Adkins set as fenced, Southeast
along fence 179.5 to east line, North along line 203.5,
Corner is 26 from iron stake on side of road, drum stake
2' S.W. of Northwest corner.

Surveyed by Wm Child
C.S.

Recorded by Floyd S. Jensen
Feb. 12, 1934

no 211

23426-4-17

Hy and Swatoda

Beginning at East gr. post of section 23
which is $35\frac{1}{2}$ links East and $39\frac{1}{2}$ S. of fence
post at NW corner, S 40.17, Southeast corner
a stone. Set small hub at 30.17 Then N. 40.29
South gr. post drum stake, and $8.37\frac{1}{2}$ west of
gr. post on South line of section and set stake
set stake at $20.14\frac{1}{2}$ E. of gr. post for $\frac{1}{8}$ post.
From East gr. post west at $20.14\frac{1}{2}$ set stake
on true gr. line 29.14 more line of fence
on West of Niedchen land and 31.30 more
West gr. post. From stake $20.14\frac{1}{2}$ west of gr. post
South on $\frac{1}{8}$ line set stake at 30.14 40.14 $\frac{1}{8}$ post
and from $\frac{1}{8}$ post on South 22.83 stake on bank
of creek on west of Niedchen piece, South from
gr. line to stake on section line 40.06.
South in Sec. 26 at 14.80 north of creek
and 19.98 post from this post East 16.70 $\frac{1}{2}$ post,
Then S. 2.50 stake on South of fence post.
Then SE 1200 stake on North bank of creek.

Surveyed by Wm Child
C.S.
Nov. 13 1914, 1905

Recorded by Floyd S. Jensen
Feb. 12, 1934