


Record of Survey.

no 220

11-3-18

Township....., North of Range *A. Baker* of 4 Principal Meridian  
as presented by the courses and distancés on the following plat, and annexed field-notes of survey:  
Established the center of the section at the point of intersection of STRAIGHT quarter lines.  
Established all quarter-quarter corners upon the section boundary at proportional distances between known section and quarter section corners, according to the original field-notes of the Government survey.  
Established all lost corners at proportionate distances between known corners, according to the original field notes of the Government survey.

From south quarter post East 40.07 made point at 20.03 1/2. Ran north and south quarter line and found line at center to be 21 links West of corner of fence and is 2'-10" West of post at a point on hill, line is 7'-9" west of tree from east quarter post west 70 center 40.09 made point at 20.04 1/2 and ran north to point on north line of section for north and south 1/2 line in northeast quarter.

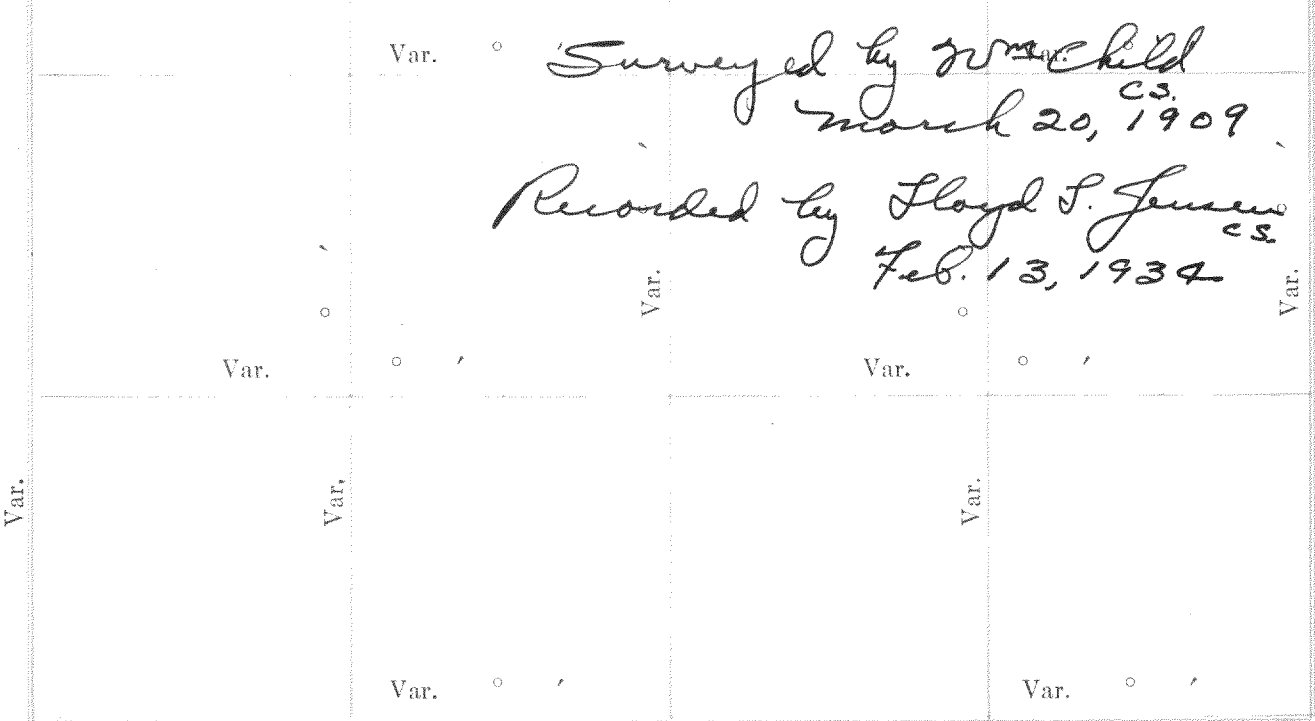

Plat of Section....., Township..... North, Range..... of 4 Principal Meridian Scale 80 chains to 6 inches. The figures in red ink are the lengths of the lines as stated in the field-notes of the Government survey.  
Declination of the Magnetic Meridian from the True Meridian.....  
Surveyed and sub-divided..... A. D. 1 , in accordance with the State Laws and Instructions of the Commissioner of the General Land office, and recorded on pages ..... of Register in the County Clerk's office.  
Witness my hand this..... day of..... A. D. 1  
..... SURVEYOR.

OF SECTION, QUARTER SECTION AND QUARTER QUARTER SECTION CORNERS

| H. C. MILLER CO., MFG. STATIONERS, MILWAUKEE WISCONSIN |         |      |           |         |         |      |           |         |         |      |           |         |         |      |           |
|--------------------------------------------------------|---------|------|-----------|---------|---------|------|-----------|---------|---------|------|-----------|---------|---------|------|-----------|
| GOVERNMENT CORNERS                                     |         |      |           |         |         |      |           |         |         |      |           |         |         |      |           |
| No.                                                    | Bearing | In.  | Courses   | Links   | Bearing | In.  | Courses   | Links   | Bearing | In.  | Courses   | Links   | Bearing | In.  | Courses   |
|                                                        | Trees   | Dia. | they bear | Distant | Trees   | Dia. | they bear | Distant | Trees   | Dia. | they bear | Distant | Trees   | Dia. | they bear |
| 1.                                                     |         |      |           |         |         |      |           |         |         |      |           |         |         |      |           |
| 2.                                                     |         |      |           |         |         |      |           |         |         |      |           |         |         |      |           |
| 3.                                                     |         |      |           |         |         |      |           |         |         |      |           |         |         |      |           |
| 4.                                                     |         |      |           |         |         |      |           |         |         |      |           |         |         |      |           |
| 5.                                                     |         |      |           |         |         |      |           |         |         |      |           |         |         |      |           |
| 6.                                                     |         |      |           |         |         |      |           |         |         |      |           |         |         |      |           |
| 7.                                                     |         |      |           |         |         |      |           |         |         |      |           |         |         |      |           |
| 8.                                                     |         |      |           |         |         |      |           |         |         |      |           |         |         |      |           |
| Subdivision Corners                                    |         |      |           |         |         |      |           |         |         |      |           |         |         |      |           |
| 1.                                                     |         |      |           |         |         |      |           |         |         |      |           |         |         |      |           |
| 2.                                                     |         |      |           |         |         |      |           |         |         |      |           |         |         |      |           |
| 3.                                                     |         |      |           |         |         |      |           |         |         |      |           |         |         |      |           |
no 221

Measured The distance from The Plank Road School in T3 N, R17 E to The residence of Taft Brothers in Section 22-3-17. The distance is 2.32 miles which is equal to 12,238 feet from school house steps to The Taft residence following along The Public Road.

Measured Feb. 13, 1934  
Floyd S. Jensen

NAMES OF SWORN ASSISTANTS

CHAINMEN

FLAGMEN

AXMEN

No 222

14-3-18

Beginning at West gr. post of lot 12-4"E, Ran South  
fell 33 feet east at gr. post on South of section from  
gr. on S. West 1485 = 90 rods to fence post; offset 15' West  
on gr. line at point 1749. South of North quarter post, set  
stake 19-2 west of random line for corner, from this stake  
west 1485 feet to point 5 feet East of corner post, from South  
west corner East 26.30 feet to North quarter post, set stake  
at 13.15 ft. on true line, from this line South 1749 feet  
and set stake 50 South of fence being 1749 feet = 106 South  
and 1485 = 90 rods west of gr. post

From this stake South 53.40 chains to line of fence on South  
of section. Beginning at Southwest corner found stone fallen into  
ditch, could easily determine its position which was 32 links  
East and 1 ft. South of true at corner of field. East from  
this corner 39.80 to quarter post made point at 17.50 = 70 rods  
which is 8 inches West of West side of gate post, making  
foot on falling 44 links, Random line ran 4 links West of  
stake at North west corner of Potter piece, set stakes on true line  
north.

Surveyed by W<sup>m</sup> Child  
CS.  
Aug 8, 1907

Recorded by Lloyd S. Jensen  
CS.  
Feb. 14, 1934

No 223

6-3-18

Adkinson and Becker

Found stake at center, measured South  
39.85 South quarter post  
10.04  
15940  
3985  
40009.40

From center and South quarter post East  
10.04 and ran line for East line of  
40 Acres off the West side of South East  
quarter of Section.

Surveyed by W<sup>m</sup> Child  
CS.  
March 16, 1908

Recorded by Lloyd S. Jensen  
CS.  
Feb. 14, 1934