

Record of Survey.

no 224

15-3-18

Township....., North of Range..... of 4 Principal Meridian


as presented by the courses and distances on the following plat, and annexed field-notes of survey:

Established the center of the section at the point of intersection of STRAIGHT quarter lines.

Established all quarter-quarter corners upon the section boundary at proportional distances between known section and quarter section corners, according to the original field-notes of the Government survey.

Established all lost corners at proportionate distances between known corners, according to the original field notes of the Government survey.

Made point in line of fences north and south
Stone north of found $\frac{1}{4}$ Cor. East 2634', 1317' is about
3' East of fence made point. Ran south 1294
from fence to fence 1359 more = 2653 fence on
East and West quarter line from stone at East
quarter point, West 2650 to point set by former
survey for center, made point for $\frac{1}{8}$ point at
1325 set stakes on north and south $\frac{1}{8}$ line
north of center of quarter at center stake set was
on true north and south $\frac{1}{8}$ line, But agree on by
parties for East and W line.

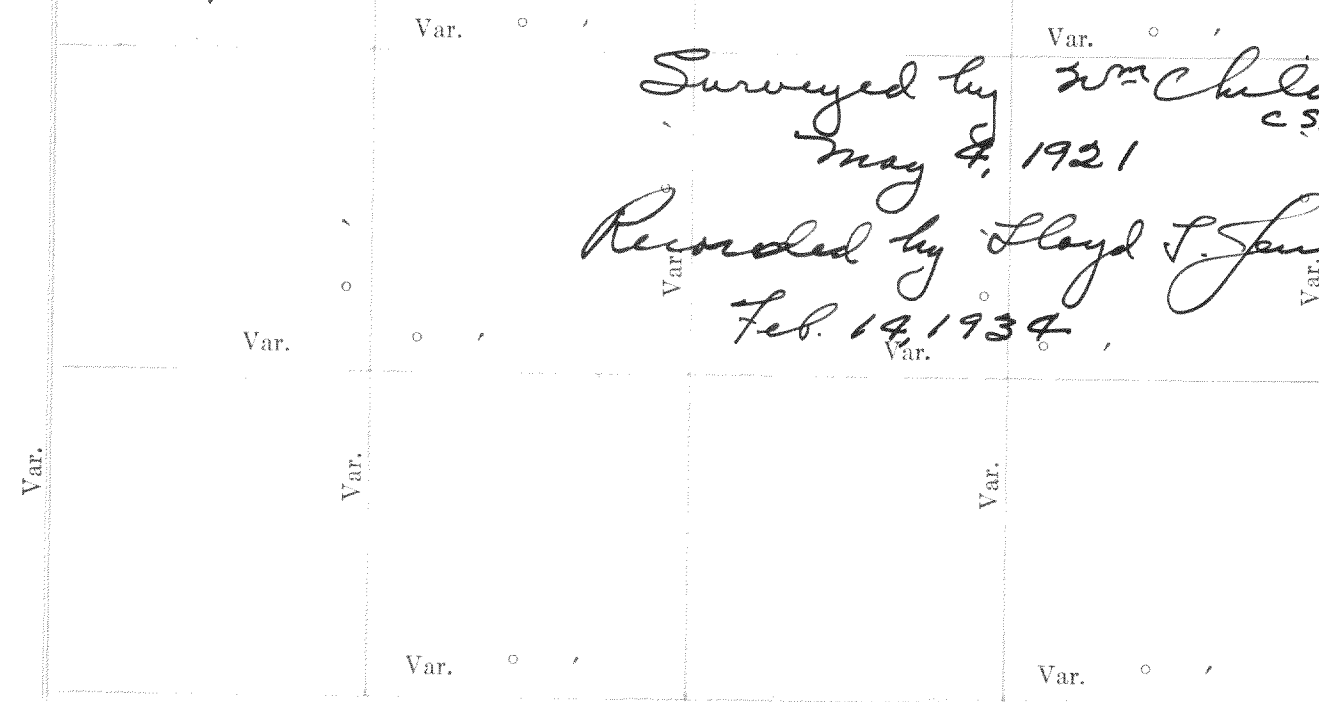

Plat of Section....., Township..... North, Range..... of 4 Principal Meridian Scale
80 chains to 6 inches. The figures in red ink are the lengths of the lines as stated in the field-notes of the
Government survey.

Declination of the Magnetic Meridian from the True Meridian.....

Surveyed and sub-divided..... A. D. 1....., in accordance
with the State Laws and Instructions of the Commissioner of the General Land office, and recorded on pages

..... of Register in the County Clerk's office.

Witness my hand this..... day of..... A. D. 1

SURVEYOR.

DESCRIPTION

OF SECTION, QUARTER SECTION AND QUARTER QUARTER SECTION CORNERS

GOVERNMENT CORNERS

Bearing
Trees

In.
Dia.

Courses
they bear

Links
Distant

Bearing
Trees

In.
Dia.

Courses
they bear

Links
Distant

Bearing
Trees

In.
Dia.

Courses
they bear

Links
Distant

Bearing
Trees

In.
Dia.

Courses
they bear

Links
Distant

H. C. MILLEN CO. MFG. STATIONERS, MILWAUKEE WISCONSIN

No.

1. N. W. Sec. Cor. identified,

no 225

2. N. E. Sec. Cor. identified,

142-3-18

3. S. E. Sec. Cor. identified,

4. S. W. Sec. Cor. identified,

5. N. $\frac{1}{4}$ Sec. Cor. identified,

6. E. $\frac{1}{4}$ Sec. Cor. identified,

7. S. $\frac{1}{4}$ Sec. Cor. identified,

8. W. $\frac{1}{4}$ Sec. Cor. identified,

Subdivision Corners

No.

1. Center $\frac{1}{4}$ Sec. Cor.

2. North $\frac{1}{4}$ - $\frac{1}{4}$ s N. W. qr.,

3. East $\frac{1}{4}$ - $\frac{1}{4}$ s N. W. qr.,

4. South $\frac{1}{4}$ - $\frac{1}{4}$ s N. W. qr.,

5. West $\frac{1}{4}$ - $\frac{1}{4}$ s N. W. qr.,

6. Center $\frac{1}{4}$ - $\frac{1}{4}$ s N. W. qr.,

7. North $\frac{1}{4}$ - $\frac{1}{4}$ s N. E. qr.,

8. East $\frac{1}{4}$ - $\frac{1}{4}$ s N. E. qr.,

9. South $\frac{1}{4}$ - $\frac{1}{4}$ s N. E. qr.,

10. Center $\frac{1}{4}$ - $\frac{1}{4}$ s N. E. qr.,

11. East $\frac{1}{4}$ - $\frac{1}{4}$ s S. E. qr.,

12. South $\frac{1}{4}$ - $\frac{1}{4}$ s S. E. qr.,

13. West $\frac{1}{4}$ - $\frac{1}{4}$ s S. E. qr.,

14. Center $\frac{1}{4}$ - $\frac{1}{4}$ s S. E. qr.,

15. South $\frac{1}{4}$ - $\frac{1}{4}$ s S. W. qr.,

16. West $\frac{1}{4}$ - $\frac{1}{4}$ s S. W. qr.,

17. Center $\frac{1}{4}$ - $\frac{1}{4}$ s S. W. qr.

Survey for Lucile McDonald
Commencing at The Southwest corner of
Section 1, Township 3 North, Range 18 East,
The County of Walworth, State of Wisconsin
running Thence East on The South line of
said Section 14.75 chains, Thence North at
right angles to said section line 10.50 chains
Thence west parallel with The South line
of said section one 16.20 chains, Thence south
10.50 chains to The south line of section 2,
Thence as aforesaid, Thence east on said south line
1.45 chains to The place of beginning,
containing 17 Acres of land.

Surveyed by Wm Child
Sept. 26, 1908

Recorded by Floyd S. Jensen
Feb. 14, 1934

no 225

142-3-18

Survey for Lucile McDonald
Commencing at The Southwest corner of
Section 1, Township 3 North, Range 18 East, in
The County of Walworth, State of Wisconsin,
running Thence East on The South line of
said Section 14.75 chains, Thence north at
right angles to said section line 10.50 chains,
Thence west parallel with The South line
of said section one 16.20 chains, Thence south
10.50 chains to The South line of section 2,
from aforesaid, Thence east on said south line
1.45 chains to The place of beginning,
containing 17 acres of land.

Surveyed by Wm Child CS
Sept. 26, 1908

Recorded by Floyd S. Jensen CS
Feb. 14, 1934

NAMES OF SWORN ASSISTANTS


CHAINMEN

FLAGMEN

AXMEN

no 226

SW of 34-3-18

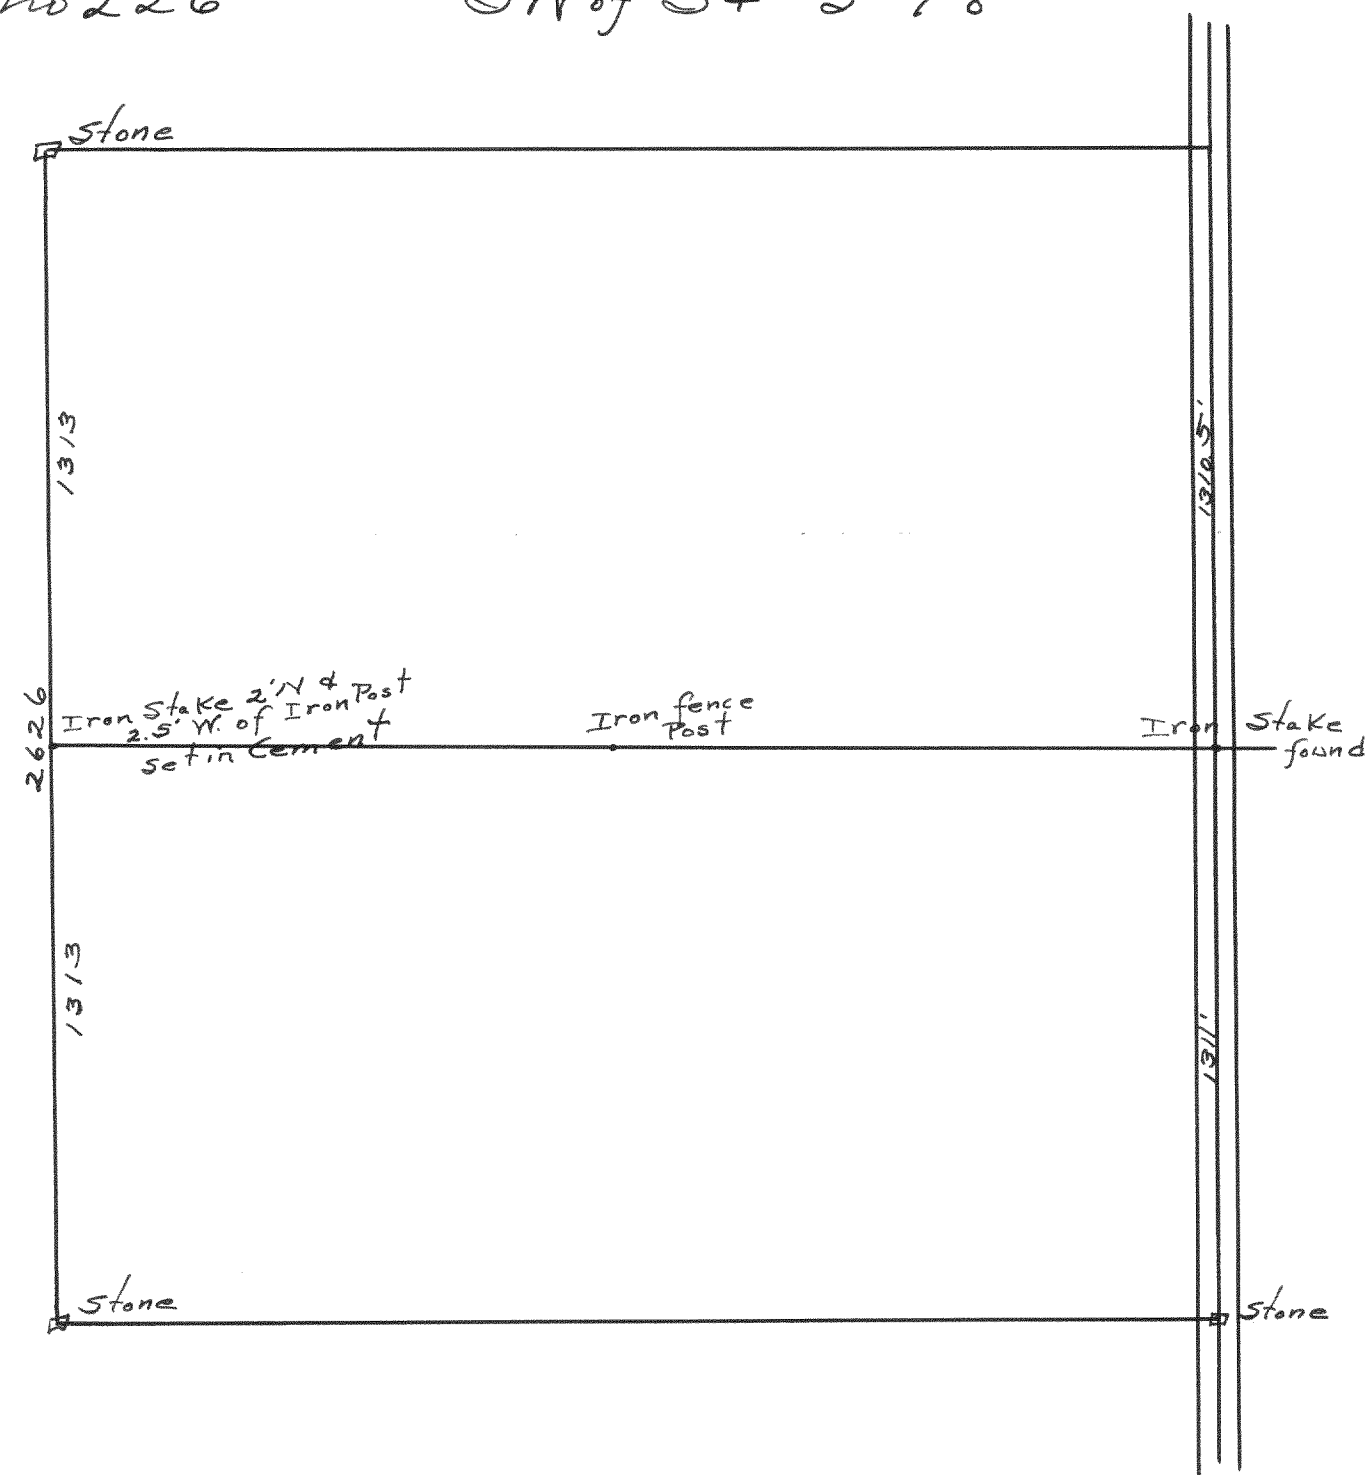


Surveyed by Wm Child
CS.

Recorded by Lloyd S. Jensen
CS
Feb. 14, 1934

3-18

Vienna

no 227

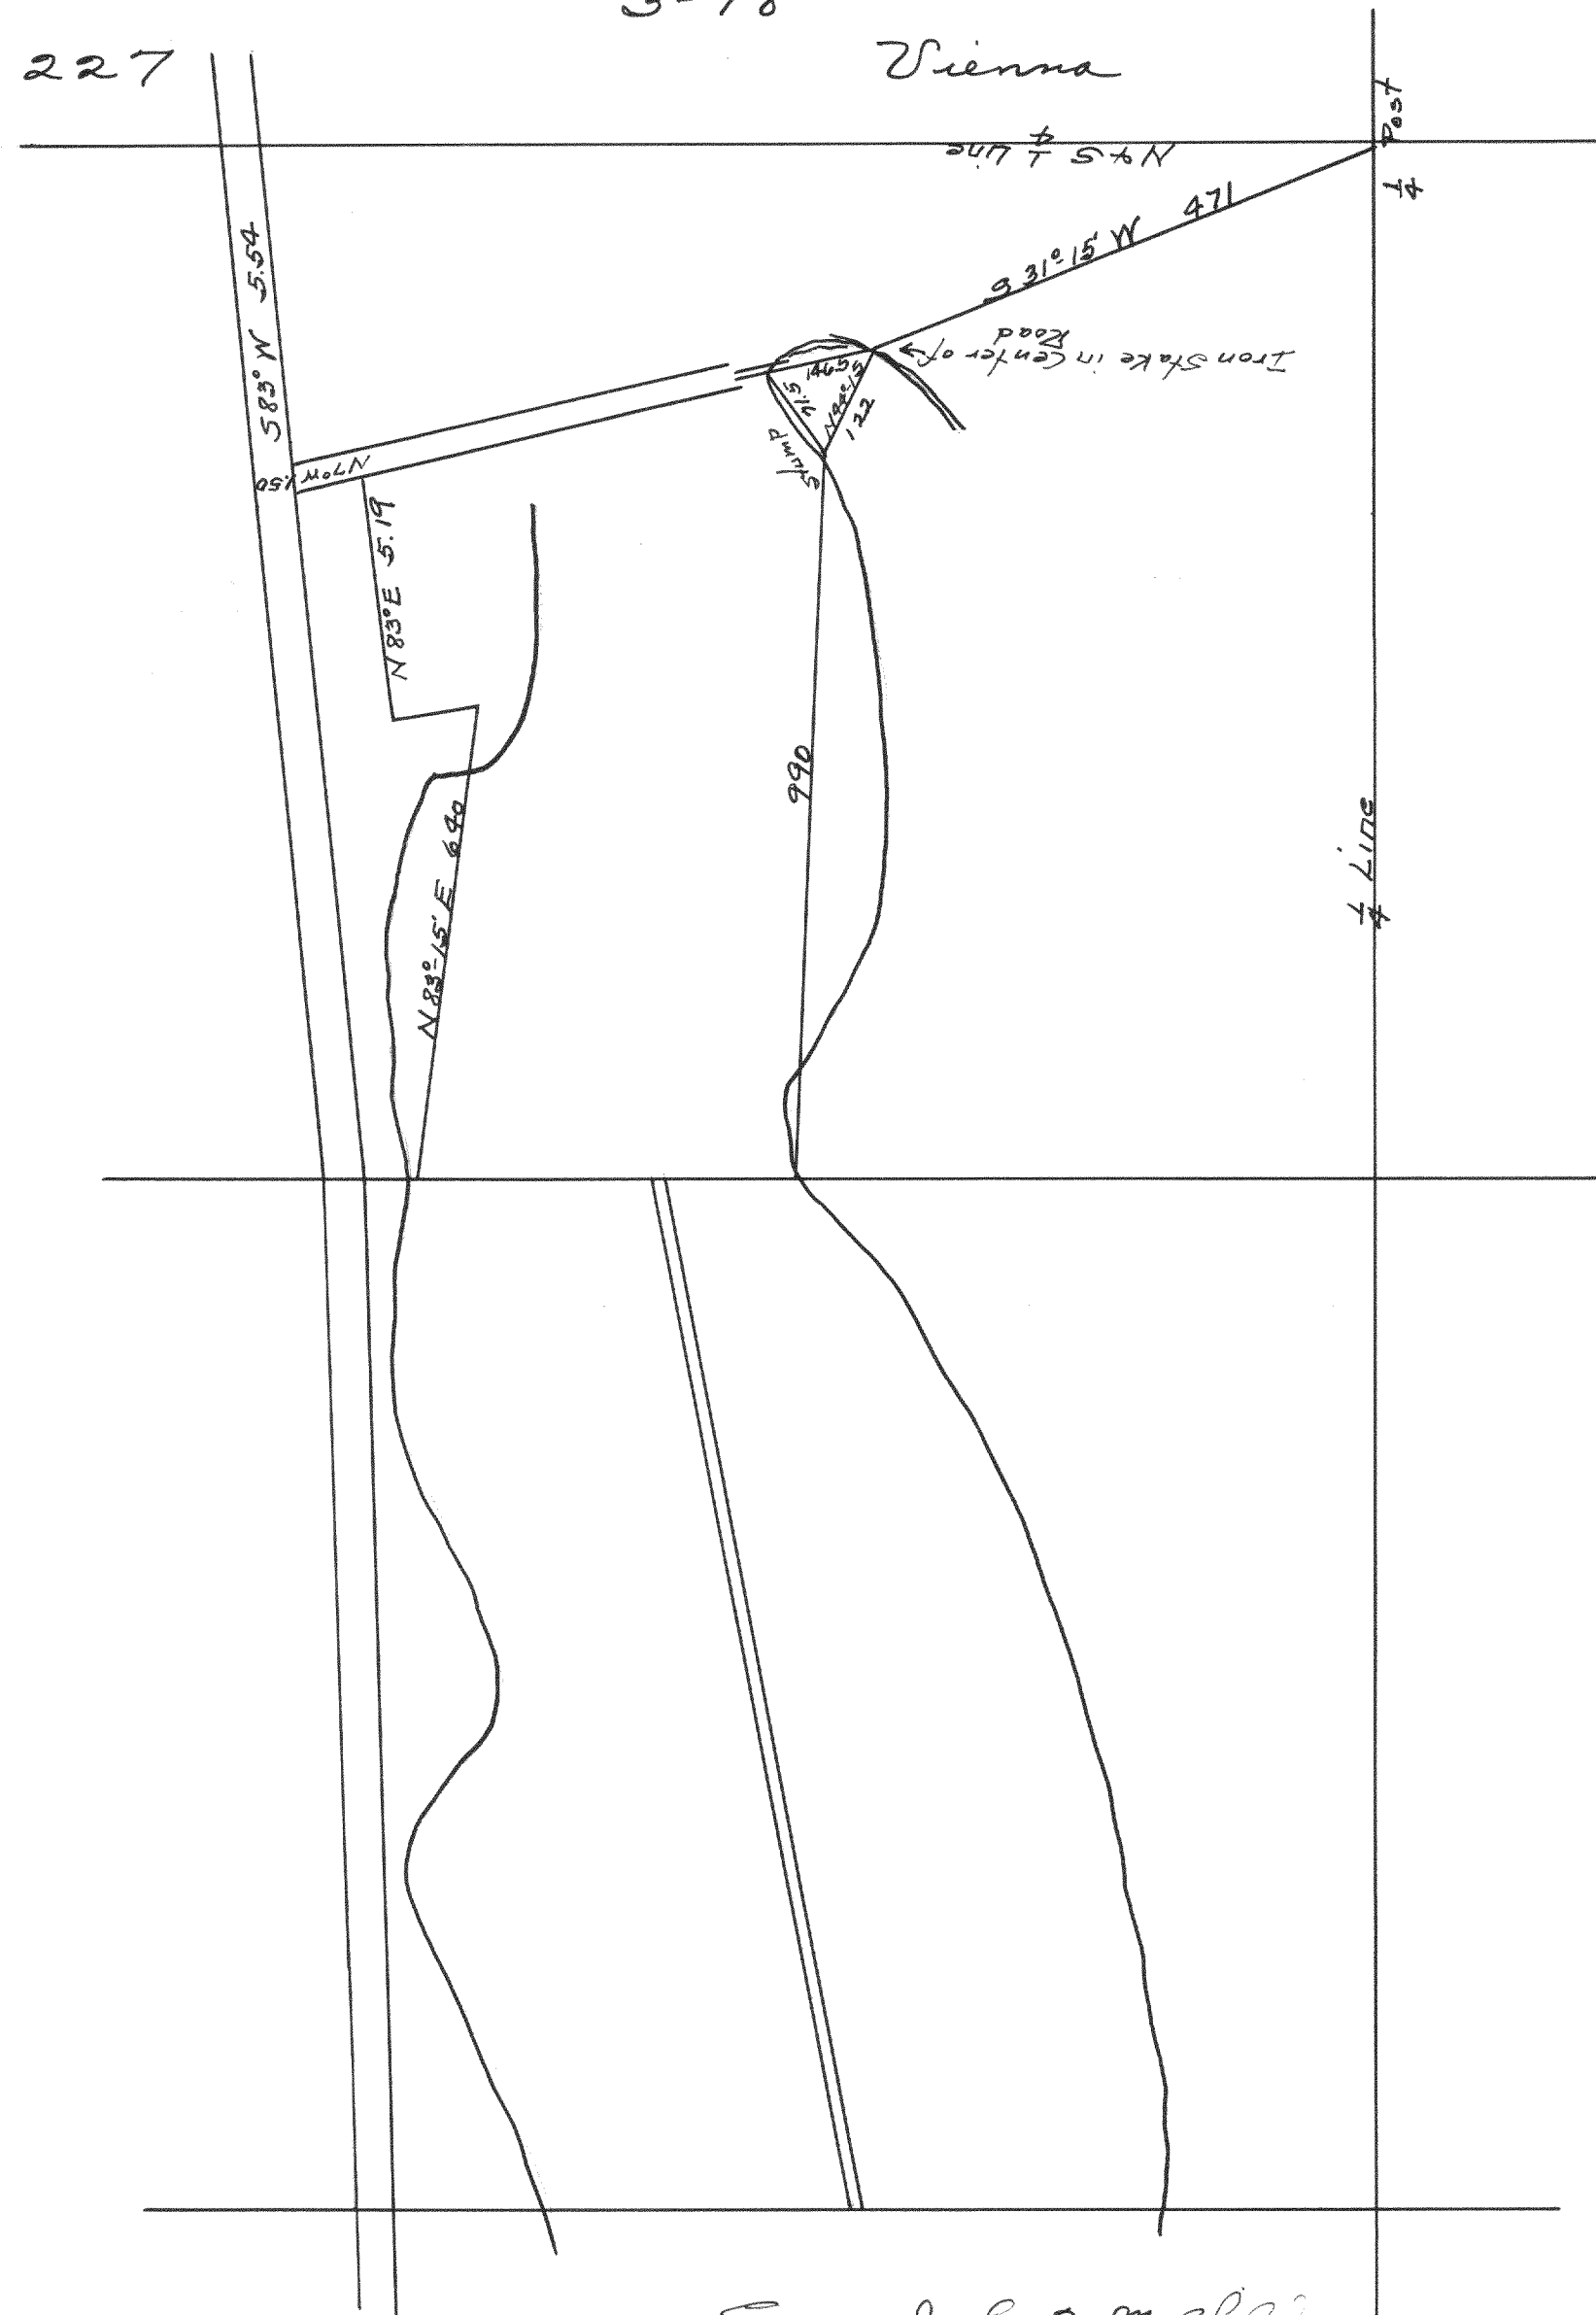

Surveyed by Wm Child
CS
Recorded by Lloyd S. Jensen
CS
Feb. 14, 1934