


Record of Survey.

Township.....4....., North of Range.....16.....of 4 Principal Meridian
as presented by the courses and distances on the following plat, and annexed field-notes of survey:
Established the center of the section at the point of intersection of STRAIGHT quarter lines.
Established all quarter-quarter corners upon the section boundary at proportional distances between known section and quarter section corners, according to the original field-notes of the Government survey.
Established all lost corners at proportionate distances between known corners, according to the original field notes of the Government survey.

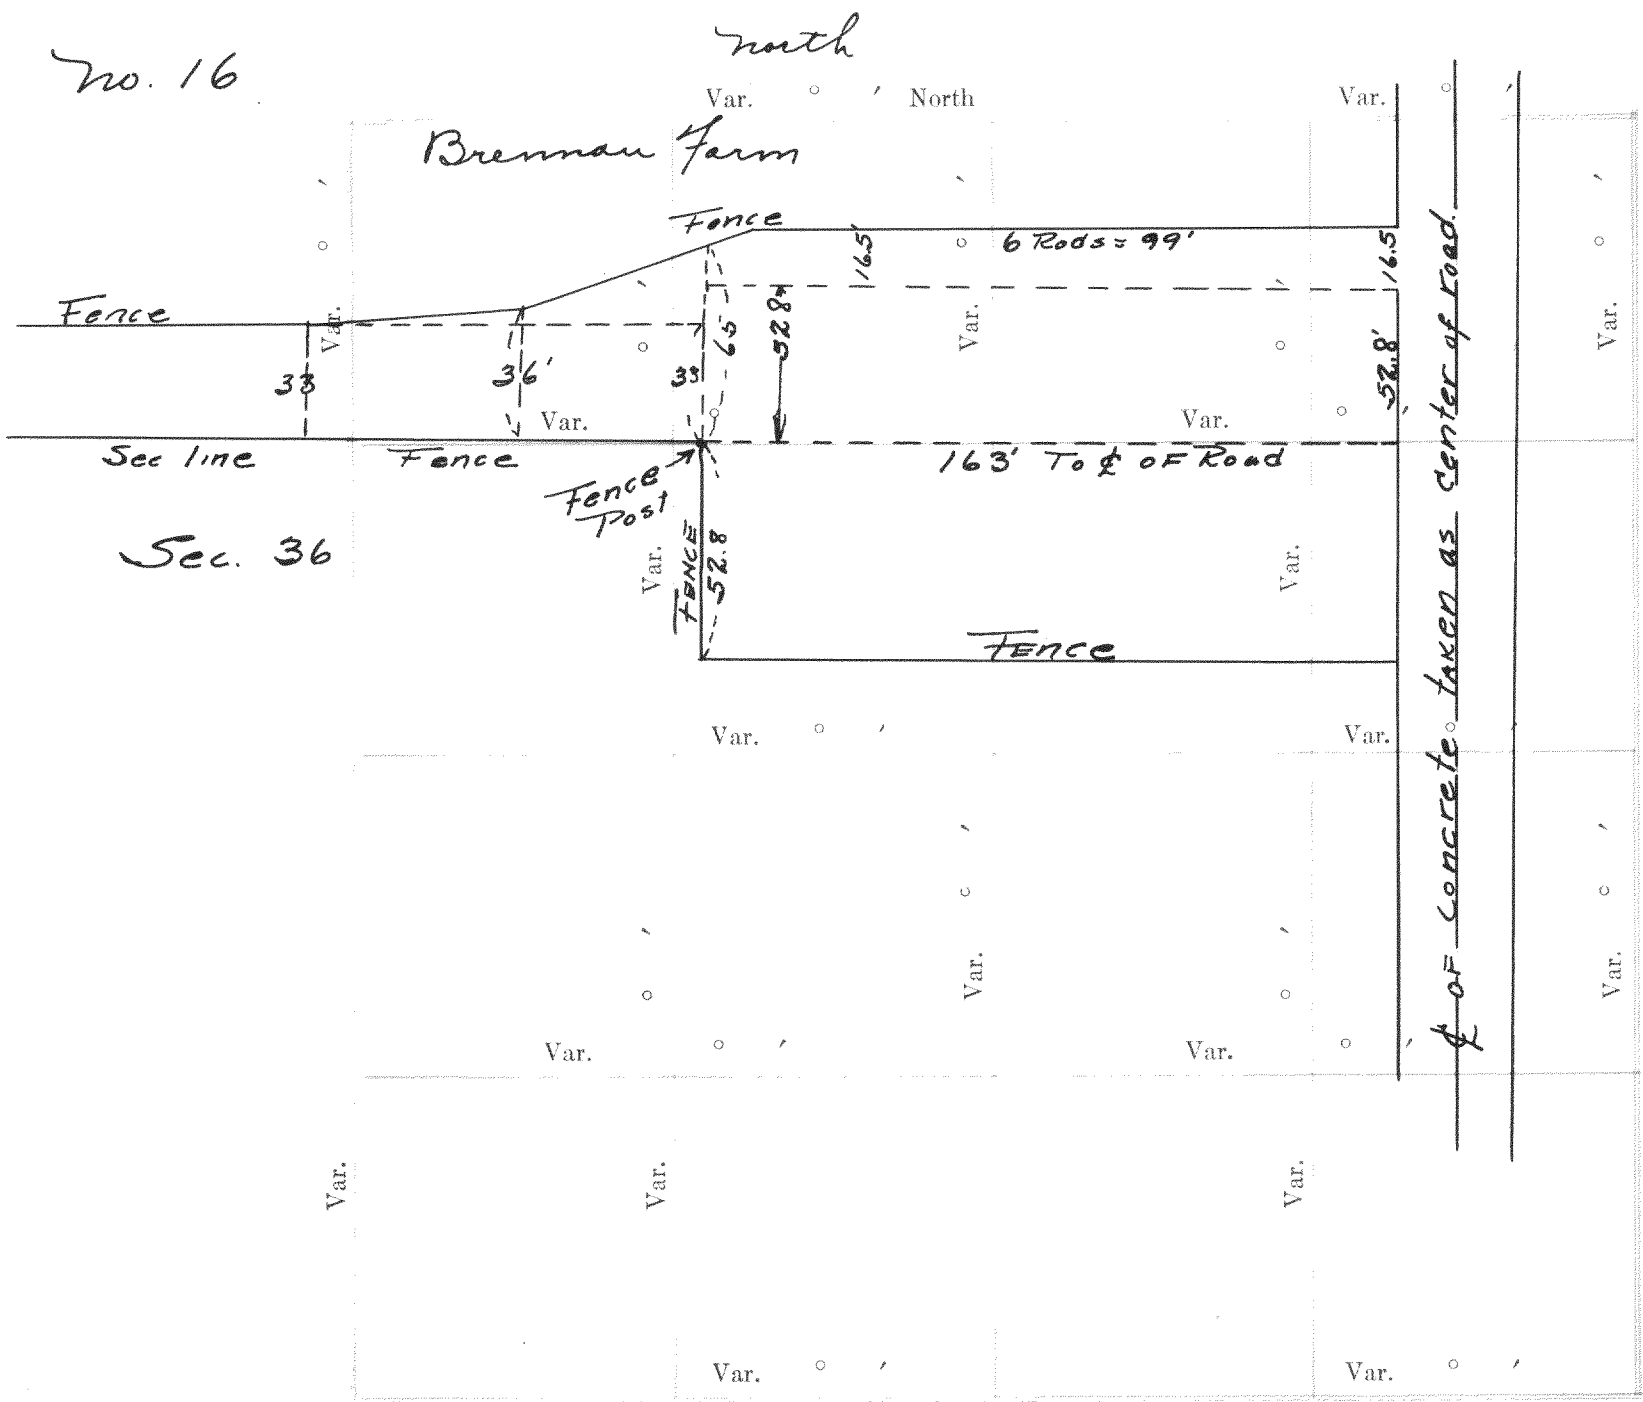

Plat of Section....., Township.....North, Range.....of 4 Principal Meridian Scale
80 chains to 6 inches. The figures in red ink are the lengths of the lines as stated in the field-notes of the
Government survey.
Declination of the Magnetic Meridian from the True Meridian.....
Surveyed and sub-divided.....A. D. 1, in accordance
with the State Laws and Instructions of the Commissioner of the General Land office, and recorded on pages
.....of Register in the County Clerk's office.
Witness my hand this.....day of.....A. D. 1
.....SURVEYOR.

DESCRIPTION

OF SECTION, QUARTER SECTION AND QUARTER QUARTER SECTION CORNERS

GOVERNMENT CORNERS				Subdivision Corners			
No.	Bearing Trees	In. Dia.	Courses they bear	Links Distant	No.	Bearing Trees	In. Dia.
1. N. W. Sec. Cor. identified,					1. Center 1/4 Sec. Cor.		
2. N. E. Sec. Cor. identified,					2. North 1/4-1/4s N. W. qr.,		
3. S. E. Sec. Cor. identified,					3. East 1/4-1/4s N. W. qr.,		
4. S. W. Sec. Cor. identified,					4. South 1/4-1/4s N. W. qr.,		
5. N. 1/4 Sec. Cor. identified,					5. West 1/4-1/4s N. W. qr.,		
6. E. 1/4 Sec. Cor. identified,					6. Center 1/4-1/4s N. W. qr.,		
7. S. 1/4 Sec. Cor. identified,					7. North 1/4-1/4s N. E. qr.,		
8. W. 1/4 Sec. Cor. identified,					8. East 1/4-1/4s N. E. qr.,		
					9. South 1/4-1/4s N. E. qr.,		
					10. Center 1/4-1/4s N. E. qr.,		
					11. East 1/4-1/4s S. E. qr.,		
					12. South 1/4-1/4s S. E. qr.,		
					13. West 1/4-1/4s S. E. qr.,		
					14. Center 1/4-1/4s S. E. qr.,		
					15. South 1/4-1/4s S. W. qr.,		
					16. West 1/4-1/4s S. W. qr.,		
					17. Center 1/4-1/4s S. W. qr.		

Survey of school property in Sec. 24 & 36, T4N, R16E
Location - Located on the sec. line between Sec 36 & 25, T4N, R16E, west of St. Tr. Hwy #12.

In making this survey the only evidence we have of the land conveyed to the school district in section 36 are the fences and in the deed for section 25 it refers to the North West Corner of the piece already conveyed and a deed of conveyance for that piece was not found. The right of way as described in deed (see volume 80 of deeds page 228) of conveyance from Stewart to Drought is not very clear and this survey was made to show the facts as they exist at the present time.

Elkhorn Oct. 9, 1926
Wm Child
County Surveyor
Recorded Feb. 20, 1933 by
Lloyd S. Jensen
County Surveyor.


NAMES OF SWORN ASSISTANTS

CHAINMEN

FLAGMEN

AXMEN

no. 17

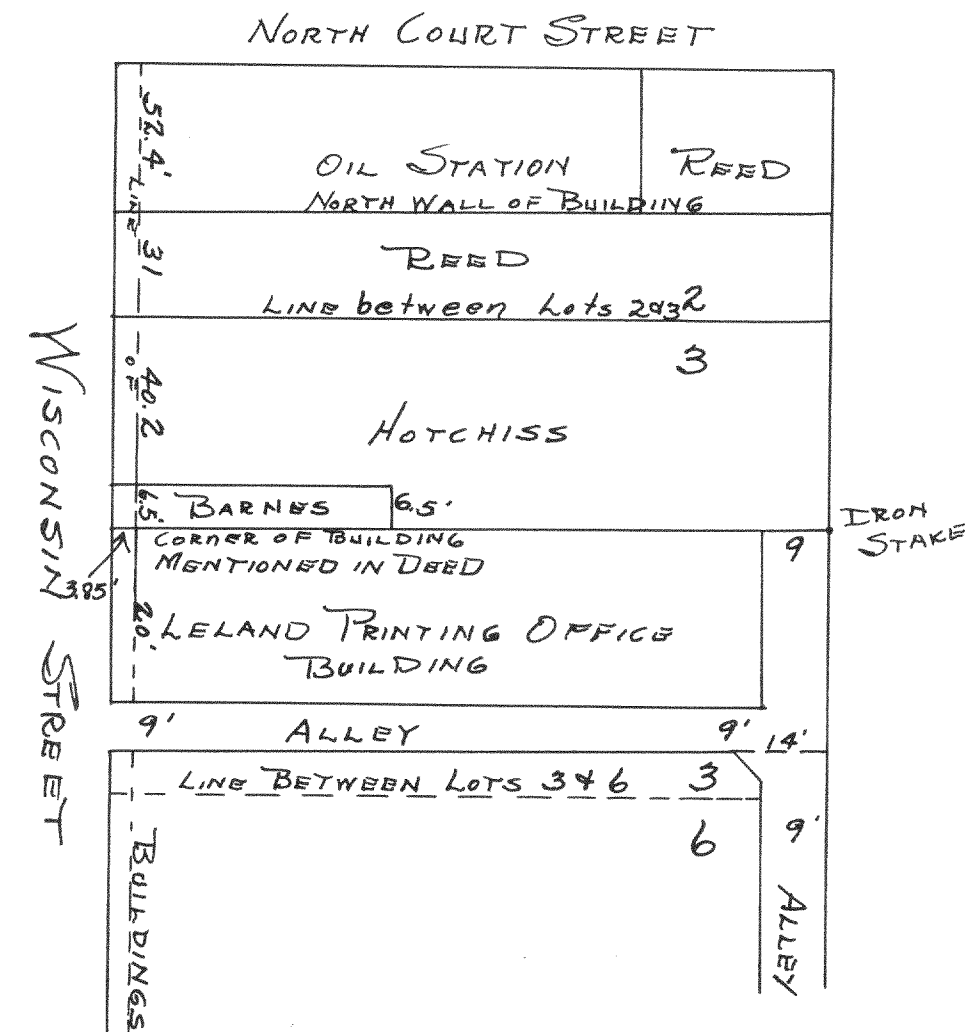

Survey in City of Elkhorn

Location - in Block 20, lots 2, 3 & 6 original town,
Sec. 36, T3N, R16E


Survey gives frontage of oil station, Reed store,
Hotchiss, Barnes and Leland Printing Office
Building on Wisconsin Street, also alley
widths and line of buildings.

No date given

Recorded Feb. 20, 1933

Lloyd S. Jensen
County Surveyor

no. 18.

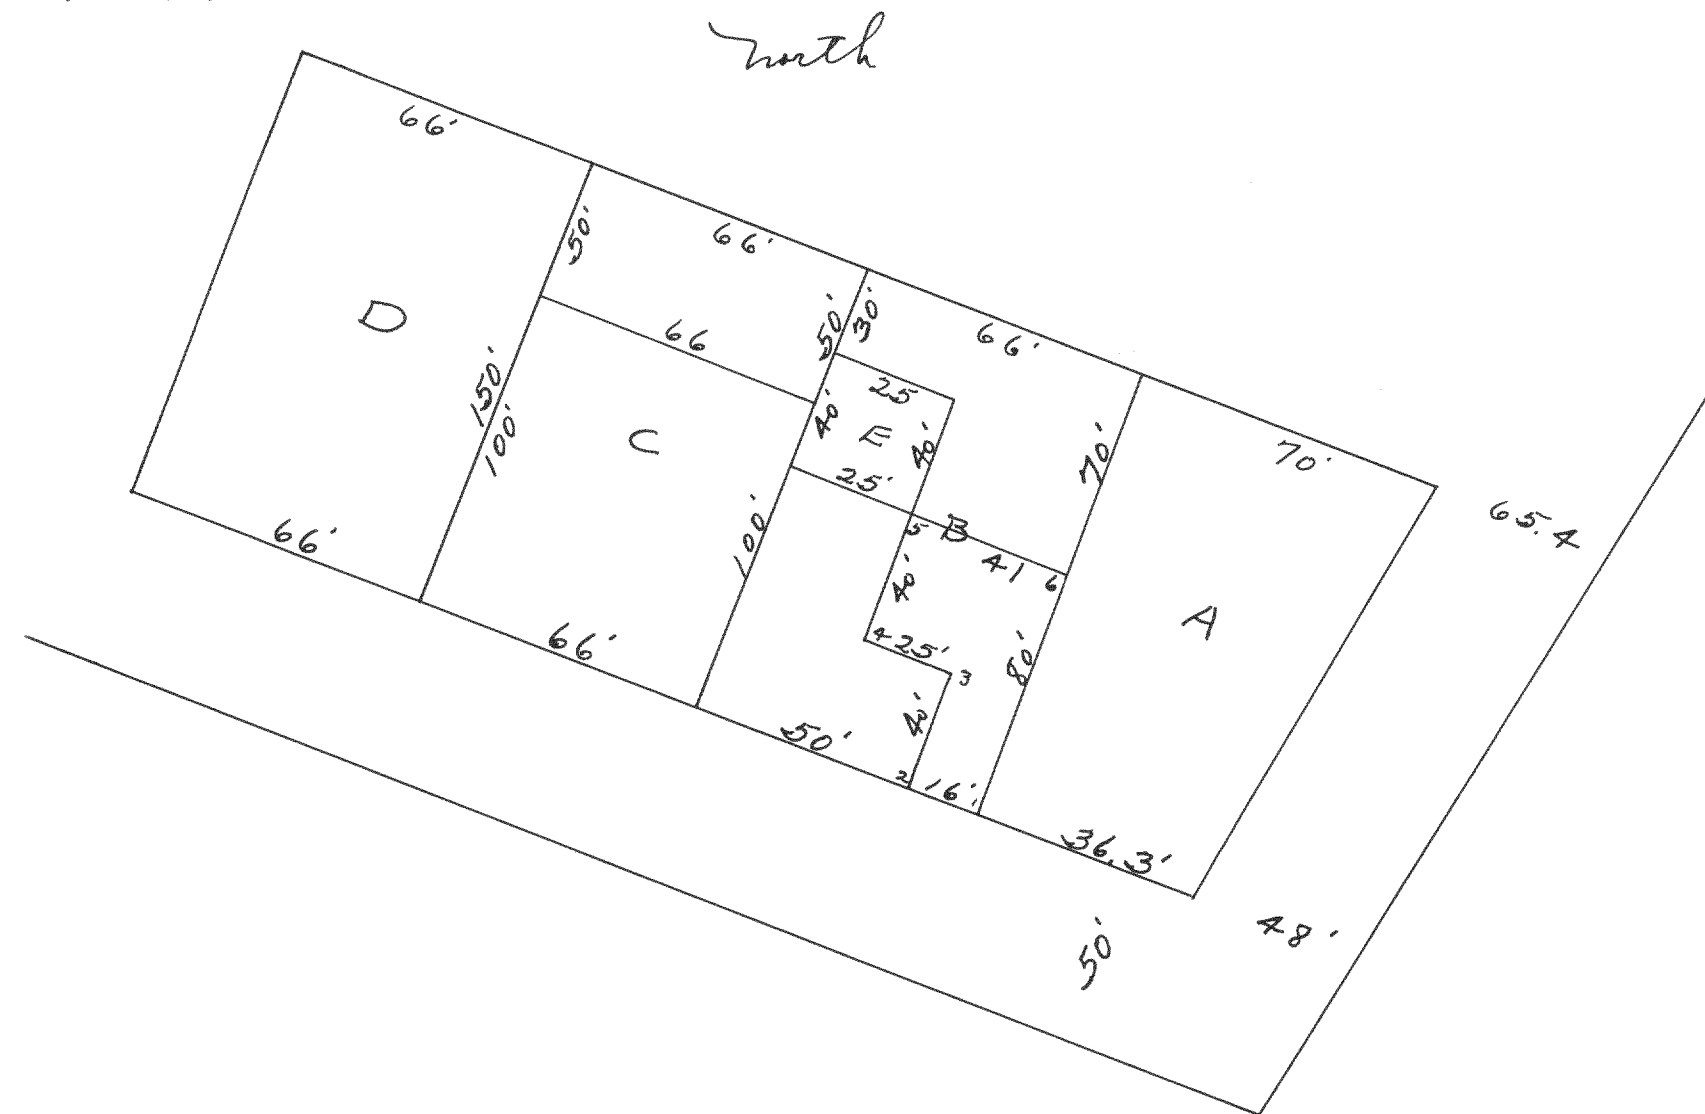

Survey to show boundaries of lots A, B, C. of Droughtville Park, located
in sections 25 & 36, T4N, R16E

Plat made to show the boundary of lots A-B-C. of the Plat
of Droughtville Park located in section No. 25 & 36, Township 4 North
Range 16 East - being the town of La-Grange, Walworth County, Wisc.
The said Plat being on record in the register of deeds office in and for
the said county, in Volume 5 of Plats on Page 145. Drought-Deeded
Mayhew on Nov. 25, 1911 as shown in Volume 133 of deeds Page 242
Lot A, the North Easterly 70 feet of Lot B and the North Easterly
50 feet of Lot C. Drought to Marshall May 13, 1912, Vol. 133
P. 620 1-2-3-4-5-6. Poole to Marshall May 22nd 1912,
Vol 133, P. 540 Parcel E.