

Record of Survey.

no. 256


35-2-17

Township....., North of Range..... of 4 Principal Meridian
as presented by the courses and distances on the following plat, and annexed field-notes of survey:

Established the center of the section at the point of intersection of STRAIGHT quarter lines.

Established all quarter-quarter corners upon the section boundary at proportional distances between known section and quarter section corners, according to the ^{original} field notes of the Government survey.	666 Top of Road	W. Cor.
---	-----------------	---------

Established all lost corners at proportionate distances between known corners, according to the original field notes of the Government survey.

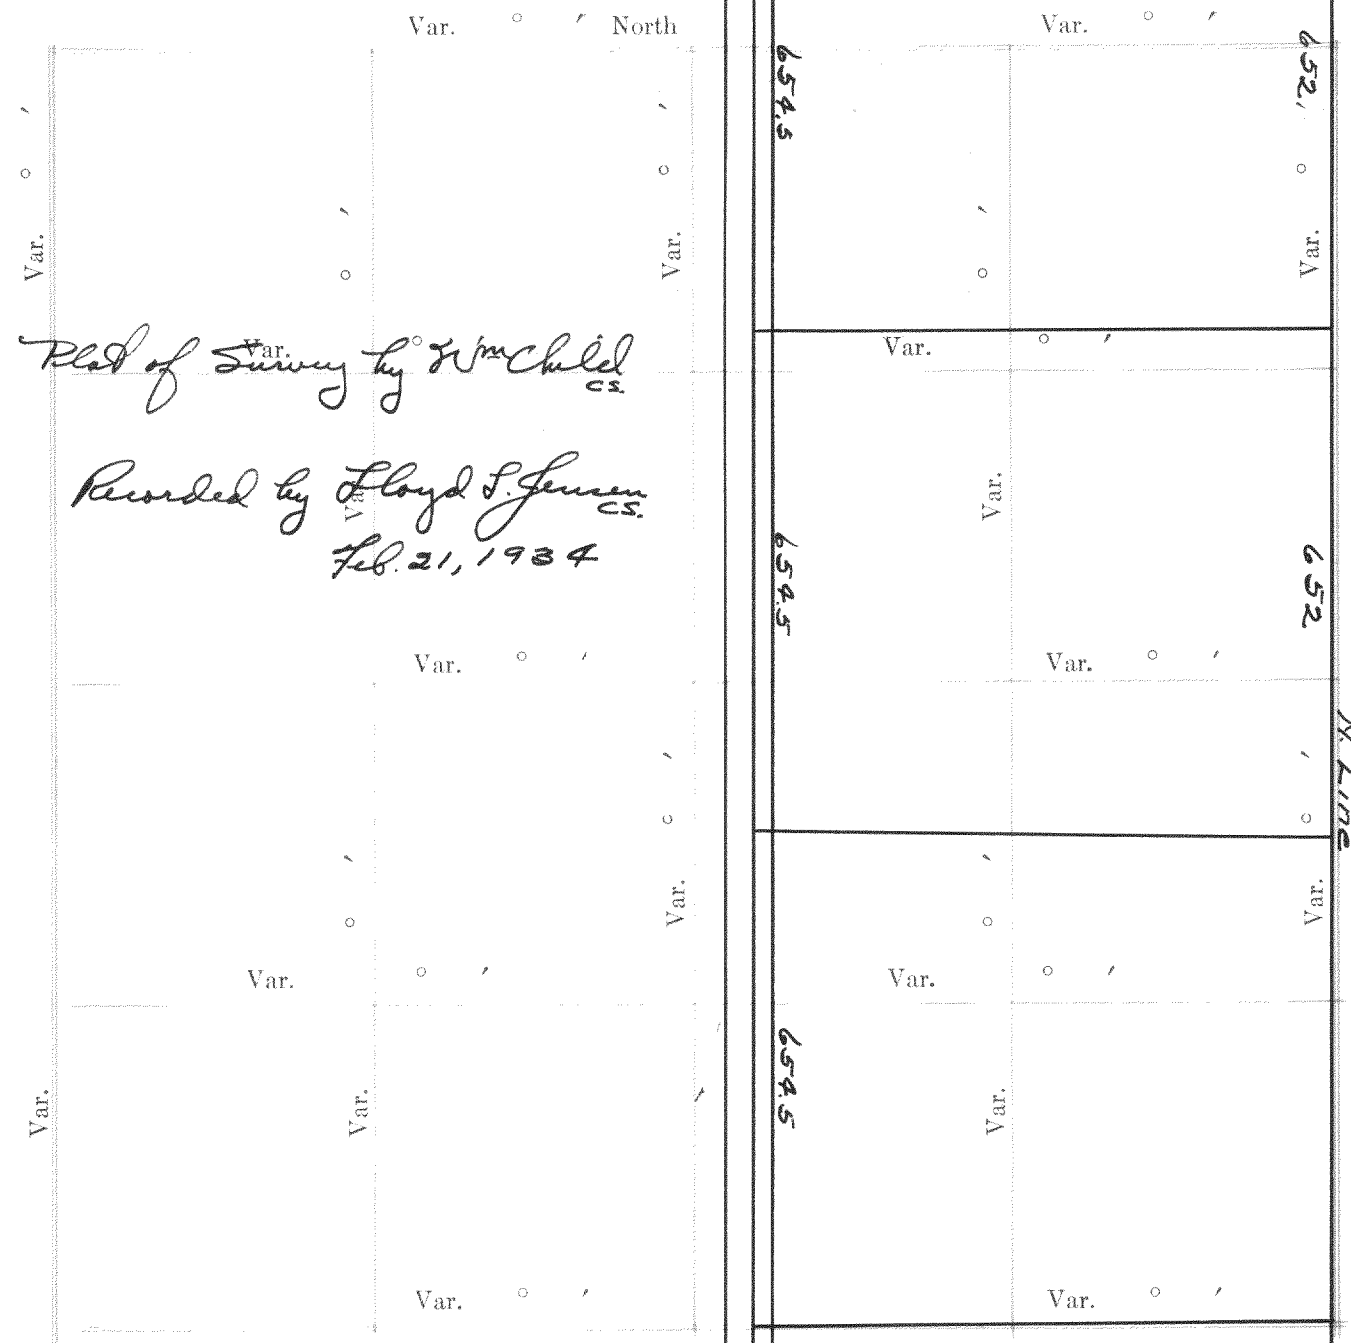

Plat of Section....., Township.....North, Range..... of 4 Principal Meridian Scale
80 chains to 6 inches. The figures in red ink are the lengths of the lines as stated in the field-notes of the
Government survey.

Declination of the Magnetic Meridian from the True Meridian.....

Surveyed and sub-divided A. D. 1, in accordance
with the State Laws and Instructions of the Commissioner of the General Land office, and recorded on pages
..... of Register in the County Clerk's office.

Witness my hand this _____ day of _____ A. D. 1 _____

DESCRIPTION

OF SECTION, QUARTER SECTION AND QUARTER QUARTER SECTION CORNERS

GOVERNMENT CORNERS

Bearing
Trees
In.
Dia.
Courses
they bear
Links
Distant
Bearing
Trees
In.
Dia.
Courses
they bear
Links
Distant
Bearing
Trees
In.
Dia.
Courses
they bear
Links
Distant
Bearing
Trees
In.
Dia.
Courses
they bear
Links
Distant

H. C. MILLER CO., MFG. STATIONERS, MILWAUKEE X15000

No.

1. N. W. Sec. Cor. identified, *no. 257*

2. N. E. Sec. Cor. identified,

3. S. E. Sec. Cor. identified,

4. S. W. Sec. Cor. identified,

5. N. $\frac{1}{4}$ Sec. Cor. identified,

6. E. $\frac{1}{4}$ Sec. Cor. identified,

7. S. $\frac{1}{4}$ Sec. Cor. identified,

8. W. $\frac{1}{4}$ Sec. Cor. identified,

Subdivision Corners

No.

1. Center $\frac{1}{4}$ Sec. Cor.

2. North $\frac{1}{4}$ - $\frac{1}{4}$ s N. W. qr.,

3. East $\frac{1}{4}$ - $\frac{1}{4}$ s N. W. qr.,

4. South $\frac{1}{4}$ - $\frac{1}{4}$ s N. W. qr.,

5. West $\frac{1}{4}$ - $\frac{1}{4}$ s N. W. qr.,

6. Center $\frac{1}{4}$ - $\frac{1}{4}$ s N. W. qr.,

7. North $\frac{1}{4}$ - $\frac{1}{4}$ s N. E. qr.,

8. East $\frac{1}{4}$ - $\frac{1}{4}$ s N. E. qr.,

9. South $\frac{1}{4}$ - $\frac{1}{4}$ s N. E. qr.,

10. Center $\frac{1}{4}$ - $\frac{1}{4}$ s N. E. qr.,

11. East $\frac{1}{4}$ - $\frac{1}{4}$ s S. E. qr.,

12. South $\frac{1}{4}$ - $\frac{1}{4}$ s S. E. qr.,

13. West $\frac{1}{4}$ - $\frac{1}{4}$ s S. E. qr.,

14. Center $\frac{1}{4}$ - $\frac{1}{4}$ s S. E. qr.,

15. South $\frac{1}{4}$ - $\frac{1}{4}$ s S. W. qr.,

16. West $\frac{1}{4}$ - $\frac{1}{4}$ s S. W. qr.,

17. Center $\frac{1}{4}$ - $\frac{1}{4}$ s S. W. qr.

LAKE GENEYA

164.8

221.4

221.4

819.5 Plat

692 Plat

22.5

615.6

718.5 on Plat

340.6

165

221.7

Cor. 2" W. of Post
Base of Post

E Side of Base
Taken as is

N

↑

Surveyed by Wm Child
C.S.

Recorded by Lloyd S. Jensen

Surveyed by Wm Child
CS.

Recorded by Lloyd S. Jensen
Feb. 21, 1934


NAMES OF SWORN ASSISTANTS

CHAINMEN

FLAGMEN

AXMEN

City of Lake Geneva

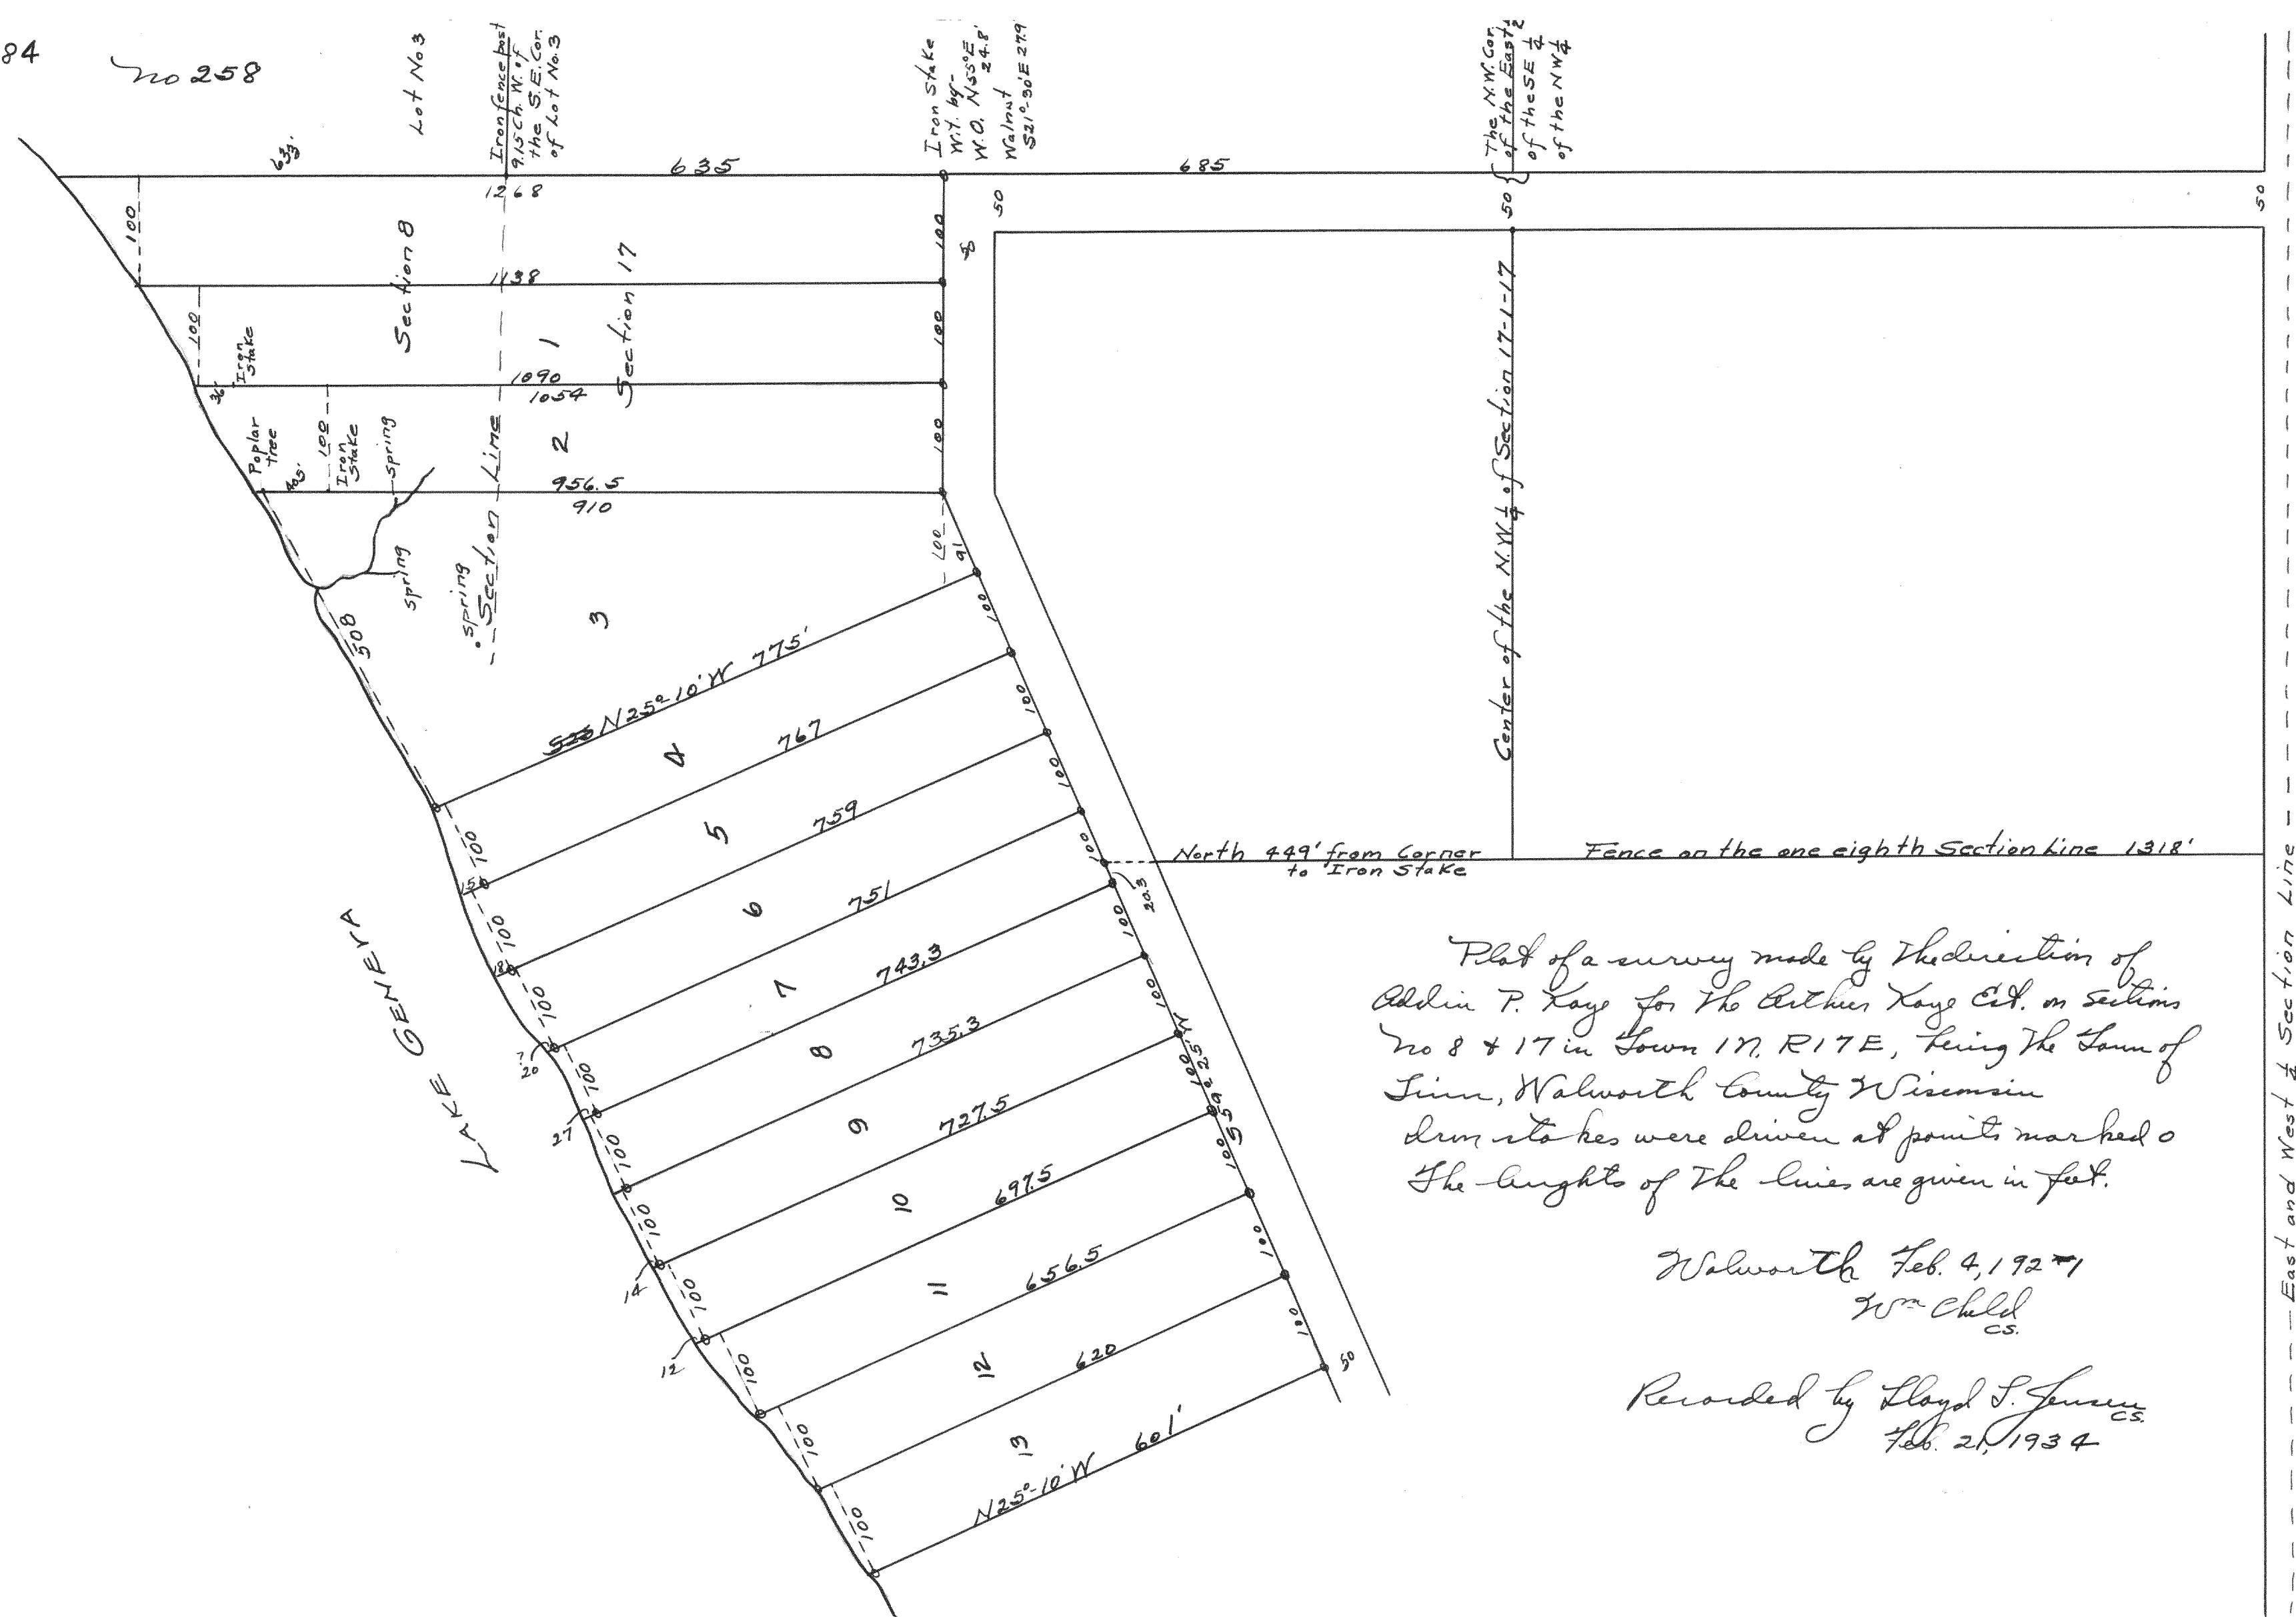

Plat of a survey made by the direction of
Addin P. Kays for the Arthur Kays Est. on sections
No 8 & 17 in Town 1 N. R 17 E, being the Town of
Linn, Walworth County Wisconsin
Iron stakes were driven at points marked o
The lengths of the lines are given in feet.

Waltham Feb. 4, 1927
Wm Child
C.S.

Recorded by Lloyd S. Jensen
Feb. 21, 1934