


no 262

Record of Survey.

18-1-17

Township....., North of Range.....of 4 Principal Meridian
as presented by the courses and distances on the following plat, and annexed field-notes of survey:
Established the center of the section at the point of intersection of STRAIGHT quarter lines.
Established all quarter-quarter corners upon the section boundary at proportional distances between known section and quarter section corners, according to the original field-notes of the Government survey.
Established all lost corners at proportionate distances between known corners according to the original field notes of the Government survey.

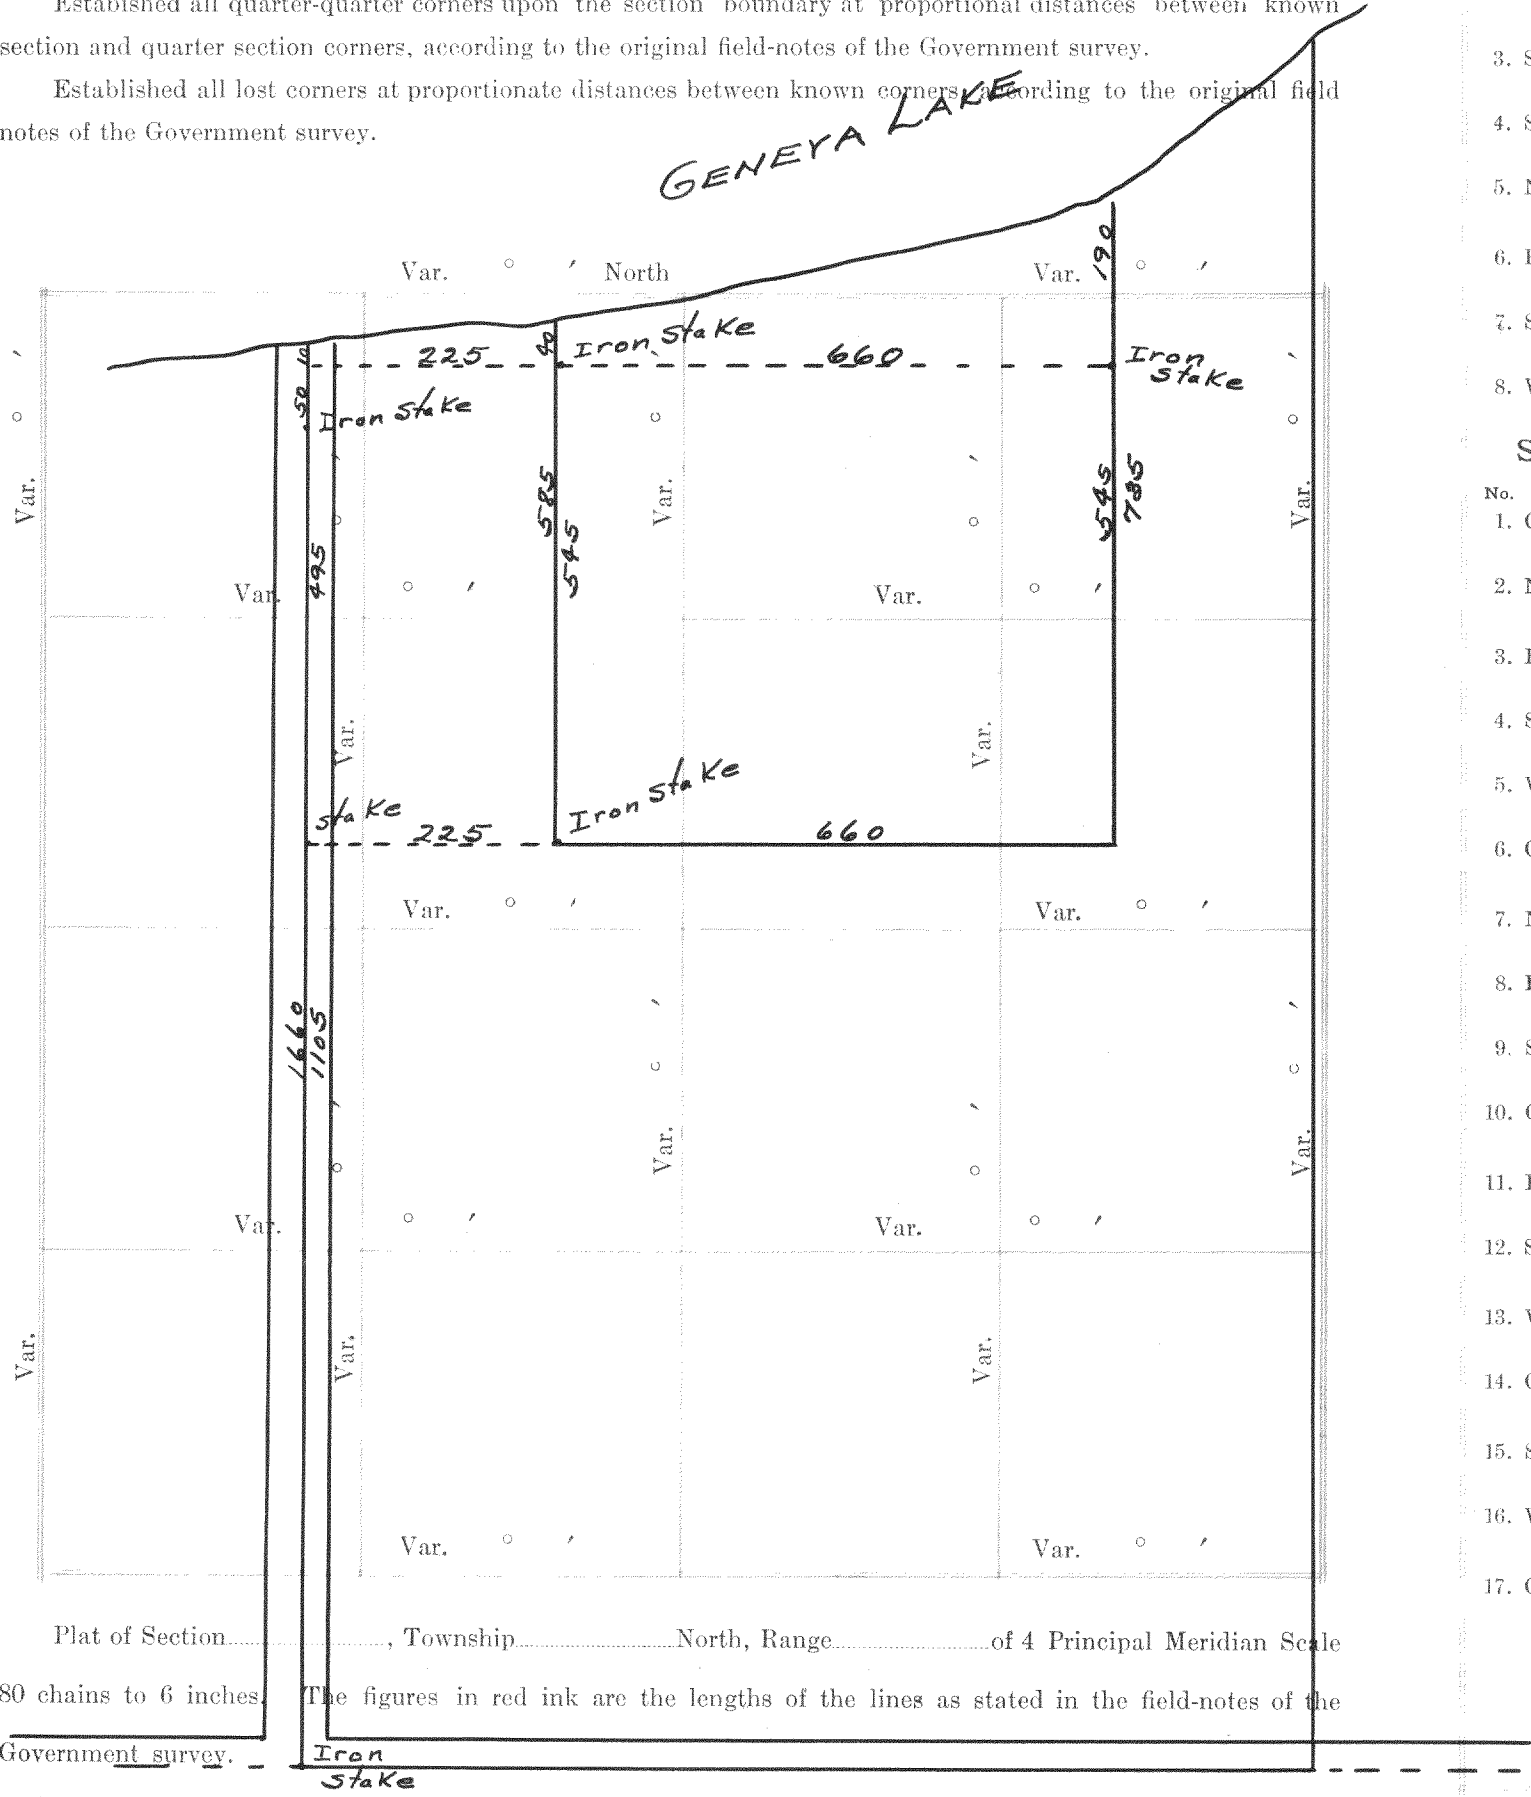

Plat of Section....., Township.....North, Range.....of 4 Principal Meridian Scale
80 chains to 6 inches. The figures in red ink are the lengths of the lines as stated in the field-notes of the
Government survey. Iron Stake

Declination of the Magnetic Meridian from the True Meridian.....
Surveyed and sub-divided.....A. D. 1, in accordance
with the State Laws and Instructions of the Commissioner of the General Land office, and recorded on pages
.....of Register in the County Clerk's office.

Witness my hand this.....day of.....A. D. 1
.....SURVEYOR.

DESCRIPTION

OF SECTION, QUARTER SECTION AND QUARTER QUARTER SECTION CORNERS

GOVERNMENT CORNERS				H. C. MILLER CO. MFG. STATIONERS, MILWAUKEE WISCONSIN								
No.	Bearing Trees	In. Dia.	Courses they bear	Links Distant	Bearing Trees	In. Dia.	Courses they bear	Links Distant	Bearing Trees	In. Dia.	Courses they bear	Links Distant
1.	N. W. Sec. Cor. identified,											
2.	N. E. Sec. Cor. identified,											
3.	S. E. Sec. Cor. identified,											
4.	S. W. Sec. Cor. identified,											
5.	N. 1/4 Sec. Cor. identified,											
6.	E. 1/4 Sec. Cor. identified,											
7.	S. 1/4 Sec. Cor. identified,											
8.	W. 1/4 Sec. Cor. identified,											
Subdivision Corners												
No.												
1.	Center 1/4 Sec. Cor.											
2.	North 1/4-1/4s N. W. qr.,											
3.	East 1/4-1/4s N. W. qr.,											
4.	South 1/4-1/4s N. W. qr.,											
5.	West 1/4-1/4s N. W. qr.,											
6.	Center 1/4-1/4s N. W. qr.,											
7.	North 1/4-1/4s N. E. qr.,											
8.	East 1/4-1/4s N. E. qr.,											
9.	South 1/4-1/4s N. E. qr.,											
10.	Center 1/4-1/4s N. E. qr.,											
11.	East 1/4-1/4s S. E. qr.,											
12.	South 1/4-1/4s S. E. qr.,											
13.	West 1/4-1/4s S. E. qr.,											
14.	Center 1/4-1/4s S. E. qr.,											
15.	South 1/4-1/4s S. W. qr.,											
16.	West 1/4-1/4s S. W. qr.,											
17.	Center 1/4-1/4s S. W. qr.											

This is to certify That This plat correctly represents The boundary of one certain 10 acres of land surveyed for the Northwestern Military Academy and located in the Northeast quarter of Section No. 18, in the Town of Linn, Walworth County, Wisconsin.
W. C. Childs.

Recorded by Lloyd J. Jensen
Feb. 21, 1934 cs.

NAMES OF SWORN ASSISTANTS			
CHAINMEN	FLAGMEN	AXMEN	

No. 263

11-2-15

Description of land as from survey.

All of the certain piece or parcel of land lying situate and being in the Town of Marion, Walworth County, Wisconsin, and more fully described as follows, to wit:-

Beginning at the Northeast corner of the Southeast quarter of Section Number Eleven (11), Town Number Two (2) North, Range Number Fifteen (15) East; Thence South on the East line of said quarter section 33.20 chains to the West end of one certain fence supposed to be the Southwest corner of lands formerly owned by one James and now owned by C. H. Barker, Thence $N 64^{\circ} 25' W$ 22.19 chains to one certain fence post, being the Southeast corner of lands deeded by C. M. Fuller to Thomas Ponder, Feb. 16, 1869, and which deed is on record in the Register of Deeds' office in and for said Walworth County, in Volume 46 of Deeds, on page 418, Thence North on the East line of lands so deeded being the one-eighth section line in the center of said quarter section 95 rods more or less to the one eighth section corner on the North line of the above mentioned quarter section, Thence East on said North line 20.07 chains to the place of beginning, containing 57 acres of land.

Surveyed by Wm Child
C.S.

Recorded by Lloyd S. Jensen
Feb. 23, 1934

No 264

27-2-15

Description of land as from survey

All of That certain piece or parcel of land lying and being in the Southwest quarter of Section 27-2-15, being the Town of Marion, Walworth County Wisconsin, described as follows to wit:-

Beginning at the point of intersection of the center line of the Chicago & Madison Road with the center line of the Milwaukee and Beloit Road;

Thence $S 59^{\circ} W$ along the center of said Mil. & Beloit Road 330' to the N.E. corner of the lot owned & occupied by Mr. O'Brien;

Thence $S 36^{\circ} E$ being along the line of fence on the Easterly side of said O'Brien's lot 304.5' to a fence post on the N. line of lands owned by H. S. Heyer

Thence $N 59^{\circ} E$ along the line of fence on the North line of said Heyer's land 197 feet to a fence post on the West line of the land of the John Eagle Estate; Thence $N 48^{\circ} W$ along the line of fence on the west line of the lands of said Estate 165.5' to a fence post;

Thence $N 42^{\circ} E$ 166 feet to the Southeast end of the Cement walk on the land being described and continuing on this line to the center of the said Chicago and Madison Road;

Thence $N 48^{\circ} W$ along the center of said road 90 feet more or less to the place of beginning; Containing 1.64 acres of land.

Surveyed by Wm Child
C.S.

Recorded by Lloyd S. Jensen
Feb. 23, 1934