


Record of Survey.

27-2-15

no 265

Township....., North of Range..... of 4 Principal Meridian
as presented by the courses and distances on the following plat, and annexed field-notes of survey:
Established the center of the section at the point of intersection of STRAIGHT quarter lines.
Established all quarter-quarter corners upon the section boundary at proportional distances between known section and quarter section corners, according to the original field-notes of the Government survey.
Established all lost corners at proportionate distances between known corners, according to the original field notes of the Government survey.

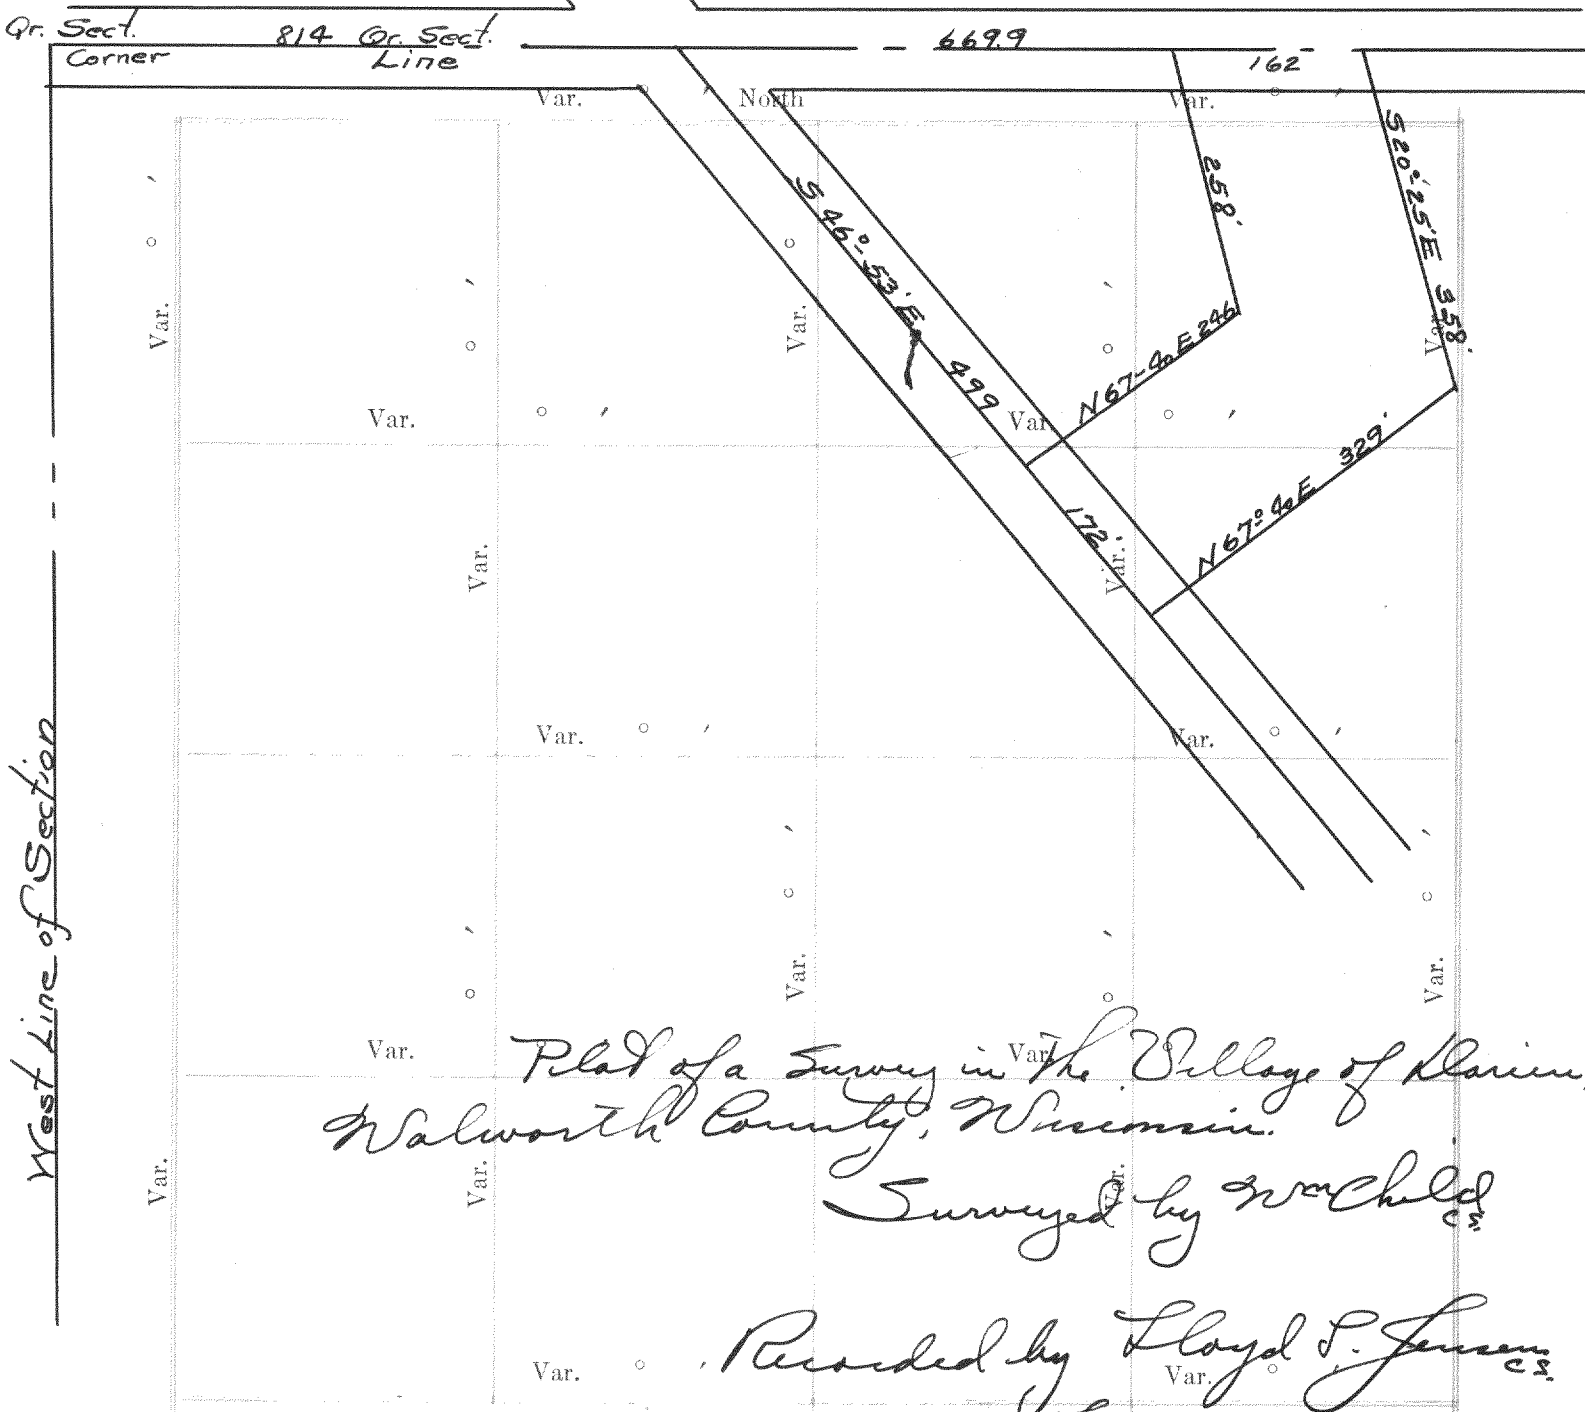

Plat of Section..... Township..... North, Range..... of 4 Principal Meridian Scale
80 chains to 6 inches. The figures in red ink are the lengths of the lines as stated in the field-notes of the
Government survey.
Declination of the Magnetic Meridian from the True Meridian.....
Surveyed and sub-divided..... A. D. 1 , in accordance
with the State Laws and Instructions of the Commissioner of the General Land office, and recorded on pages
..... of Register in the County Clerk's office.
Witness my hand this..... day of..... A. D. 1
..... SURVEYOR.

OF SECTION, QUARTER SECTION AND QUARTER QUARTER SECTION CORNERS

GOVERNMENT CORNERS				H. C. MILLER CO., MFG. STATIONERS, MILWAUKEE X15000				
No.	Bearing	In.	Courses	Links	Bearing	In.	Courses	Links
1.	N. W. Sec. Cor. identified,							
2.	N. E. Sec. Cor. identified,							
3.	S. E. Sec. Cor. identified,							
4.	S. W. Sec. Cor. identified,							
5.	N. 1/4 Sec. Cor. identified,							
6.	E. 1/4 Sec. Cor. identified,							
7.	S. 1/4 Sec. Cor. identified,							
8.	W. 1/4 Sec. Cor. identified,							
Subdivision Corners								
1.	Center 1/4 Sec. Cor.							
2.	North 1/4-1/4 S. W. qr.							
3.	East 1/4-1/4 S. W. qr.							
4.	South 1/4-1/4 S. W. qr.							
5.	West 1/4-1/4 S. W. qr.							
6.	Center 1/4-1/4 S. W. qr.							
7.	North 1/4-1/4 S. E. qr.							
8.	East 1/4-1/4 S. E. qr.							
9.	South 1/4-1/4 S. E. qr.							
10.	Center 1/4-1/4 S. E. qr.							
11.	East 1/4-1/4 S. E. qr.							
12.	South 1/4-1/4 S. E. qr.							
13.	West 1/4-1/4 S. E. qr.							
14.	Center 1/4-1/4 S. E. qr.							
15.	South 1/4-1/4 S. W. qr.							
16.	West 1/4-1/4 S. W. qr.							
17.	Center 1/4-1/4 S. W. qr.							

27-2-15

Description of Site Prop. from Survey.

That certain piece or parcel of land in the northeast quarter of Section 27, T2N, R15E, being the Town of Klavien, Walworth Co., Wisconsin, and described as follows to wit:— Beginning at an iron stake on the northwesterly side or end of lot 6, in blk. no 12 of Stone & Toppings Add. to The Village of Klavien, 3.3 (equalling 5 lks.) S 62° W from the NE corner of said lot, and being the point mentioned in previous deeds as being 5 lks. southwesterly from the Northwest corner of lot 5; Thence north 237 feet to an iron stake, Thence N 66° E 305' to an iron stake and 376' to a point in the pond; Thence north 200' to an iron stake and 525' to the East side of a large fence post in line of one certain fence running E & W, Thence east along the line of said fence 404.6 feet to a large fence post in the line of one certain fence running South; Thence South along the line of said fence 580' to an iron stake & 747' to a pt. in the pond; Thence South 62° W 115' to an iron stake and 270' to an iron stake on the N easterly line of 4th Ave. in said Add.; Thence N 28° W 198' (3 chains) to an iron stake at the most northwesterly or northwesterly corner of said plat; Thence S 62° W along the northwesterly line of said plat 465.3 (7.05 chains) to the place of beginning, containing 9 acres of land.

to 1, 2, 3, 4, 5, & 10, with the street adjoining, containing 1.75 acres.

No. 266 Description of Title Prop. from Survey.
That certain piece or parcel of land in the northeast quarter of Section 27, T2N, R15E, being the Town of Marion, Walworth Co., Wisconsin, and described as follows to wit: Beginning at an iron stake on the northwesterly side or end of lot 6, in blk. no 12 of Stone & Thompson's Add. to The Village of Marion, 3.3 (equaling 5 lks.) S 62° W from the NE corner of said lot, and being the point continued in previous deeds as being 5 lks. southwesterly from the Northwest corner of lot 5; Thence north 237 feet to an iron stake, Thence N 66° E 305' to an iron stake and 376' to a point in the pond; Thence north 200' to an iron stake and 525' to the East side of a large fence post in line of one certain fence running E & W; Thence east along the line of said fence 404.6 feet to a large fence post in the line of one certain fence running South; Thence South along the line of said fence 580' to an iron stake & 747' to a pt. in the pond; Thence South 62° W 115' to an iron stake and 270' to an iron stake on the N easterly line of 4th Ave. in said Add.; Thence N 28° W 198' (3 chains) to an iron stake at the most northerly or northeasterly corner of said plat; Thence S 62° W along the northwesterly line of said plat 465.3 (7.05 chains) to the place of beginning, containing 9 acres of land.
to 1, 2, 3, 4, 5, & 10, with the street adjoining, containing 1.75 acres.

Surveyed by Wm Childs

NAMES OF SWORN ASSISTANTS

CHAINMEN

FLAGMEN

Recorded by Lloyd P. Jensen
Feb. 23, 1934

No. 267

Delavan City

Blk. 3 of T.A.D. Subd.

Wm Braken, Charles Page & others

At S.W. corner find iron stake and 132 + 179.5
North iron stakes. From Southwest corner
East 133 iron stake and 66.5 more remains
of wood stake and drove iron stake.

133' more small stake at corner

133 West of Southeast and 132 North find iron
stake 165 set iron stake Southwest of Blk
and on this line on North of Blk.

Surveyed by Wm Child^{C.S.}

Recorded by Lloyd S. Jensen^{C.S.}
Feb. 23, 1934

No 268

Blk. 12, Delavan City

Mrs. Chubb

From Southwest corner of Opera House South
16.5 to pt. 6" South of North end of cement walk.
Then South 498' found stake hole for S.W. of
Blk. 13 1/2' E + 12" N. of walks, at 142.28 being
2/3 of distance make pt. for N.W. corner of lot 17,
Being 8" S. of seam in walk and 6" on walk, at
284.56 make pt. for southwest corner of lot 20,
2 1/2" E. of walk and 16" S. of seam in walk, on E.
of Blk. find iron stake for N.E. corner of lot 18
in a former survey, ran line from this West
332.8' to N.W. of 17 set iron stake at 166.4
from corners and on North side of fence post, find
iron stake 8' S. on S. of post, along E. of Blk.
from NE of 18, S. 213.4 find iron stake set
by former survey for S.E. corner of 22 and
142.2 more find stake set for corner of Blk. 16.5"
N. and 7" W. of walks, from stake set for NE of
17 S. 142.28 and set iron stake for S.E. of 20,
Being in line of fence S. and 166.4 E. of
West line

Surveyed by Wm Child^{C.S.}
Sept. 6, 1914

Recorded by Lloyd S. Jensen^{C.S.}
Feb. 23, 1934