

DESCRIPTION

Record of Survey.

No 277

Township..... North of Range..... of 4 Principal Meridian


as presented by the courses and distances on the following plat, and annexed field-notes of survey:

Established the center of the section at the point of intersection of STRAIGHT quarter lines.

Established all quarter-quarter corners upon the section boundary at proportional distances between known section and quarter section corners, according to the original field-notes of the Government survey.

Established all lost corners at proportionate distances between known corners, according to the original field notes of the Government survey.

Plat line of Wisconsin as used by Rail-
road surveyors and as used in Converse Sub. Plat
line of East side of Larnards Subdivision and set
stake where center of Wisconsin Street crosses.
along center of street, from iron stake on west of
Converse Subdivision to this stake is 132 feet
for Angel and 165 for Heiss and 39 inches,
give Heiss 21.7' Angel 17.3' and set stake in line
of fence. From East side lay off 3 lots on each
side of street first 2 on E are 55 each and last
one is 56.7.

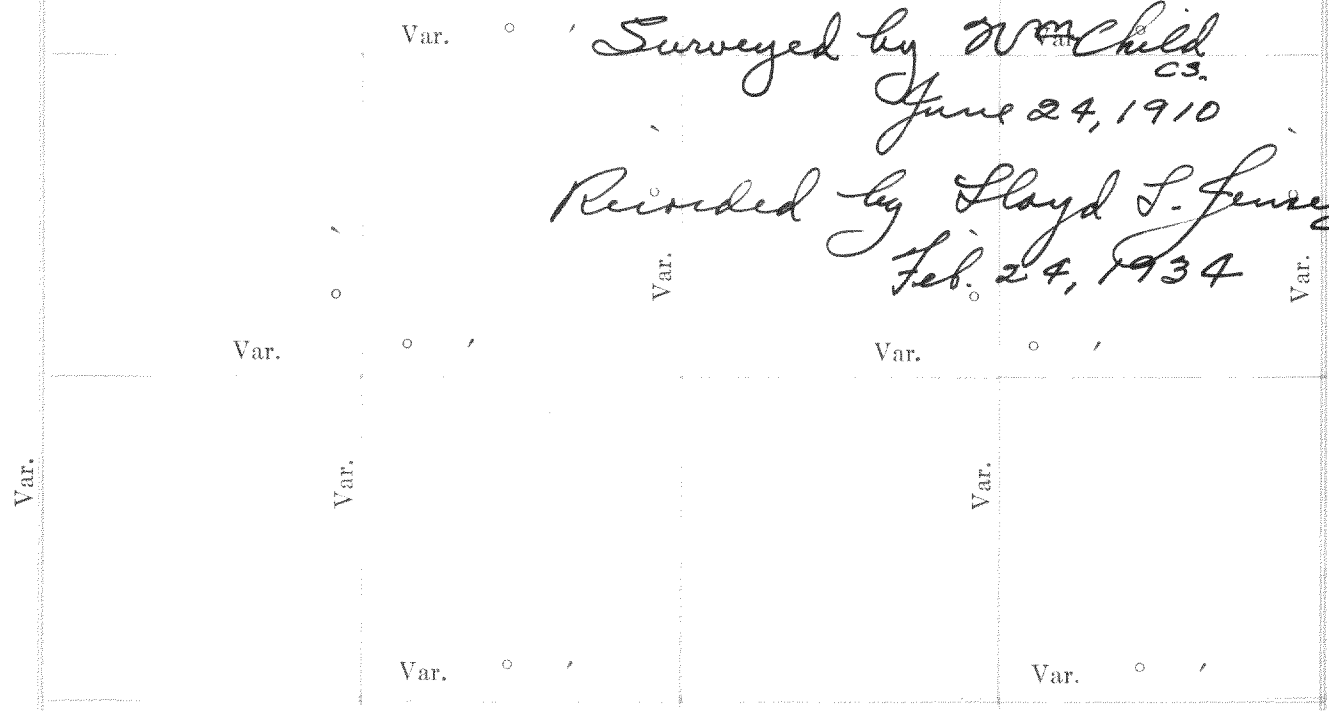

Plat of Section....., Township..... North, Range..... of 4 Principal Meridian Scale

80 chains to 6 inches. The figures in red ink are the lengths of the lines as stated in the field-notes of the Government survey.

Declination of the Magnetic Meridian from the True Meridian.....

Surveyed and sub-divided..... A. D. 1....., in accordance

with the State Laws and Instructions of the Commissioner of the General Land office, and recorded on pages

..... of Register in the County Clerk's office.

Witness my hand this..... day of..... A. D. 1.....

..... SURVEYOR.

OF SECTION, QUARTER SECTION AND QUARTER QUARTER SECTION CORNERS

H. C. MILLER CO. MFG. STATIONERS, MILWAUKEE X15000															
GOVERNMENT CORNERS				Bearing	In.	Courses	Links	Bearing	In.	Courses	Links	Bearing	In.	Courses	Links
				Trees	Dia.	they bear	Distant	Trees	Dia.	they bear	Distant	Trees	Dia.	they bear	Distant
No.															
1.	N. W. Sec. Cor. identified,				No. 278										
2.	N. E. Sec. Cor. identified,														
3.	S. E. Sec. Cor. identified,														
4.	S. W. Sec. Cor. identified,														
5.	N. 1/4 Sec. Cor. identified,														
6.	E. 1/4 Sec. Cor. identified,														
7.	S. 1/4 Sec. Cor. identified,														
8.	W. 1/4 Sec. Cor. identified,														
Subdivision Corners															
No.															
1.	Center 1/4 Sec. Cor. identified,														
2.	North 1/4 Sec. W. qr.,														
3.	East 1/4 Sec. N. qr.,														
4.	South 1/4 Sec. N. qr.,														
5.	West 1/4 Sec. N. qr.,														
6.	Center 1/4 Sec. N. qr.,														
7.	North 1/4 Sec. N. qr.,														
8.	East 1/4 Sec. E. qr.,														
9.	South 1/4 Sec. E. qr.,														
10.	Center 1/4 Sec. E. qr.,														
11.	East 1/4 Sec. S. qr.,														
12.	South 1/4 Sec. S. qr.,														
13.	West 1/4 Sec. S. qr.,														
14.	Center 1/4 Sec. S. qr.,														
15.	South 1/4-1/4 S. W. qr.,														
16.	West 1/4-1/4 S. W. qr.,														
17.	Center 1/4-1/4 S. W. qr.,														

Certificate of Survey
I do hereby certify That I did on The 5th day of May, 1911, and by The direction of C. P. Von Suessemle, City Attorney for The City of Milwaukee, Walworth County, Wisconsin, make a survey of a certain piece of land to be used as a street and a description of which is as follows, to-wit:-
Beginning at a stake at The Southeast corner of Lot 10 of the Plot of Katie A. Lathrop's 2nd Add. to The Village of Milwaukee, Thence East on a line which line is The northerly line of Lots 8, 9 & 10 of said addition parcel unto Lot 4 of J. B. Dwendorfs Add. to said Village 169 feet more or less to The East line of said Lot 4, thence The West line of Eighth Street, Thence South along The West line of said street and The East line of Lots 4 & 5, 64 feet. Thence West parallel with and 64 feet South of The above mentioned line running East through said Lot 4 169 feet more or less to The West line of said Lot 5, being also The East line of said Katie A. Lathrop's Addition, Thence North on The West line of said Lots 5 & 4, 64 feet to The place of beginning, taking a strip of land about 21 feet in width off from The South side of said Lot 4 and a strip about 43 feet in width off from The North side of Lot 5 aforesaid.
Wm Child
cs.
May 12, 1911

No. 278

Certificate of Survey

I do hereby certify that I did on the 5th day of May, 1911, and by the direction of C. S. Van Swearingen, City Attorney for the City of Delavan, Walworth County, Wisconsin, make a survey of a certain piece of land to be used as a street and a description of which is as follows, to-wit: Beginning at a stake at the Southeast corner of Lot 10 of the Plat of Katie A. Lothrop's 2nd Add. to the Village of Delavan, Thence East on a line which line is the most Southerly line of Lots 8, 9 & 10 of said addition produced into Lot 4 of J. B. Ilwendorfs Add. to said Village 169 feet more or less to the East line of said Lot 4, being the West line of Eighth Street, Thence South along the West line of said street and the East line of Lots 4 and 5, 64 feet. Thence West parallel with and 64 feet South of the above mentioned line running East through said Lot 4 169 feet more or less to the West line of said Lot five, being also the East line of said Katie A. Lothrop's Addition, Thence North on the West line of said Lots 5 & 4, 64 feet to the place of beginning, taking a strip of land about 21 feet in width off from the South side of said Lot 4 and a strip about 43 feet in width off from the North side of Lot 5 aforesaid

Wm Child Es.

May 12, 1911

Recorded by Lloyd S. Jensen Es. Feb. 24, 1934

NAMES OF SWORN ASSISTANTS

CHAINMEN

FLAGMEN

AXMEN

no. 279

Shelovan City

Description from Survey

Beginning at a stake on the Southeastern side of Racine Street which is $N 56^{\circ} - 6' E$ 6.38 chains from the intersection of the one-eighth section line running north and south through the Northwest $\frac{1}{4}$ of Section 17-2-16, and said point of beginning being also the northwestern corner of one certain piece or parcel of land conveyed by the party of the first part to F. A. Smithwick by deed dated November 8, 1912, and recorded in the Register of Deeds office in and for said County in Vol. 135 of deeds, on page 200; Thence $S 33^{\circ} - 54' E$ along the line of lands so conveyed 216'; Thence $S 56^{\circ} - 06' W$ 66' to the lands of Austin; Thence $N 33^{\circ} - 54' W$ along said Austin's line 216 feet to the Southeastern line of said Racine Street; Thence $N 56^{\circ} - 06' E$ 66' to the place of beginning.

Surveyed by Wm Child _{CS}Recorded by Lloyd S. Jensen _{CS}
Feb. 24, 1934

no 280

Shelovan City

"Katie A. Lathrop's 2nd Addl."

I William Child, County Surveyor of Walworth County, Wisconsin, do hereby certify that I have on the Sixteenth day of November, 1904, made a resurvey of a portion of "Katie A. Lathrop's Second Addition to the Village (now City) of Shelovan", and find that the line as established on the land by a fence and stakes, and which line has always been supposed to be the north line of lands conveyed by Ann Mary Phillips to Owen Griffen December 28, 1883, and afterward conveyed by Owen Griffen to Mary Griffen on April 29, 1904, is the same line as recognized by Mr. Tubbs, the surveyor who on the 18th day of December, 1894, surveyed and platted "Katie A. Lathrop's Second Addition as above mentioned"

William Child _{CS}Recorded by Lloyd S. Jensen _{CS}
Feb. 24, 1934