



#1572

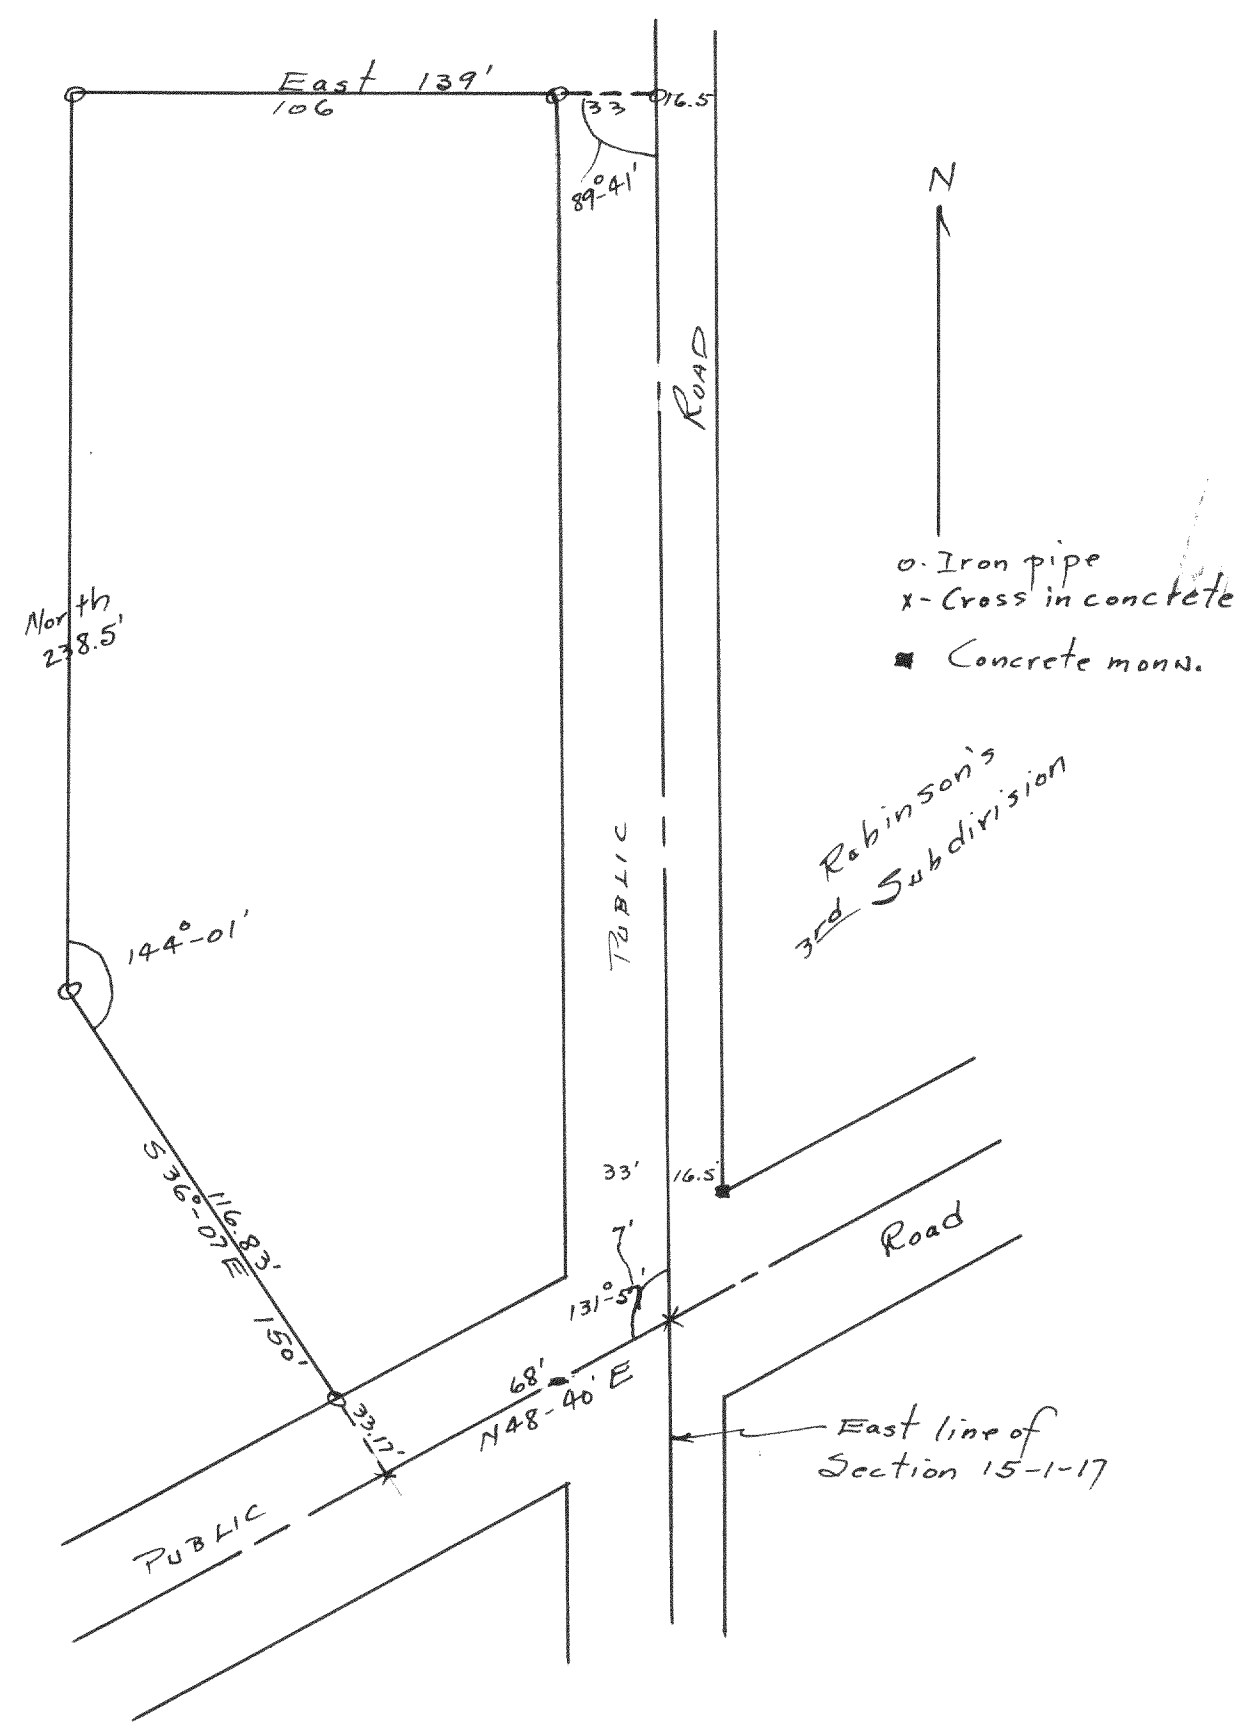


Plot of survey of land owned by Mary H. Betts located in the NE 1/4 of Section 15, T17N R17E.
 Floyd S. Jensen
 County Surveyor
 March 21, 1945

#1573

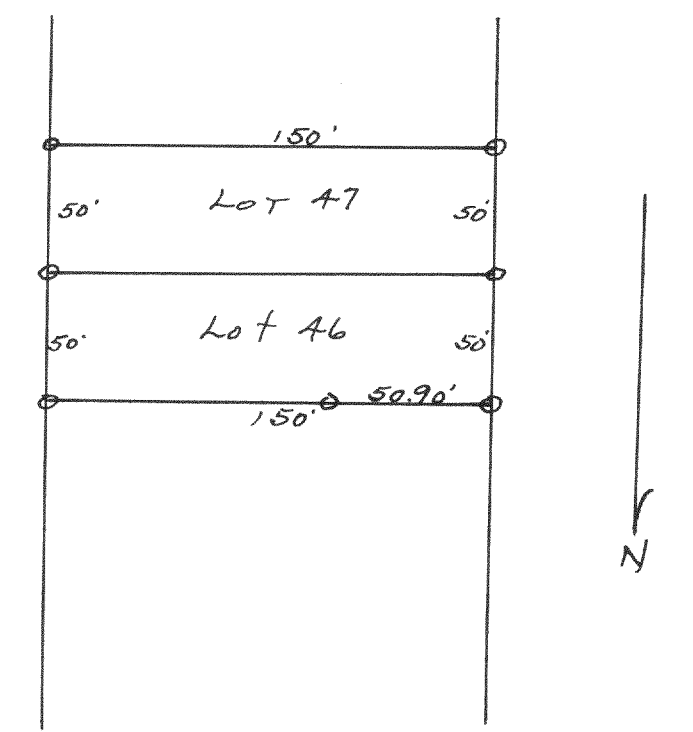

Plot of survey of Lots 46 and 47 of Lake Geneva Beach Subd., Section 11, T17N R17E.
 Nov. 1945
 Floyd S. Jensen
 County Surveyor

#1574

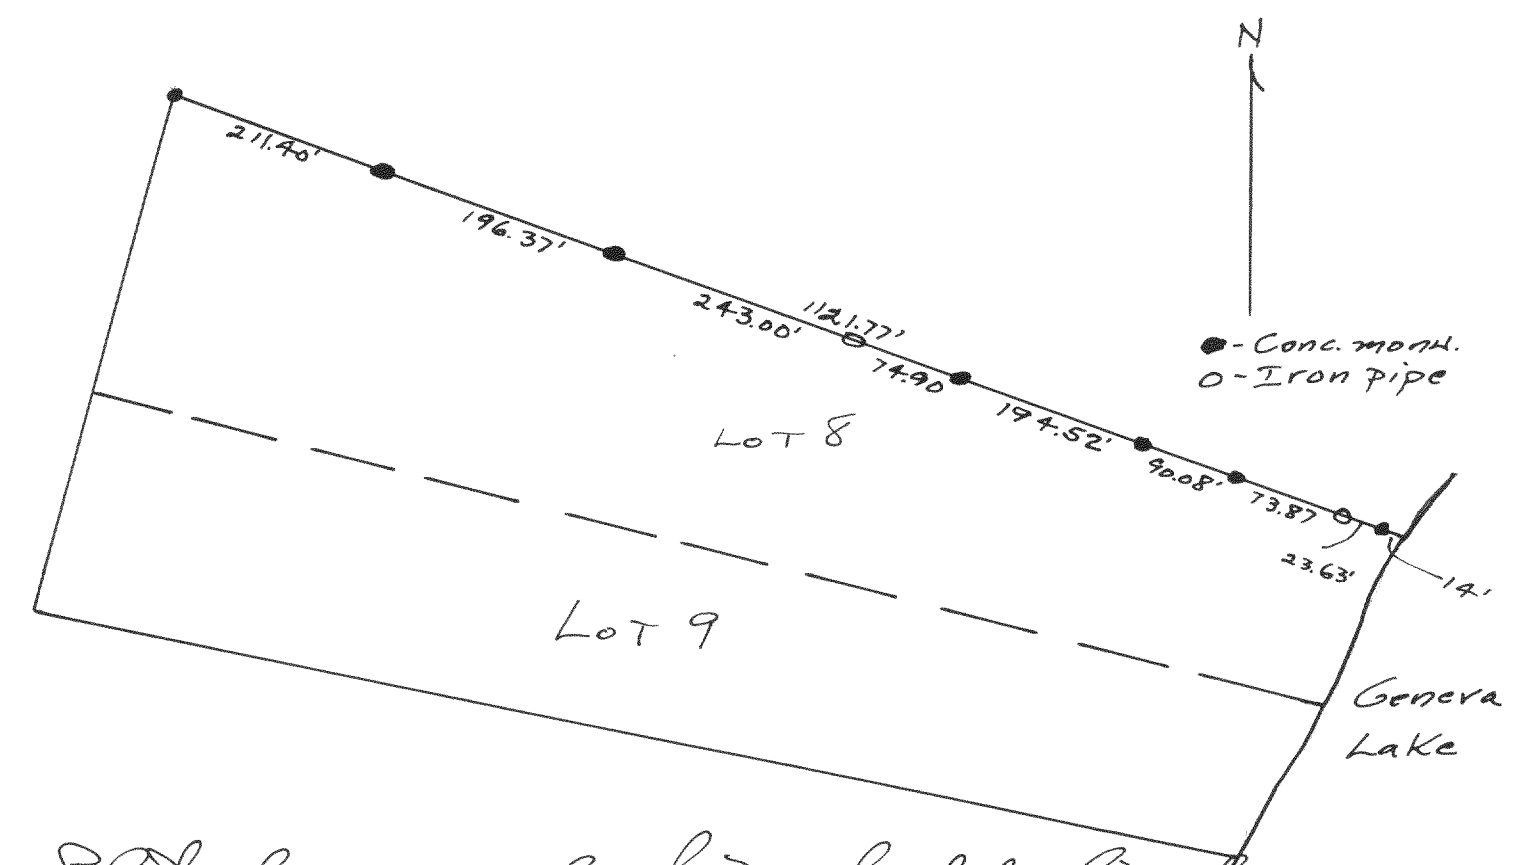

Plot of survey of the northeastern line of Lot 8 - Bk. 1, of Rowena Park Subdivision.
 Nov. 8, 1945
 Floyd S. Jensen
 County Surveyor