


#1594

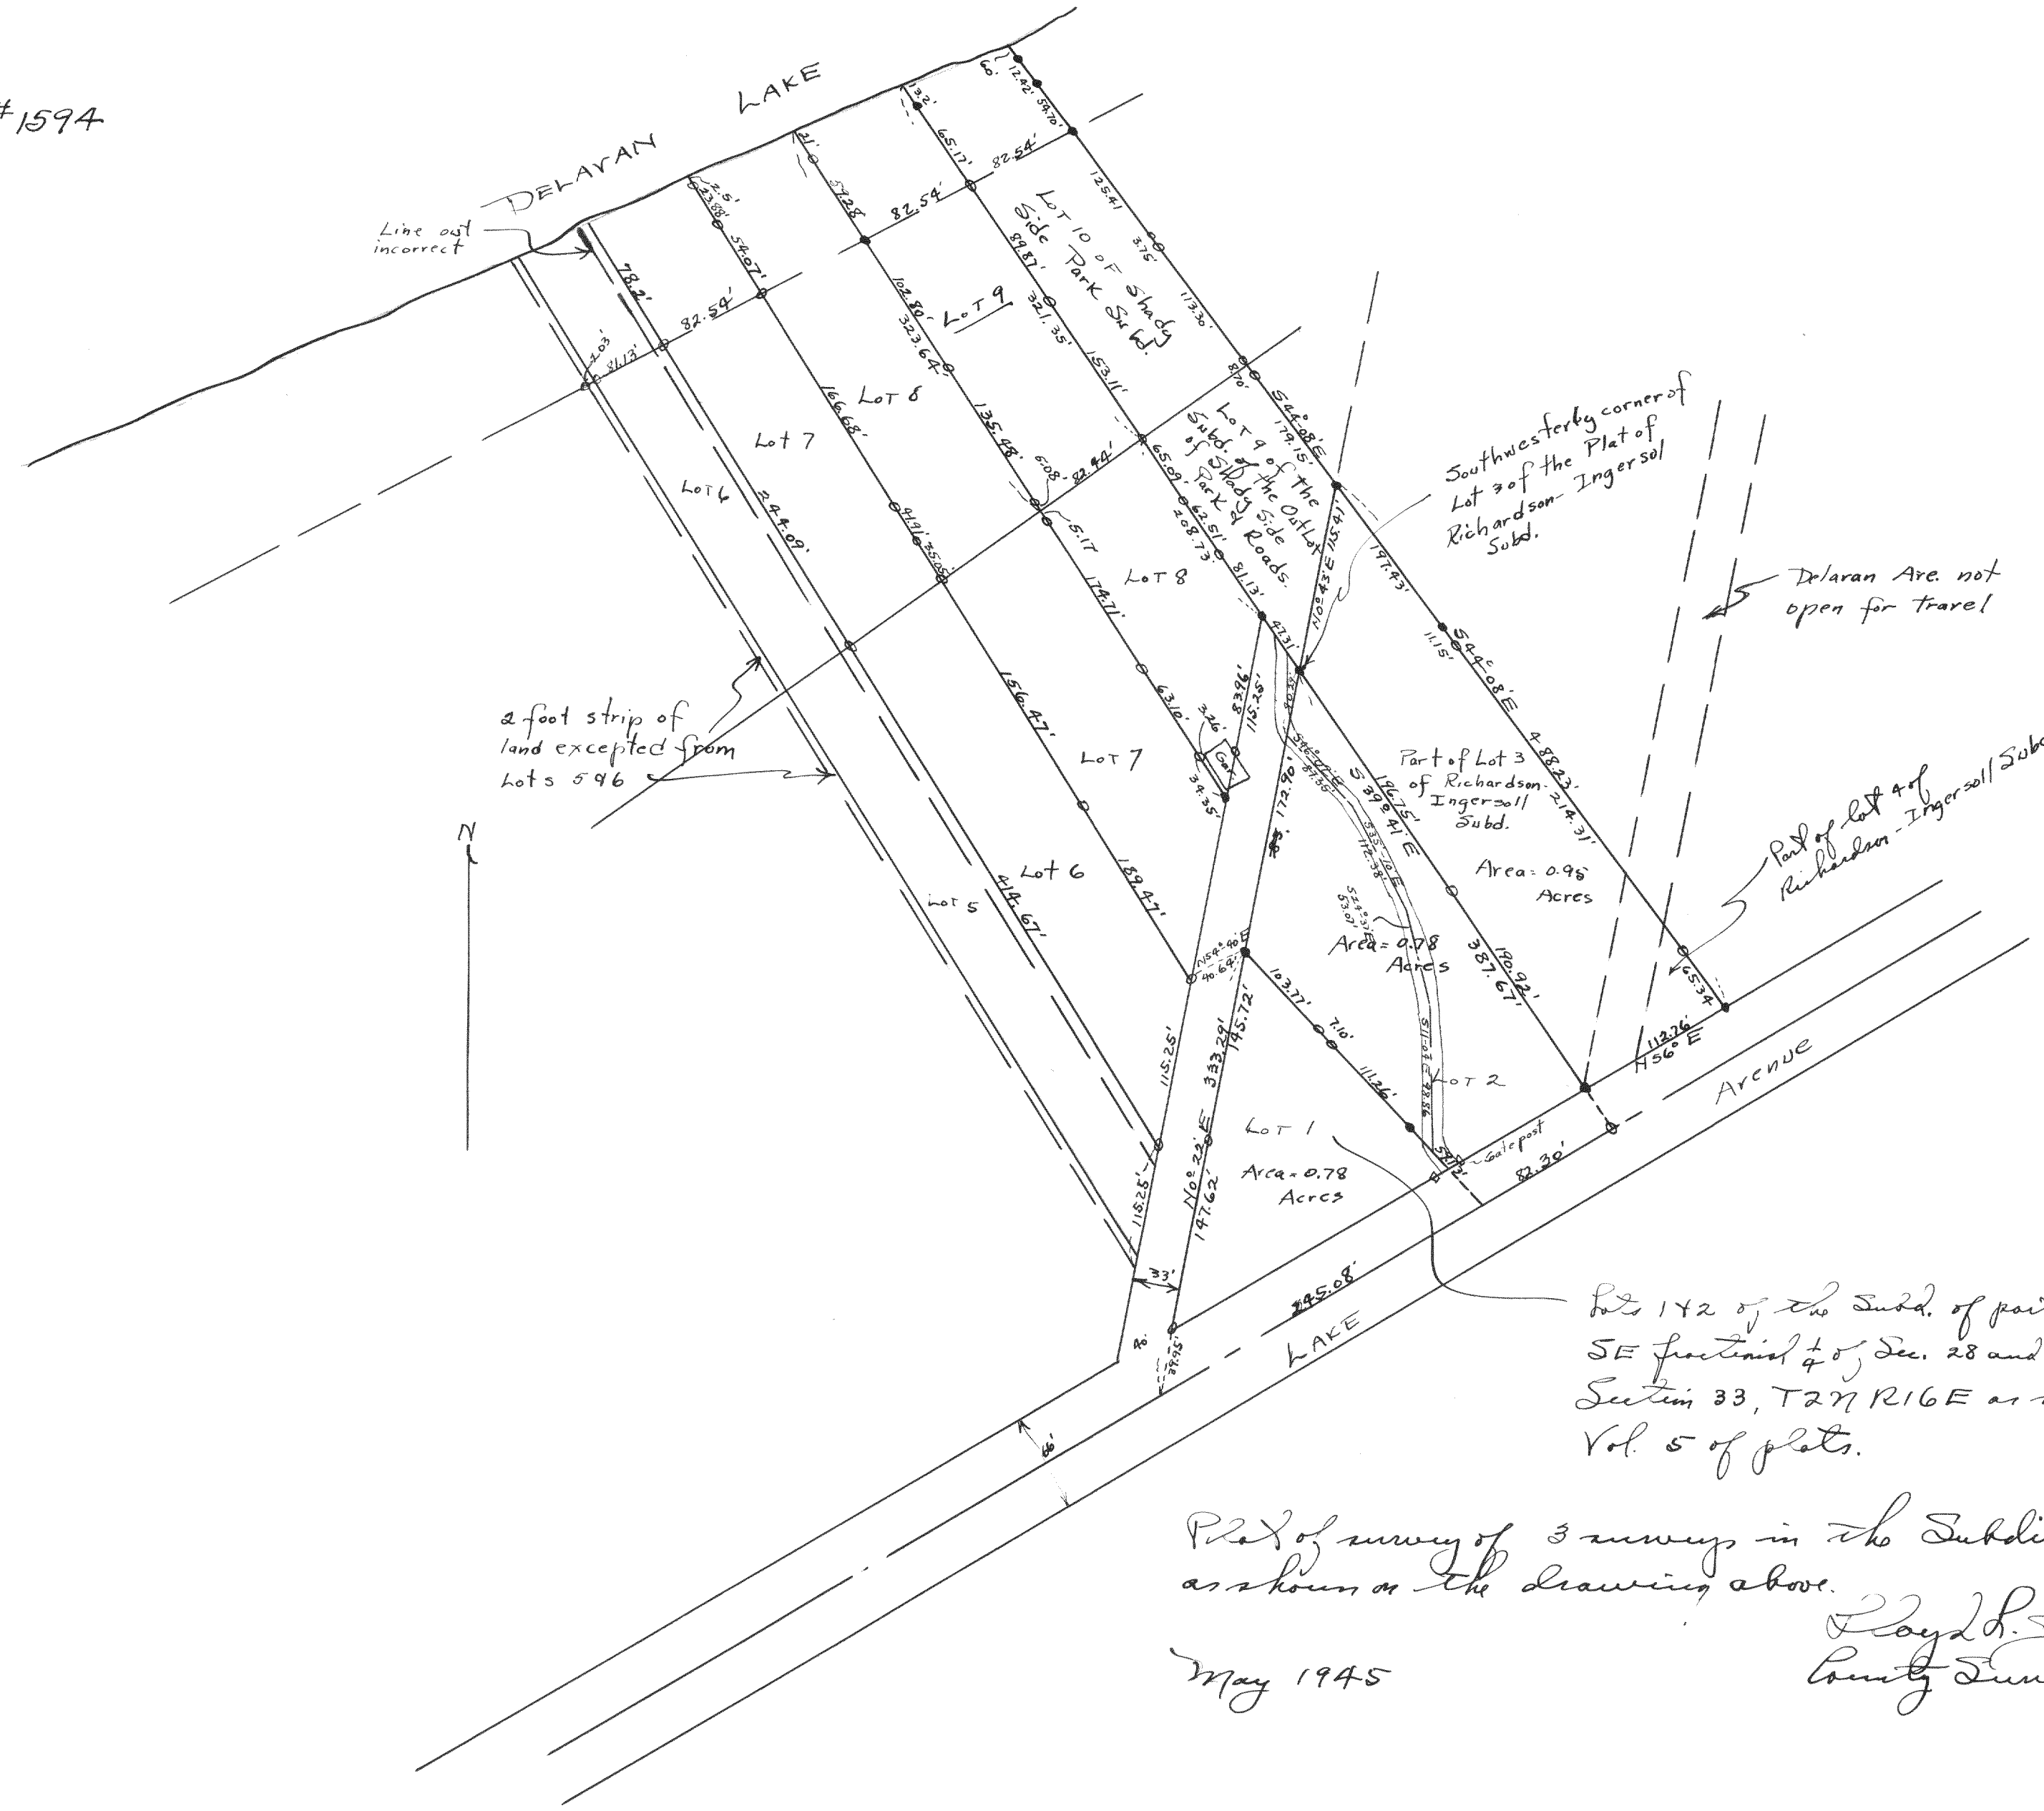

Lots 1 & 2 of the Subd. of part of Plat 14 in "Map of the SE fractional 1/4 of Sec. 28 and the NE fractional 1/4 of Section 33, T27N R16E as shown on page 300 of Vol. 5 of plats.

Plat of survey of 3 surveys in the Subdivisions as shown on the drawing above.

May 1945

Lloyd S. Jensen
County Surveyor