



#1725

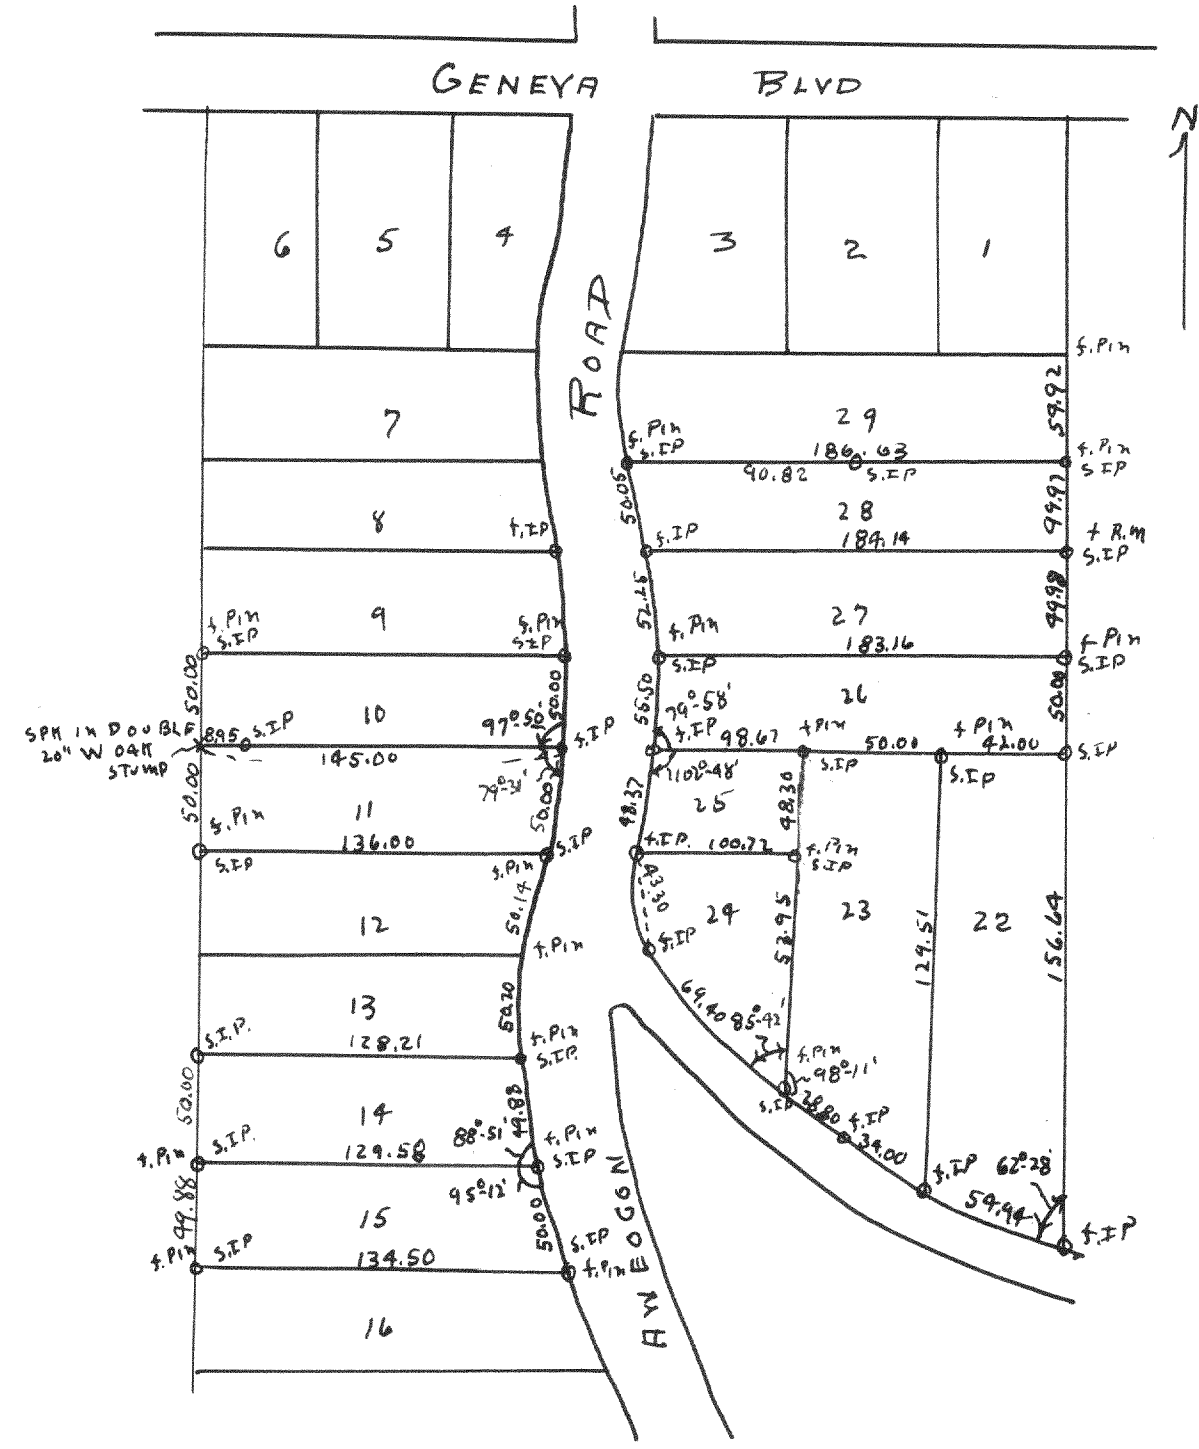

Plat of survey of lots 10, 11, 14, 15, 22-28 of Block 6 Indian Hills in Fontana, Malwaith County, Wisconsin
 Dec. 1947

Lloyd S. Jensen
 County Surveyor
[Signature]

1726

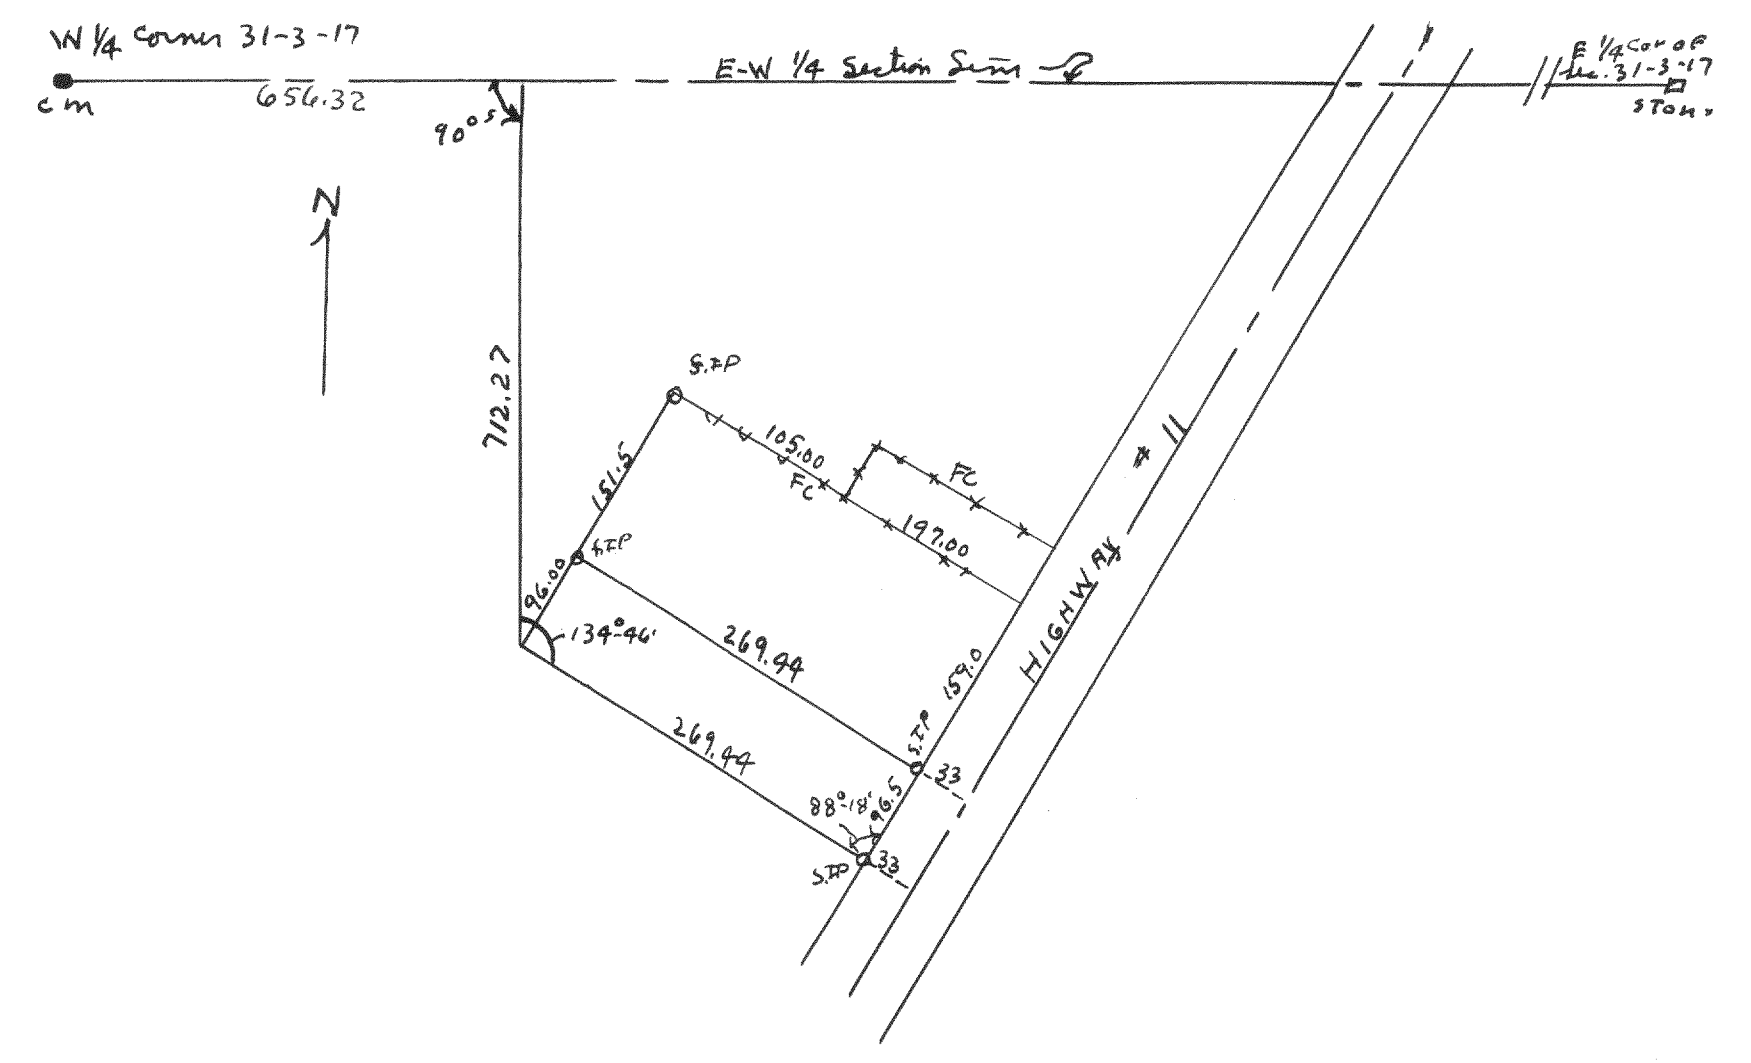

Plat of survey of parcel of land owned by F. Stearns and located in the city of Elkhorn, Malwaith County Wisconsin

Dec 10, 1947

Lloyd S. Jensen
 County Surveyor
[Signature]