



390

# 1949

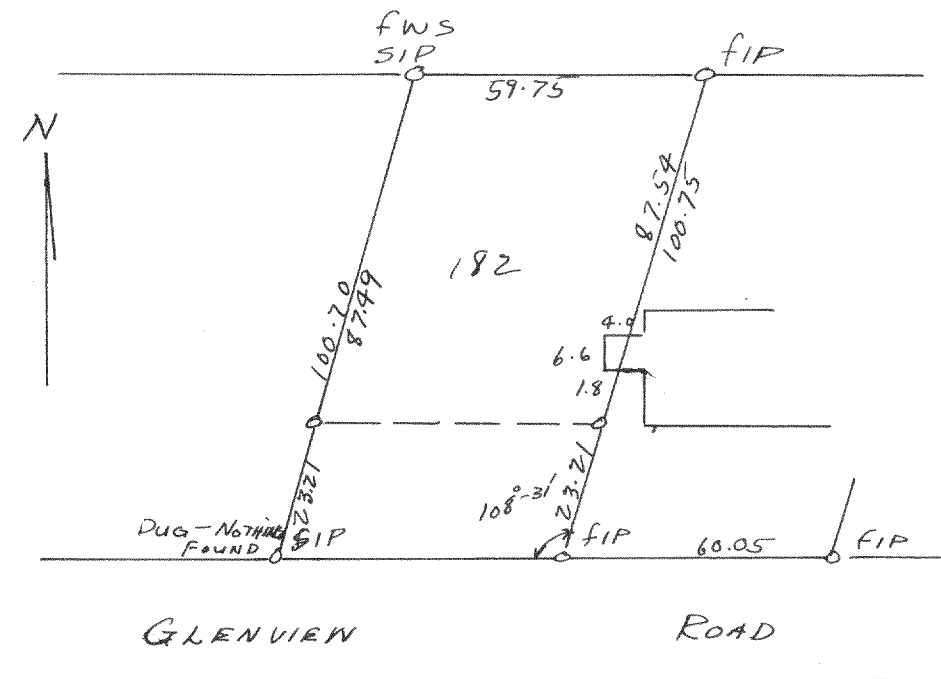


Plot of survey of lot 182 Cedar Point Park 2<sup>nd</sup> Addition  
 Village of Williams Bay Walworth County  
 Aug. 1948  
 Lloyd L. Jensen  
 CWS

# 1950

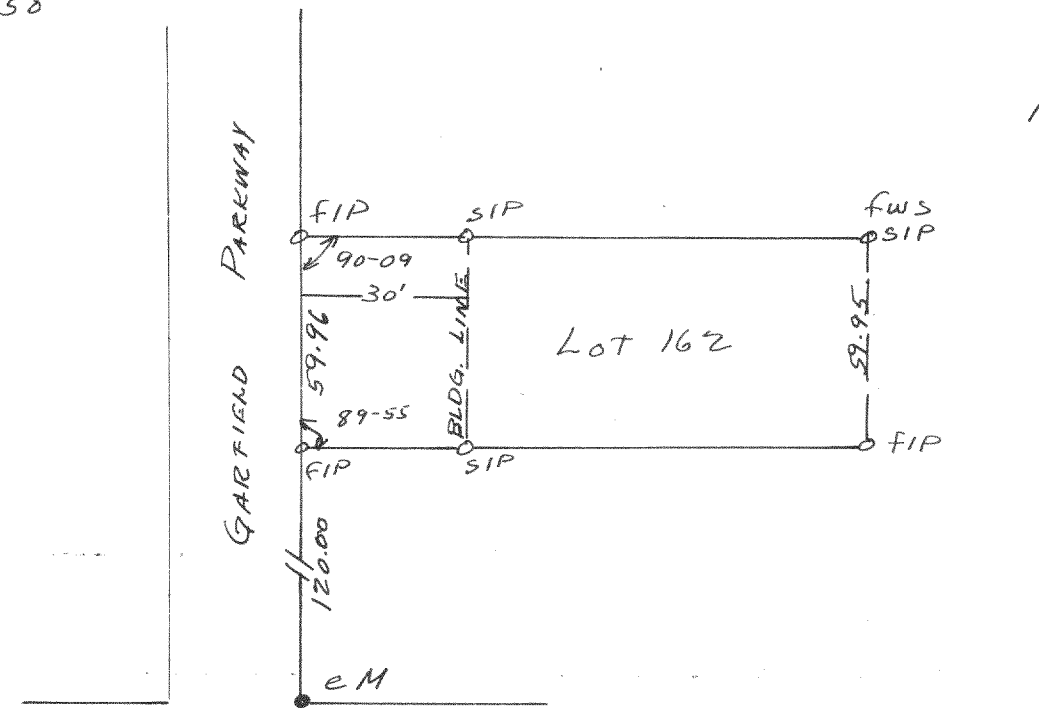


Plot of survey of Lot 162 Cedar Point Park Subdivision  
 Village of Williams Bay Walworth County  
 Aug 1948  
 Lloyd L. Jensen  
 CWS

# 1951

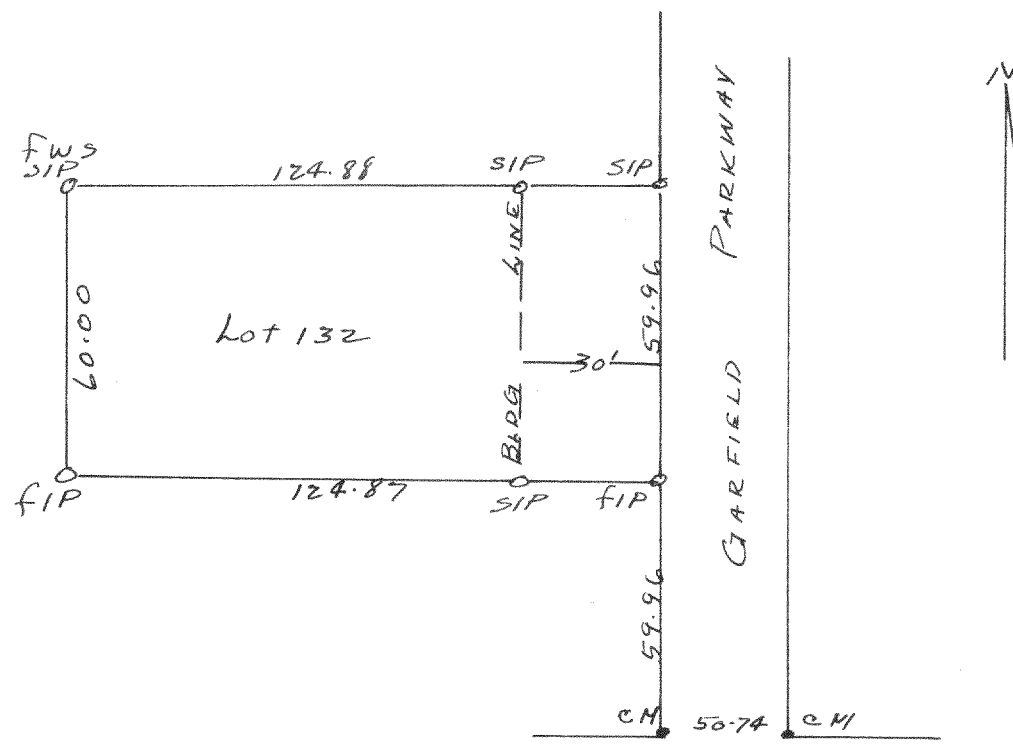

Plot of survey of lot 132 Cedar Point Park Subdivision  
 in the Village of Williams Bay Walworth County  
 Aug 1948

# 1953

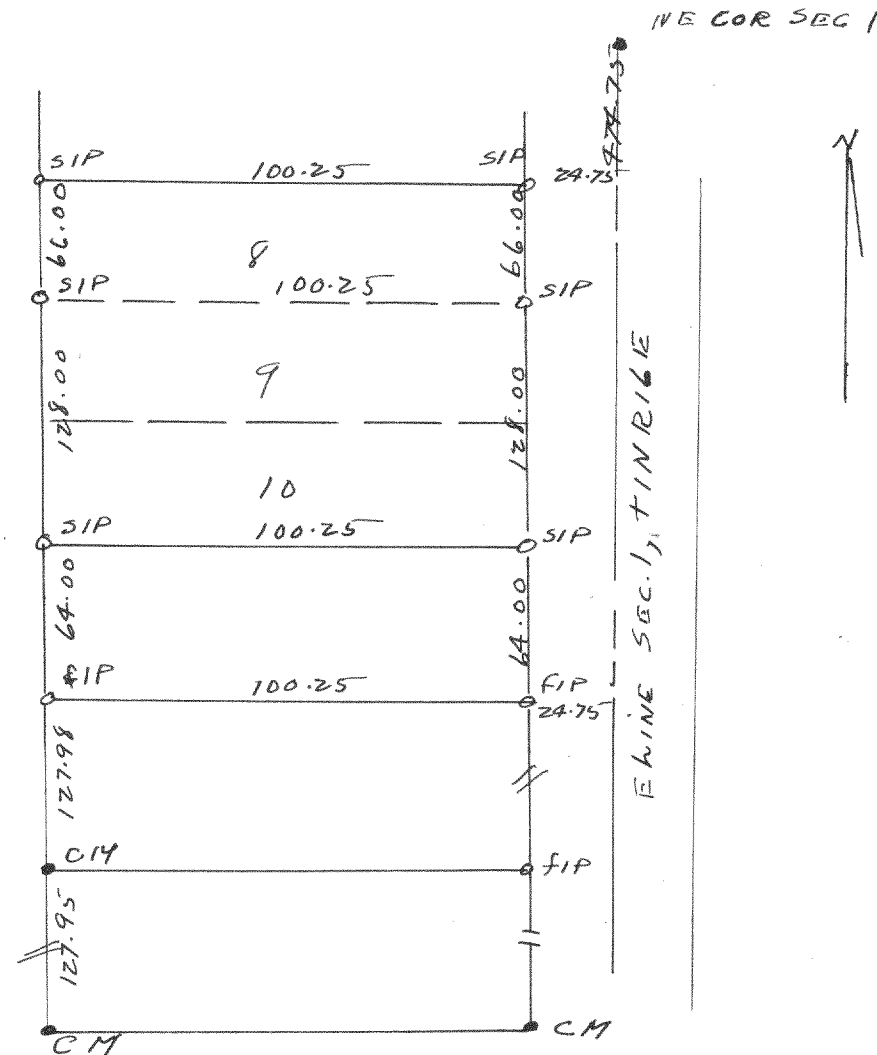

Plot of survey of lots 8, 9, 10 of William H. Frances Subdivision  
 in Village of Williams Bay, Walworth County  
 Aug 1948  
 Lloyd L. Jensen  
 CWS