



#2180

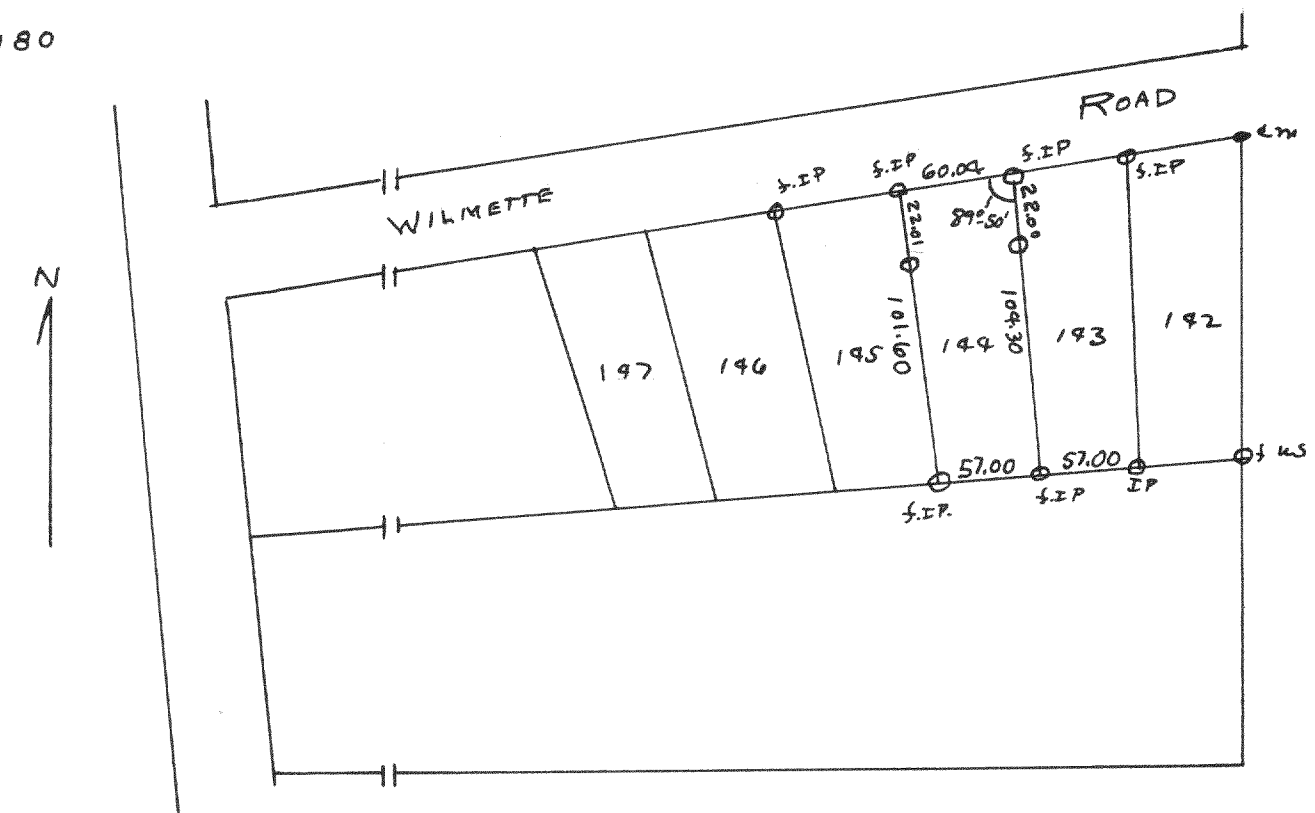


Plot of survey of lot 144 Cedar Point Park 2nd Addition located in the Village of Williams Bay, Walworth County, Aug 15, 1999
 Lloyd Jensen
 County Surveyor

#2181

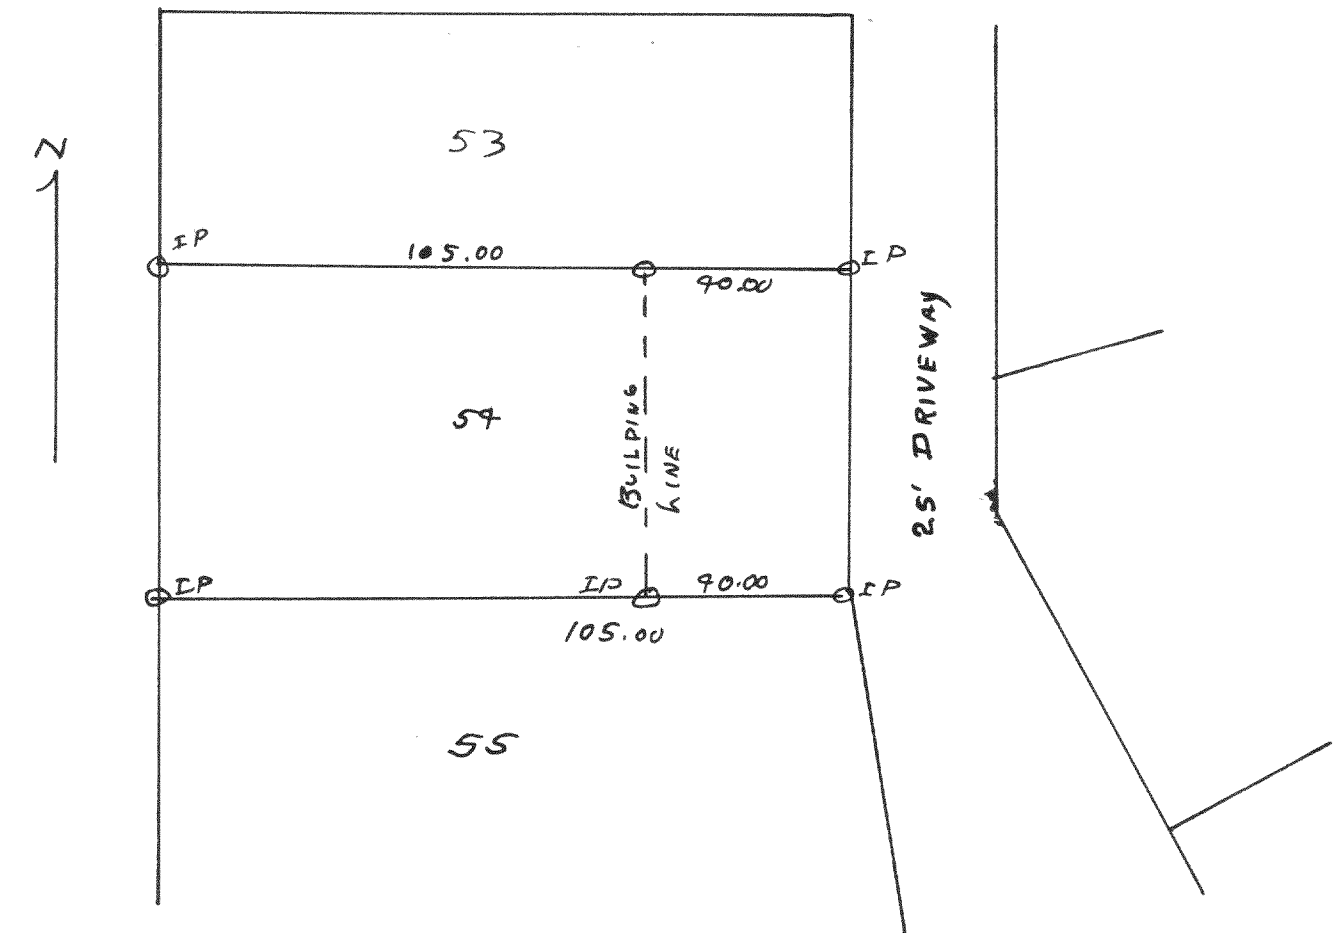


Plot of survey of lot 57 of Cedar Point Park Original Subdivision located in the Village of Williams Bay, Walworth County, April 1, 1999
 Lloyd Jensen
 County Surveyor

#2182

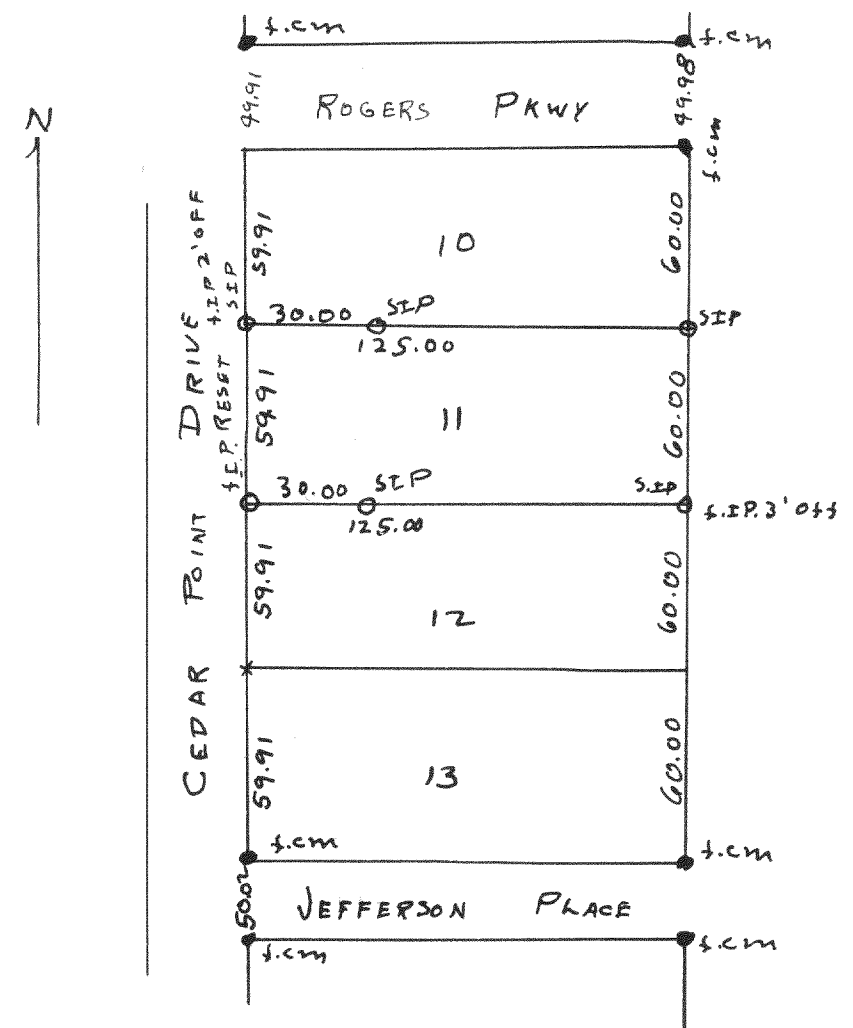

Plot of survey of lot 11 Cedar Point Park Original located in Williams Bay, Walworth County, April 29, 1999
 Lloyd Jensen
 County Surveyor

#2183

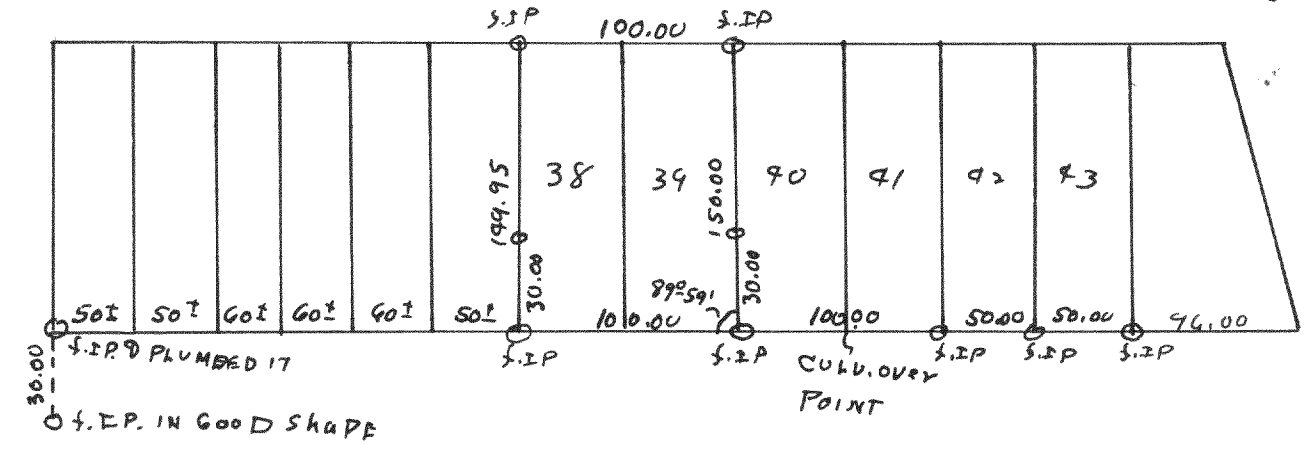

Plot of survey of lots 38 & 39 of Summer Haven Subdivision located in the Village of Williams Bay, Walworth County, Wisconsin, 1949
 Lloyd Jensen
 County Surveyor