



#2392

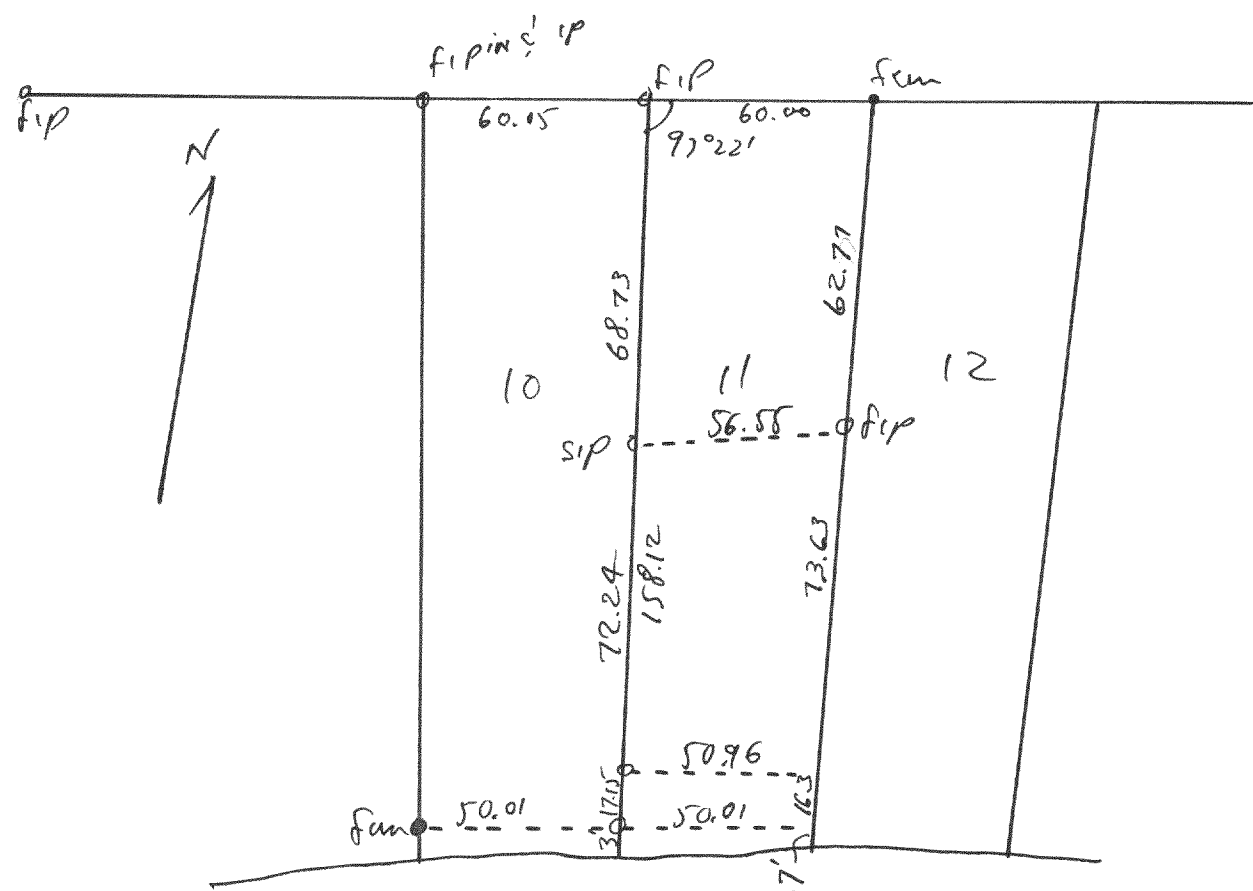

GENEVA LAKE  
 Plat of survey of lot 11, blk A, Cisco Beach Subd.,  
 located in the NE 1/4 of Sec 8, T14N R17E of Walworth Cty, Wis.  
 Nov 1950  
 Lloyd J. Jensen  
 County Surveyor


#2394

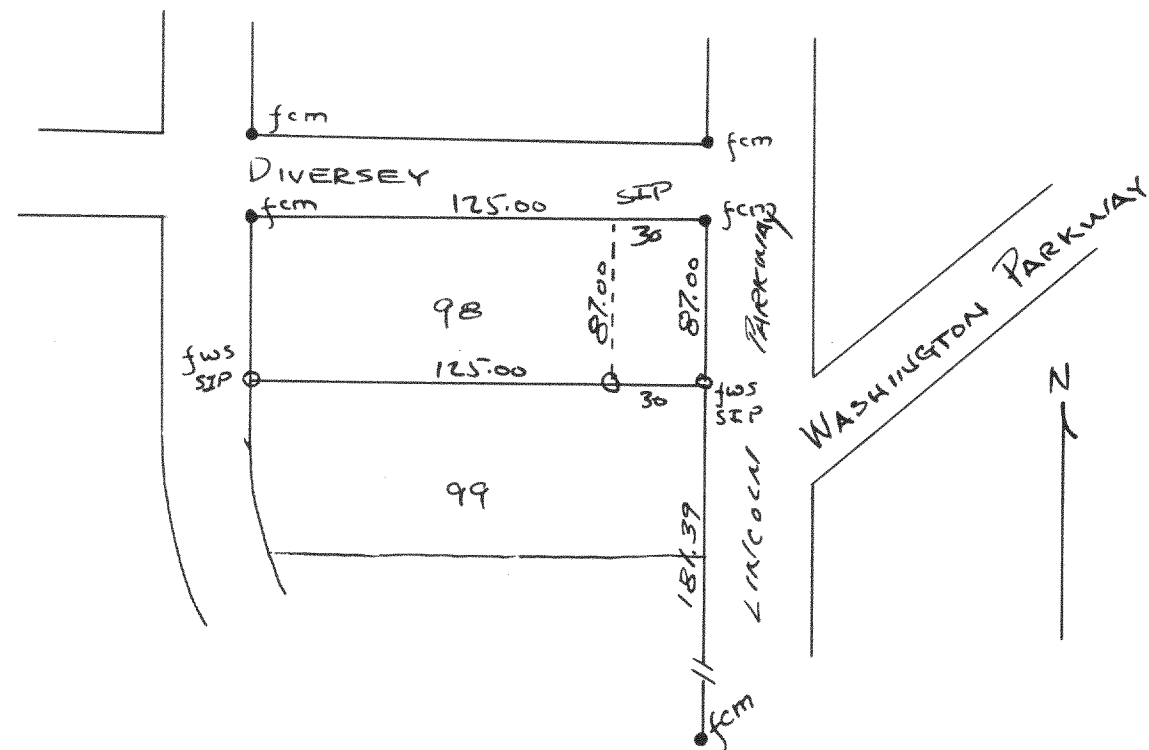

Plat of survey of lot 98 original plat Cedar Point Park  
 Village of Williams Bay, Walworth County, Wisconsin  
 Oct. 24, 1951  
 Lloyd J. Jensen  
 County Surveyor

Dist to house  
 3-26-51  
 LJS


#2393

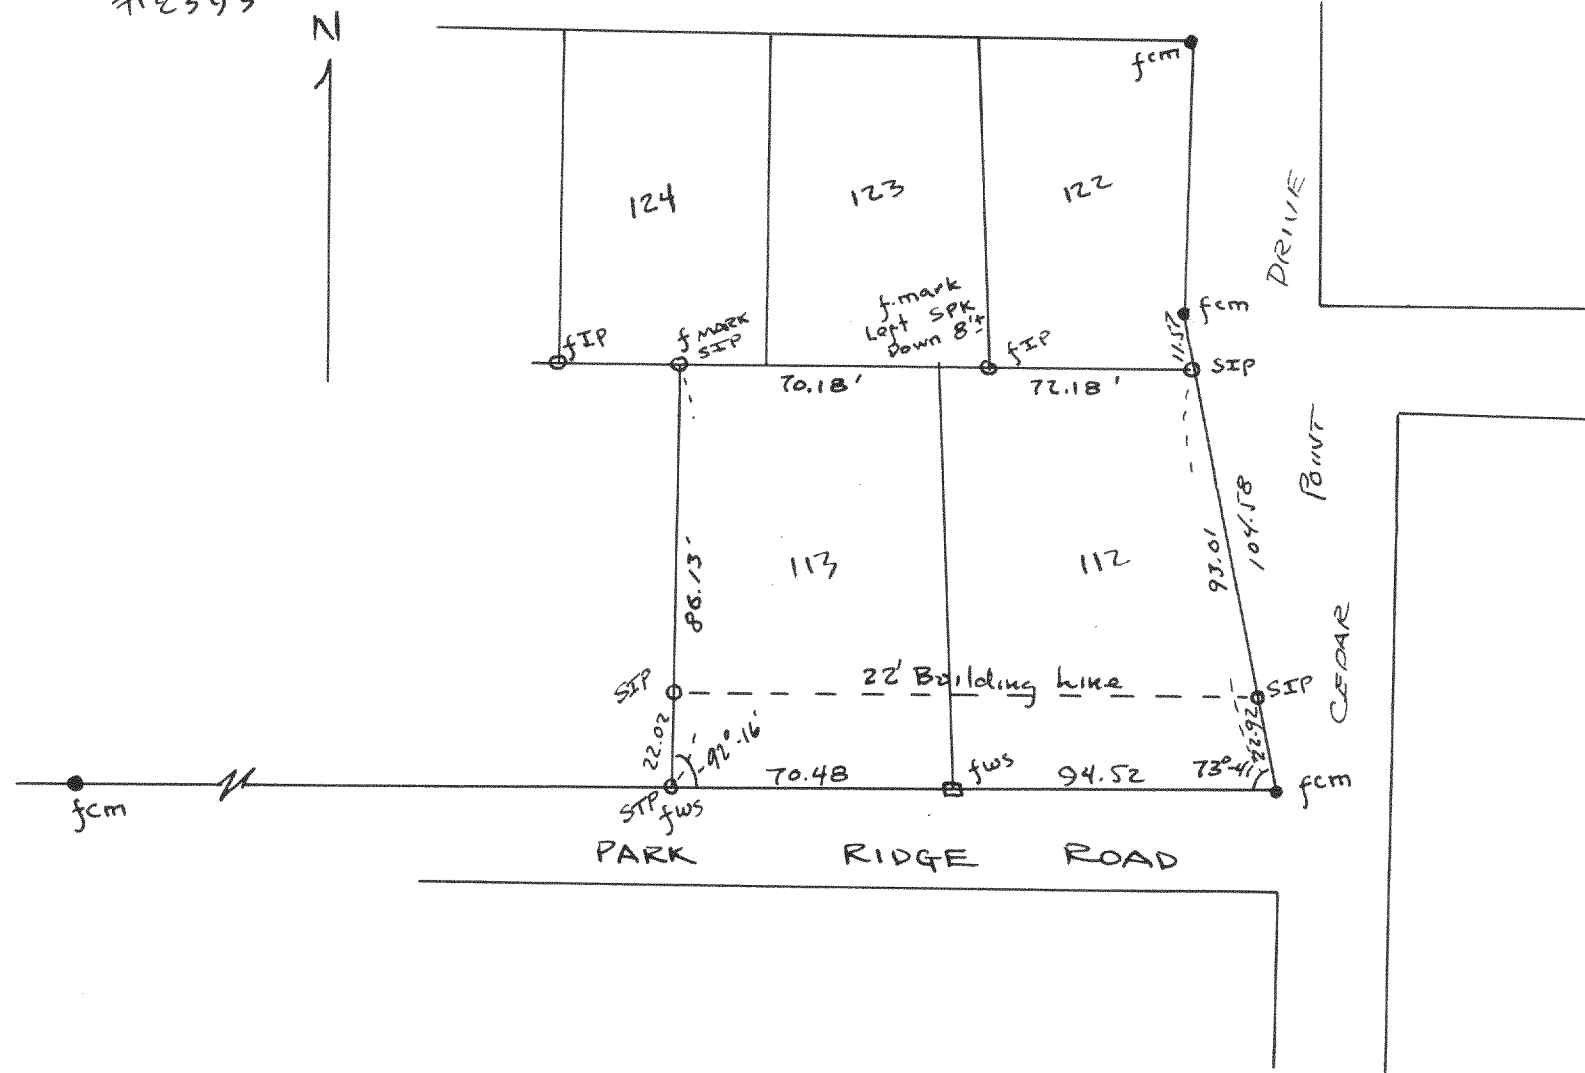

Plat of survey of lots 112-113 Cedar Point Park 2nd  
 Add. Village of Williams Bay, Walworth County, Wis.  
 Oct 23, 1951

Lloyd J. Jensen  
 County Surveyor

#2395

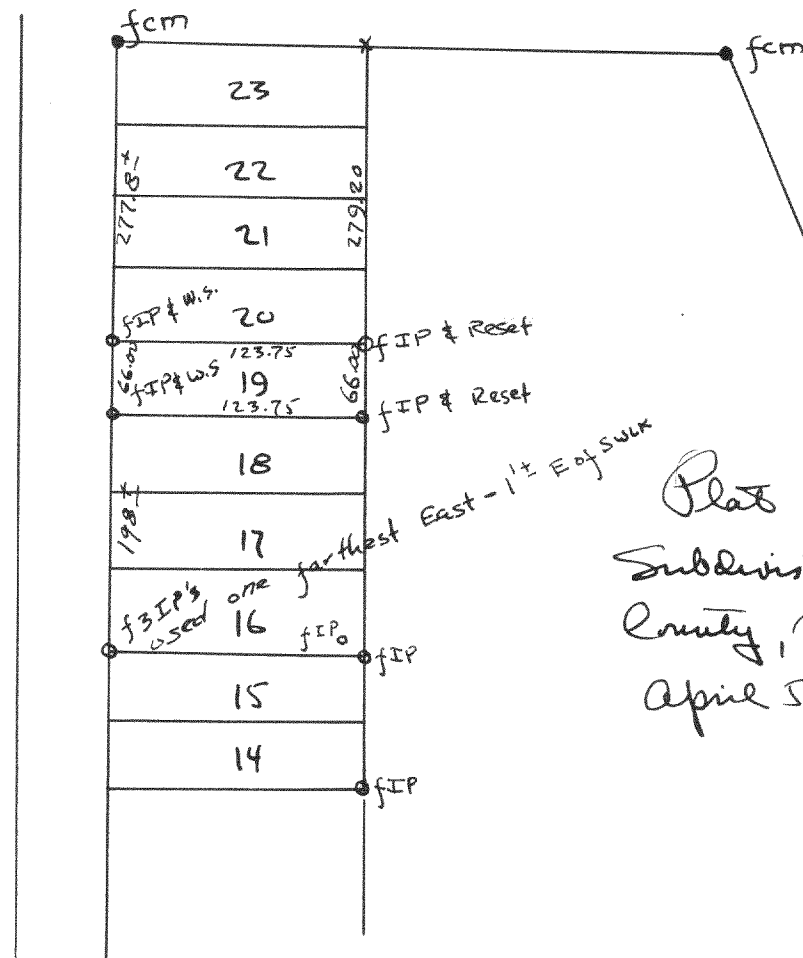

Plat of survey of lot 19 Parklawn  
 Subdivision, City of Whitewater, Walworth  
 County, Wisconsin

April 5, 1951 Lloyd J. Jensen  
 County Surveyor