



2498

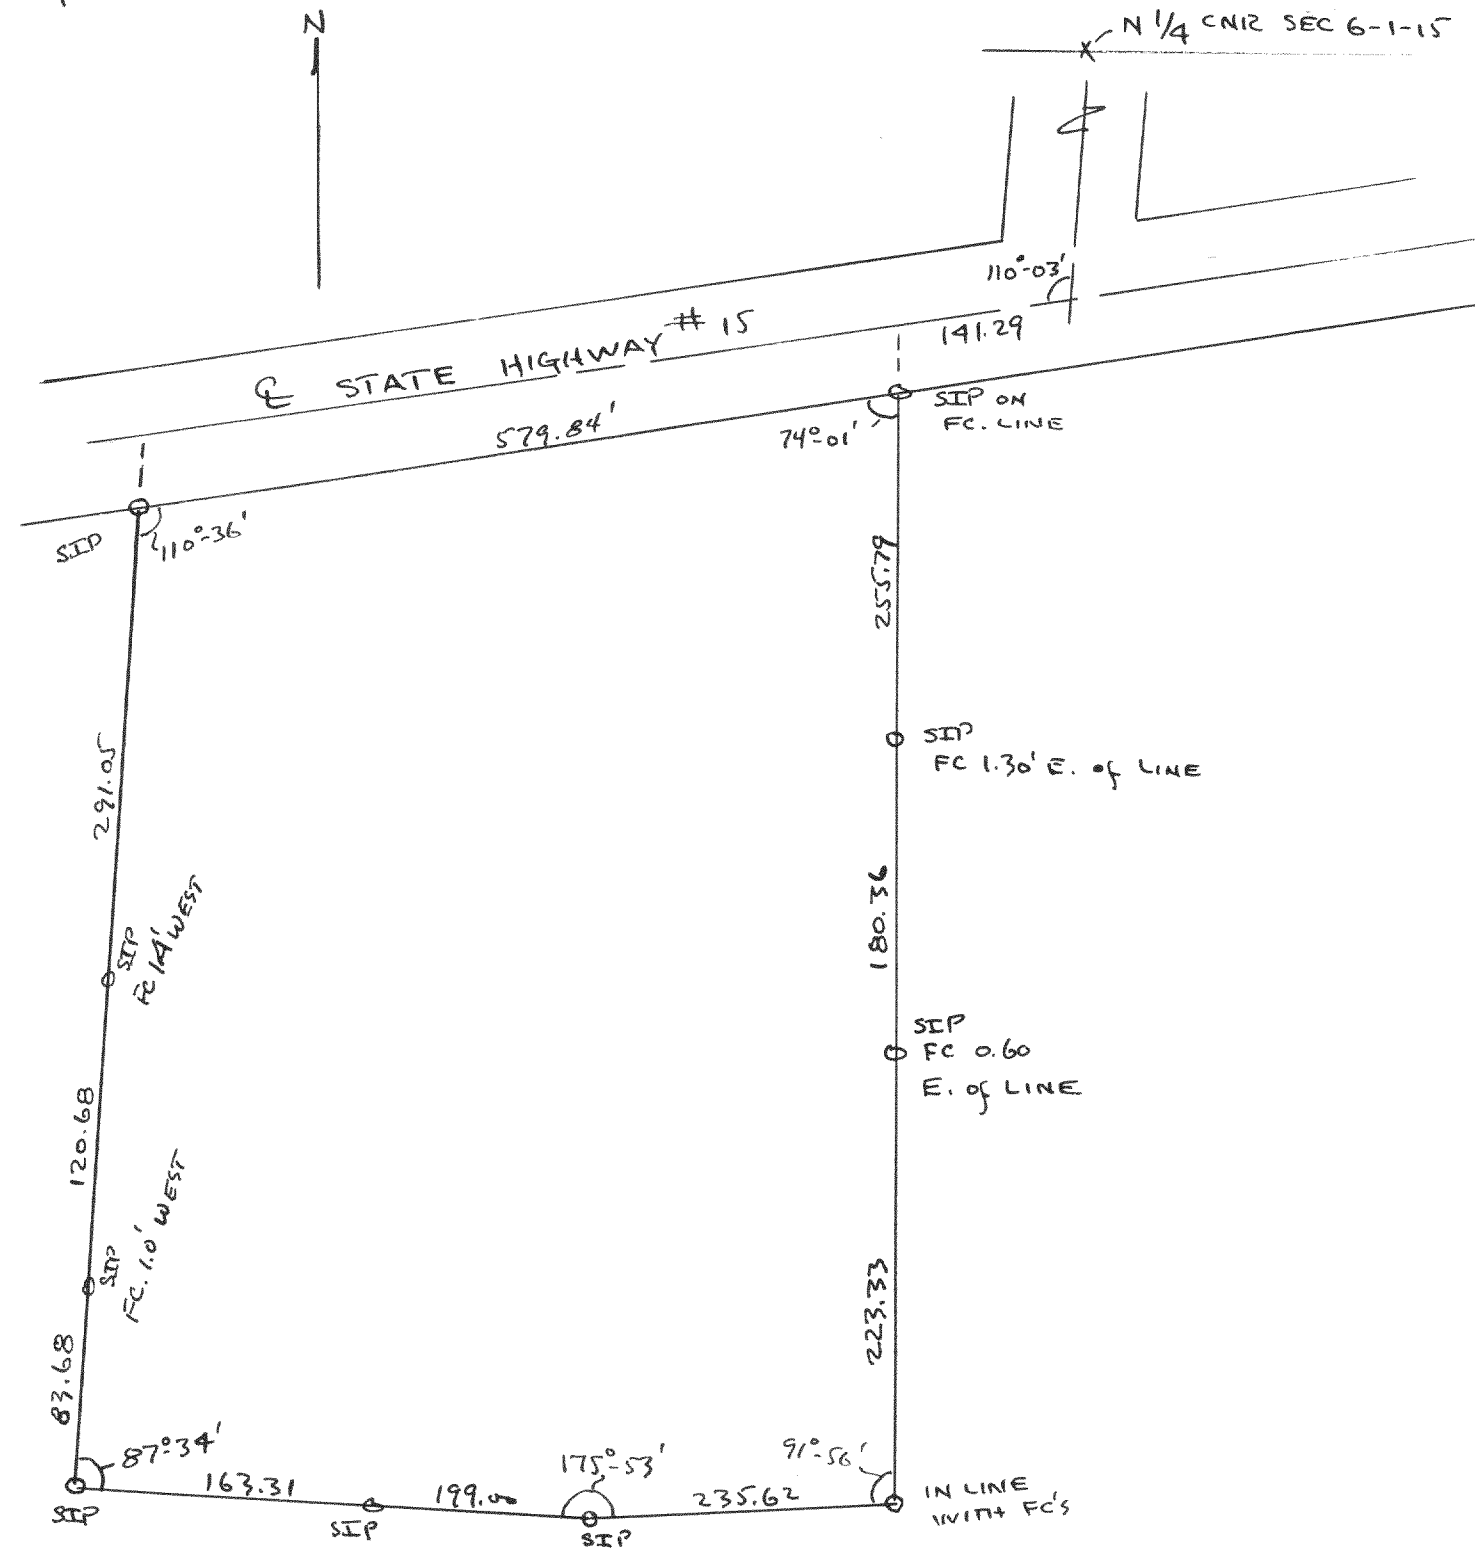

Plat of survey of the Gargus Property located in Adams
 Grove, Section 6, T14N R15E, Walworth County, Wisconsin
 1951
 Lloyd L. Jensen 9EB
 County Surveyor

2499

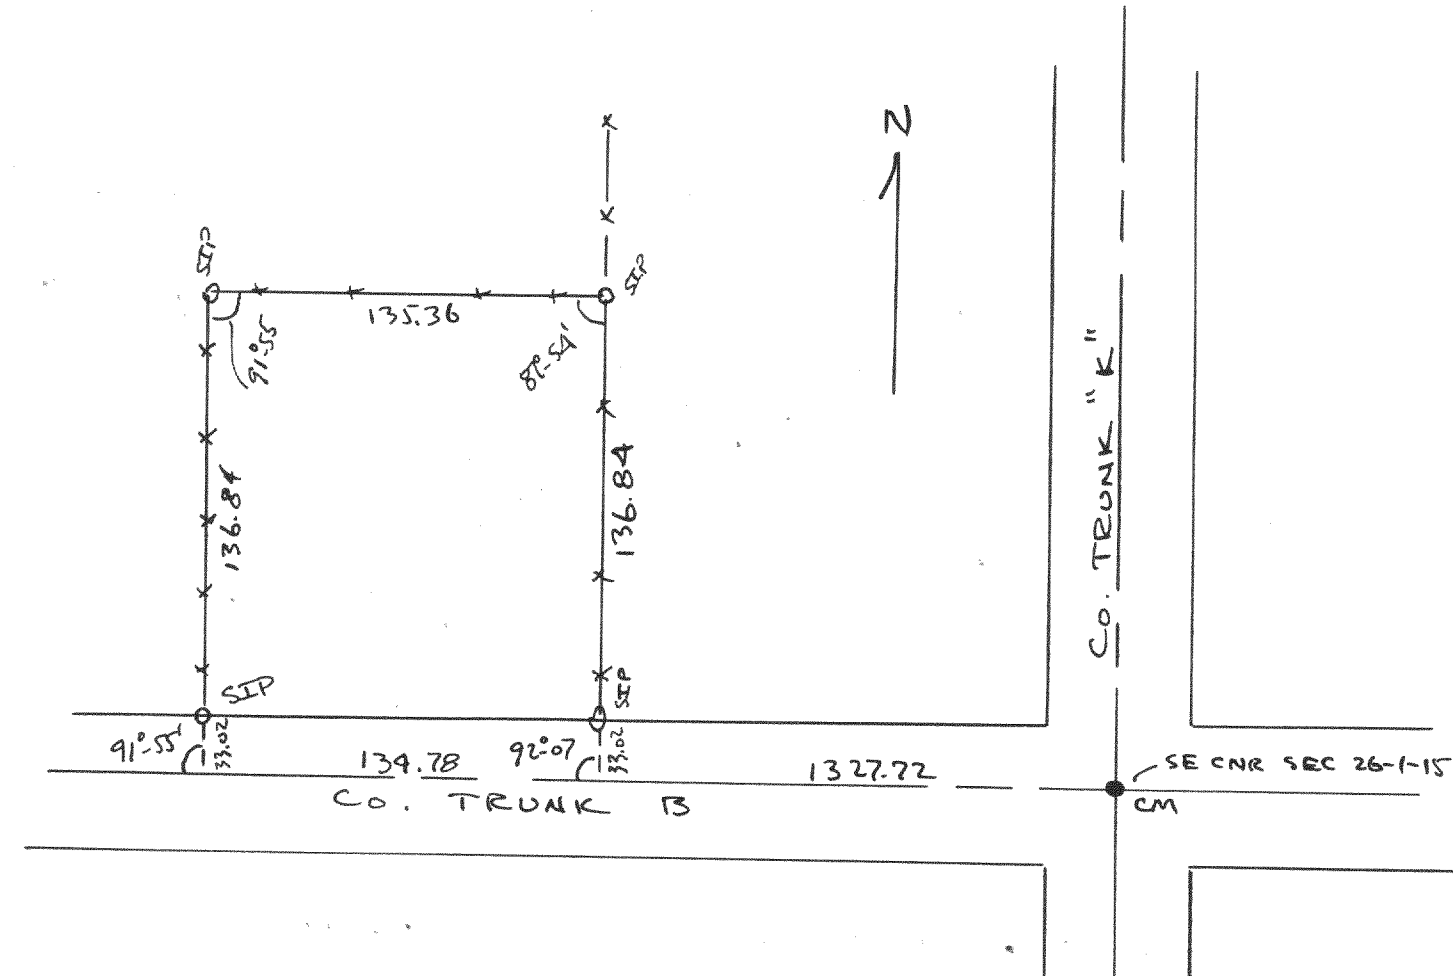

Plat of survey of the property occupied by the school located
 in the SE 1/4 of Section 26, T14N R15E, Walworth County, Wisconsin
 Aug. 21, 1951
 Lloyd L. Jensen 9EB
 County Surveyor