



# 2513

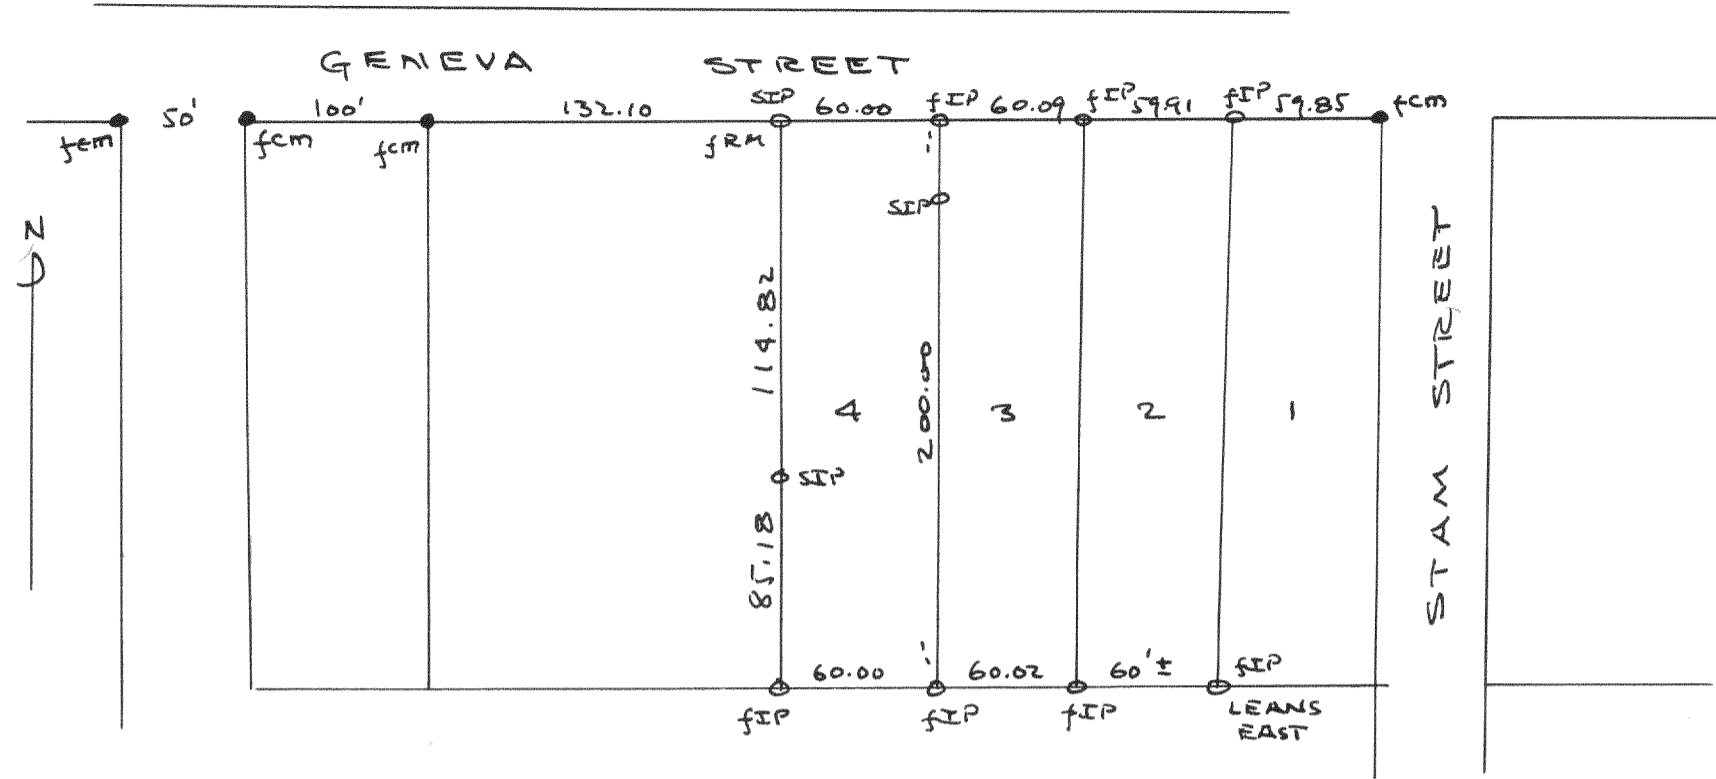


Plat of survey of lot 4, Wm. Pearsons Subdivision, Village of Williams Bay, Section 1, TINRIGE, Walworth County, Wisconsin  
 July 10, 1951  
 Lloyd L. Jensen JCB  
 County Surveyor

# 2514

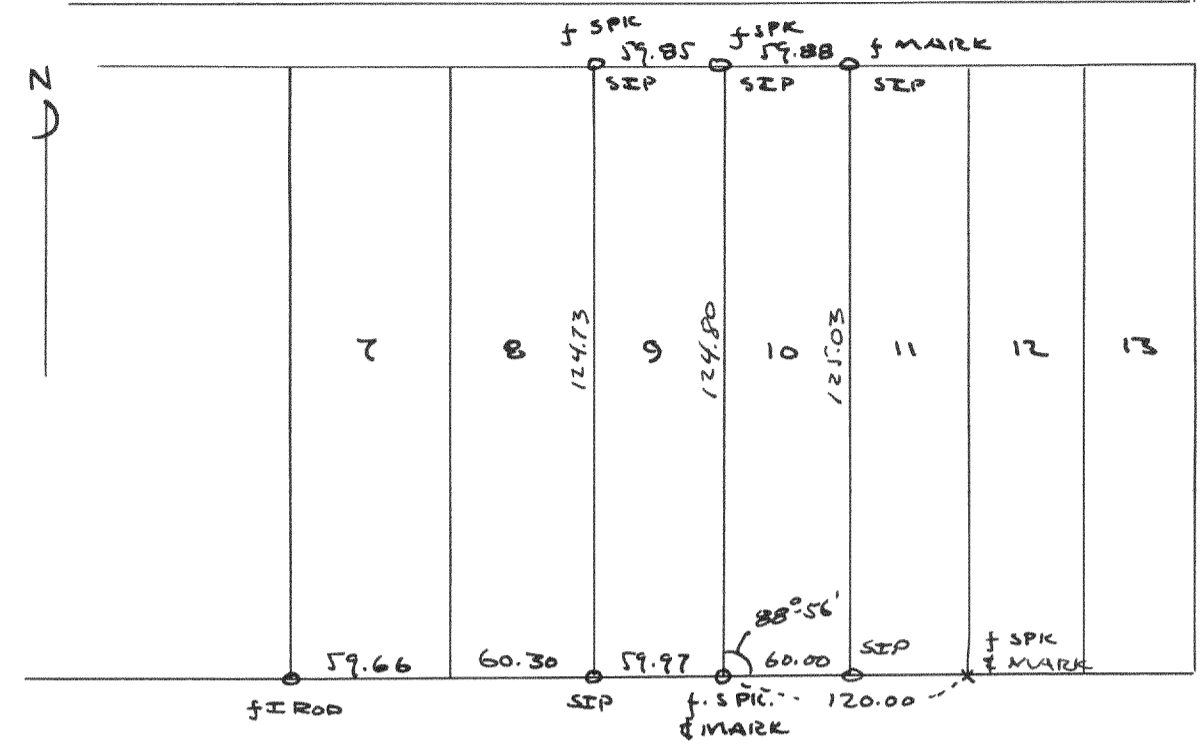


Plat of survey of lots 9 & 10, Lackey Bros. Subdivision, Village of Williams Bay, Section 1, TINRIGE, Walworth County, Wisconsin  
 July 20, 1951  
 Lloyd L. Jensen JCB  
 County Surveyor

# 2515

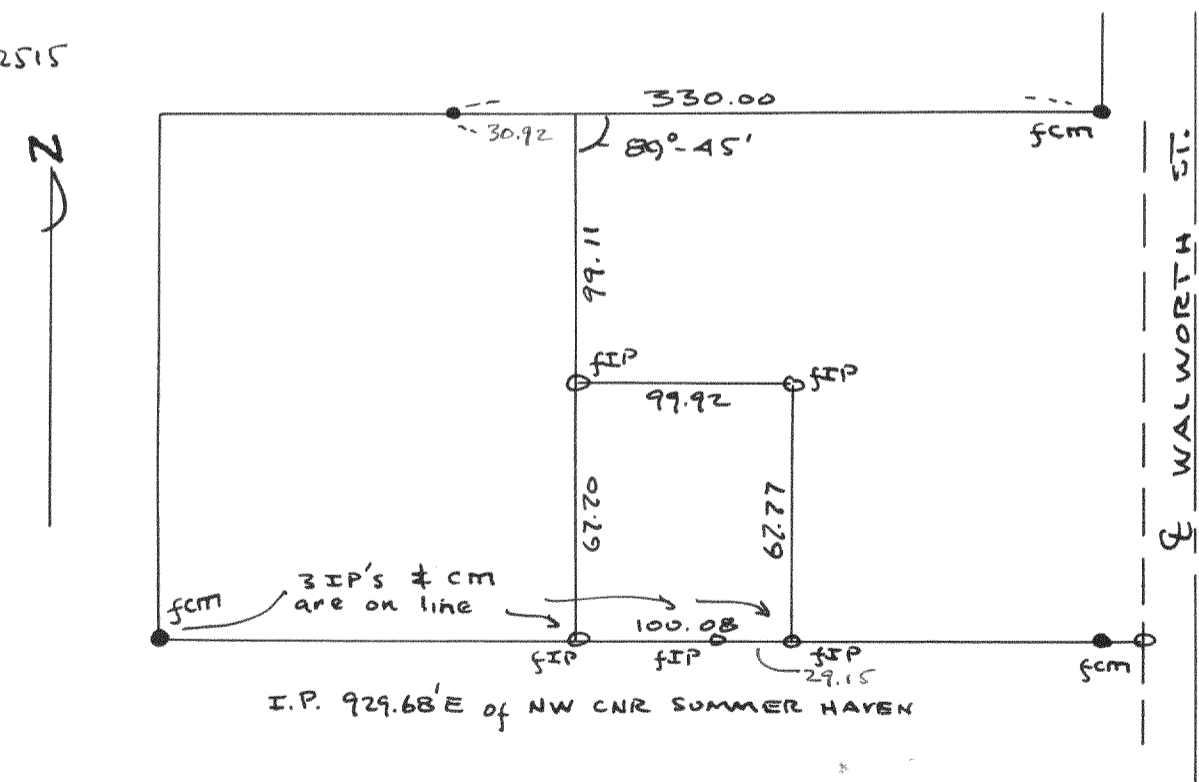

Plat of survey of a parcel of land out of Hatch Estate located in SE 1/4 of Section 1, TINRIGE, Village of Williams Bay, Walworth County, Wis.  
 Aug 6, 1951  
 Lloyd L. Jensen JCB  
 County Surveyor

# 2516

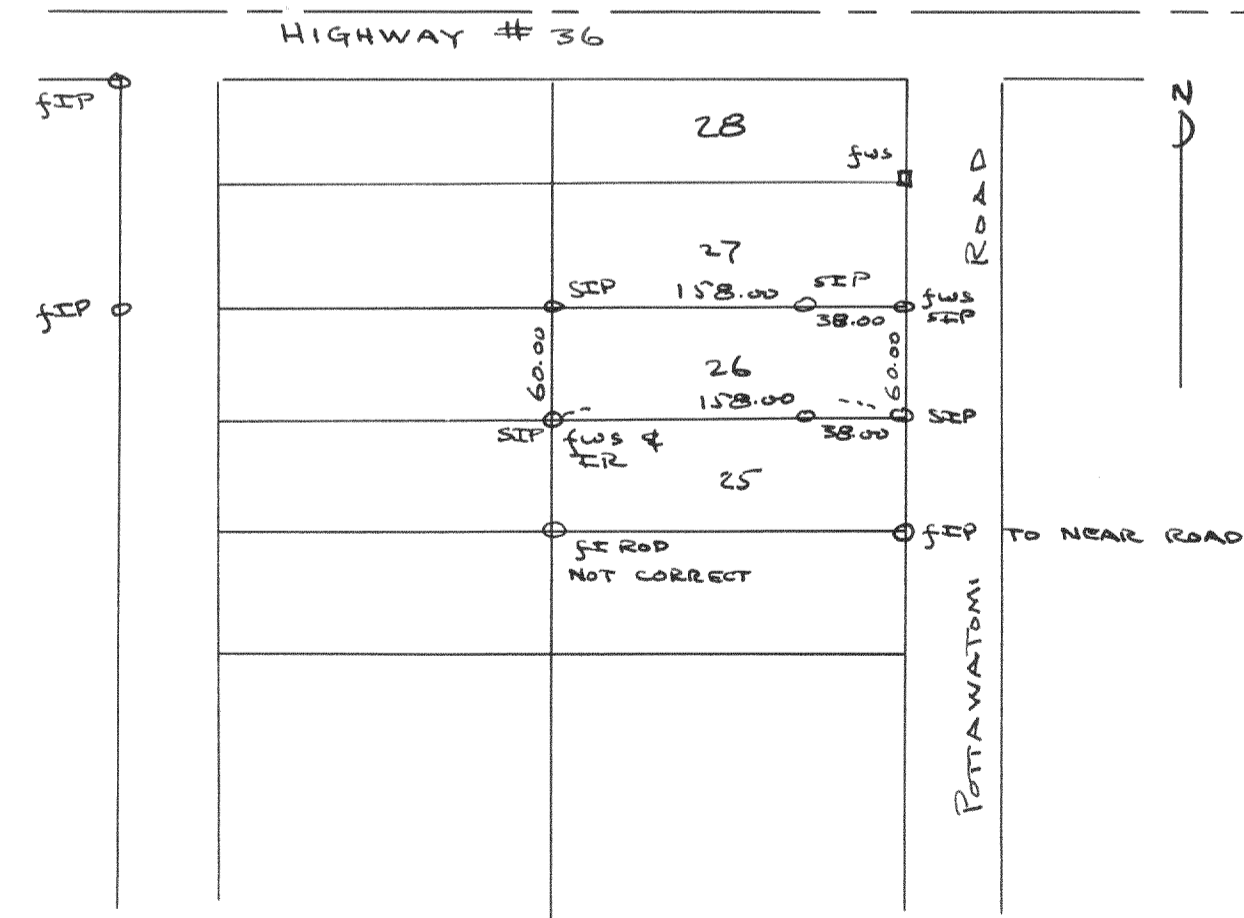

Plat of survey of lot 26, Block 2, Harbor View Subdivision, Village of Williams Bay, Section 6, TINRIGE, Walworth County, Wis.  
 Aug. 20, 1951  
 Lloyd L. Jensen JCB  
 County Surveyor