


#1353

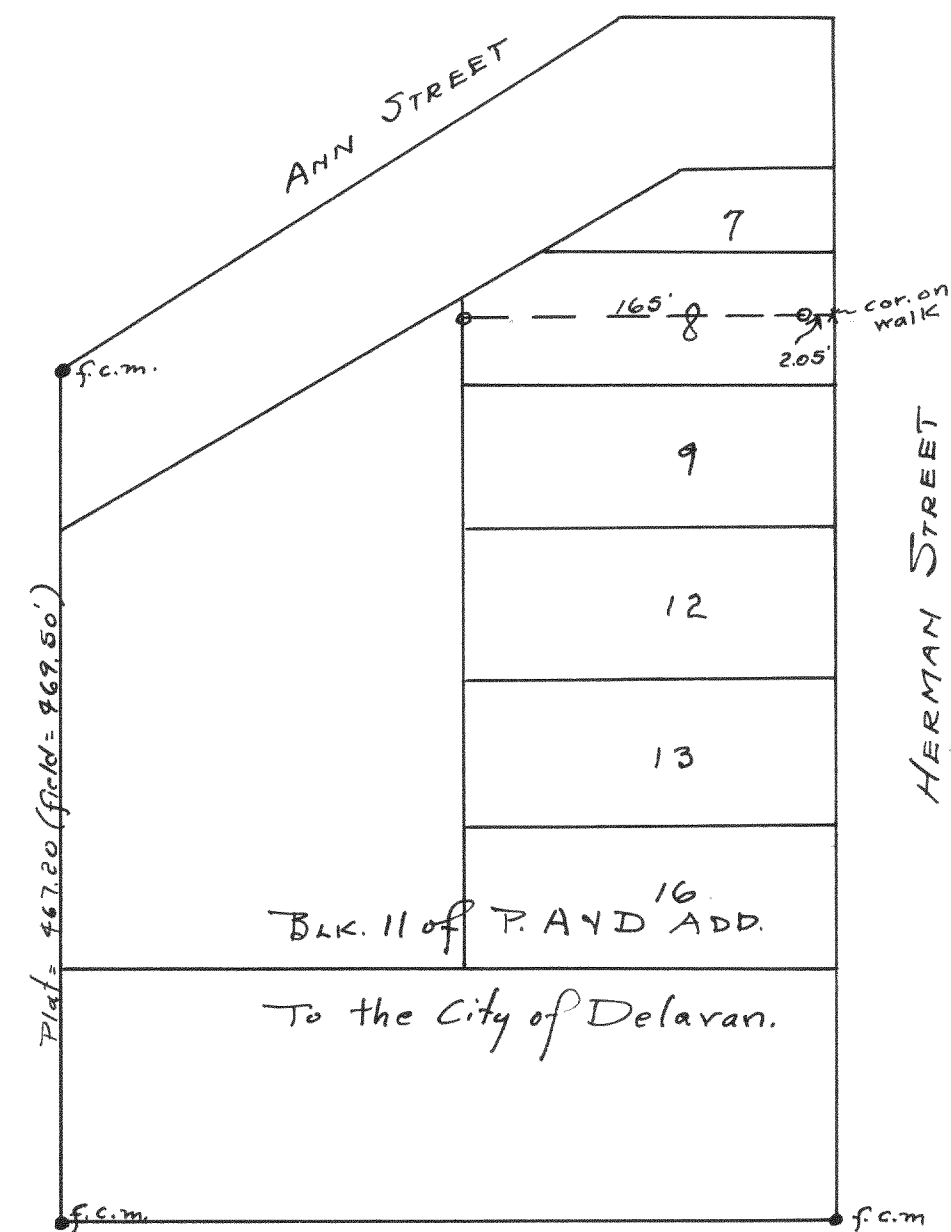


Note: the line in Lot 8 was located 33 feet N. of the S. line of said Lot 8, using the same overrun as was found on the West side of the Block, this was done as ordered by Mr. Johansen the owner & seller.

May 1942

Lloyd L. Jensen
County Surveyor

#1354

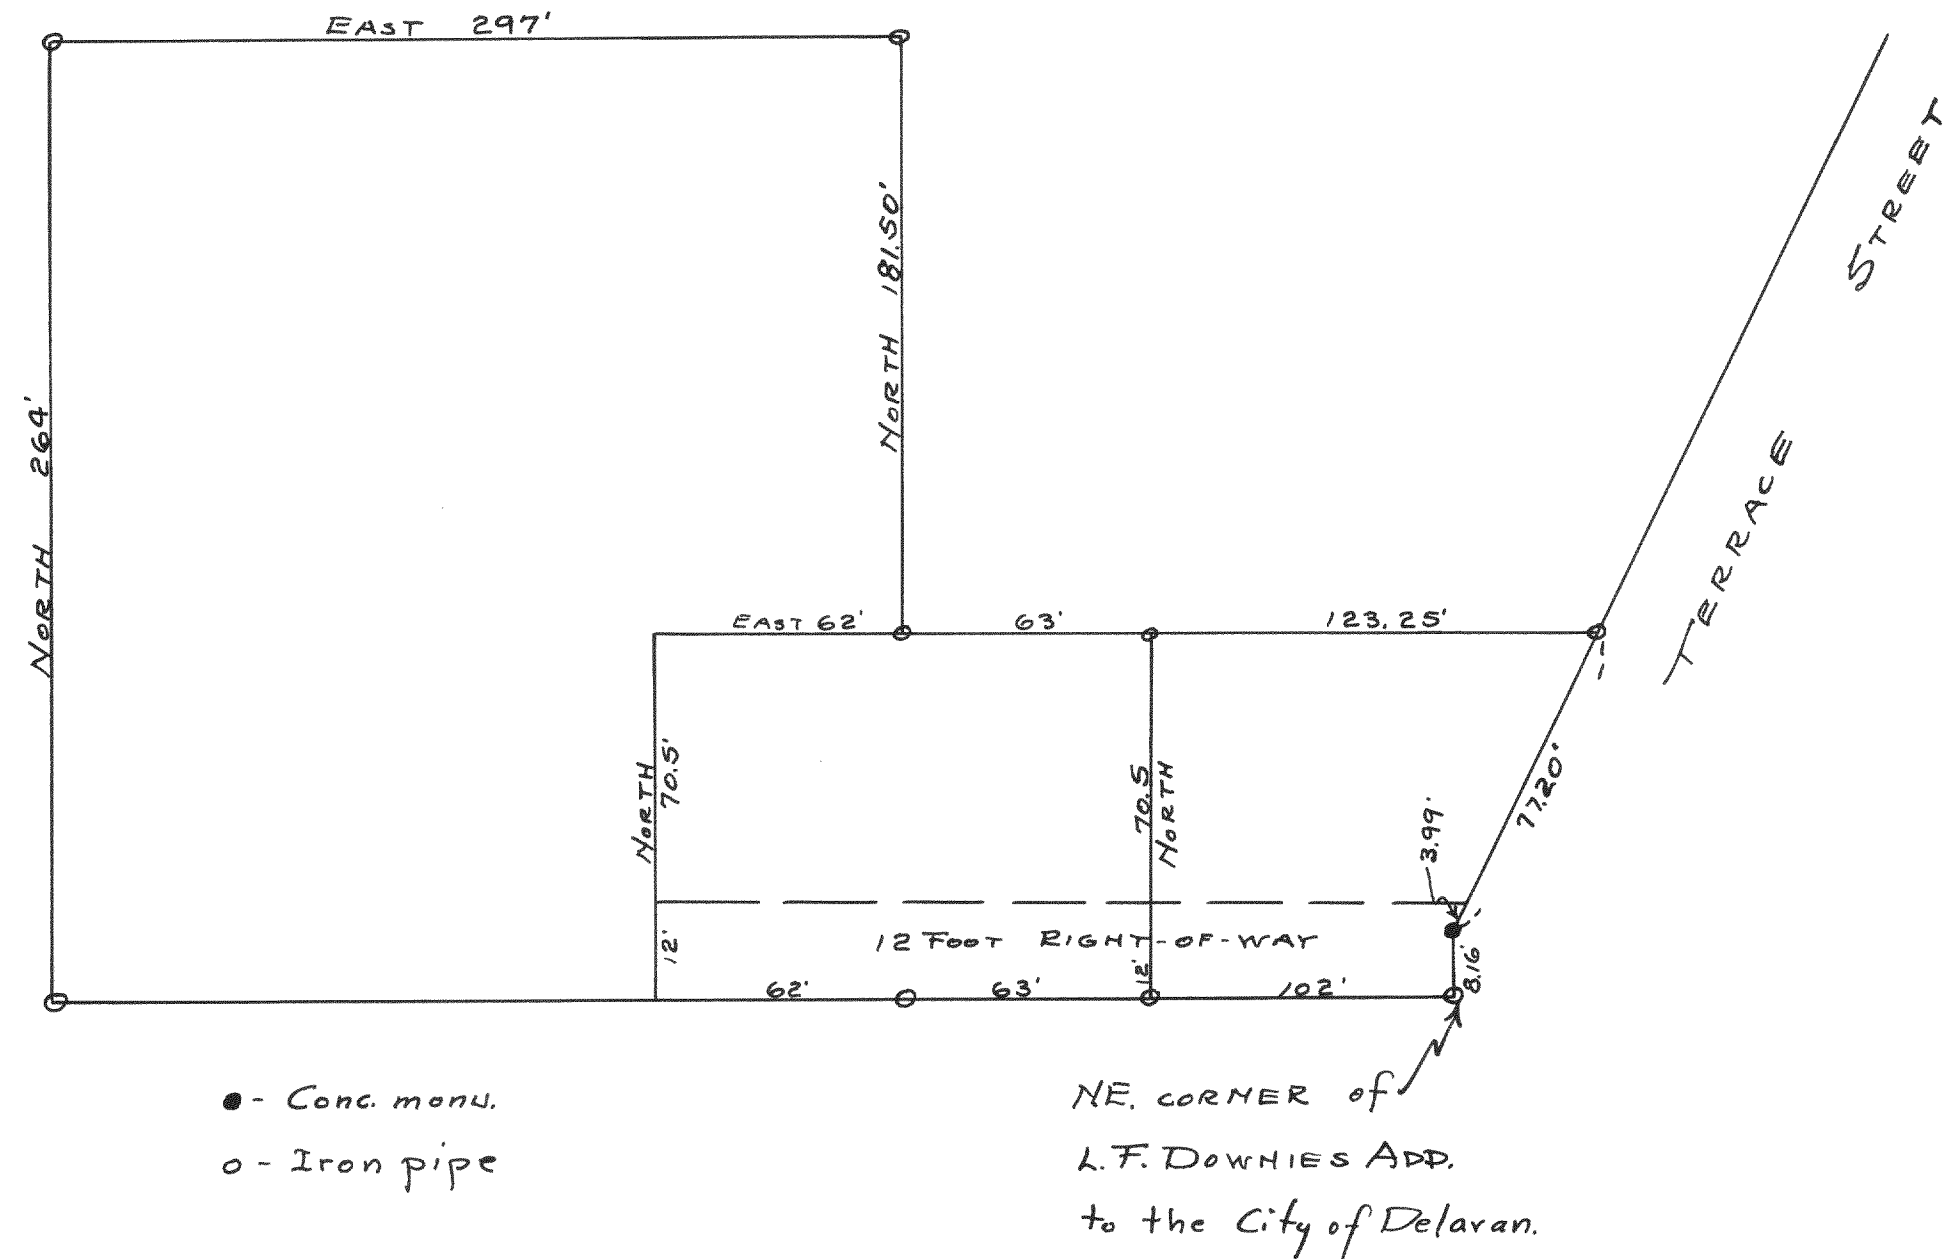

Plot of survey of land in Section 18,
T2N R16E, City of Delavan, Wisconsin.

April 1942

Lloyd L. Jensen
County Surveyor