



#1359

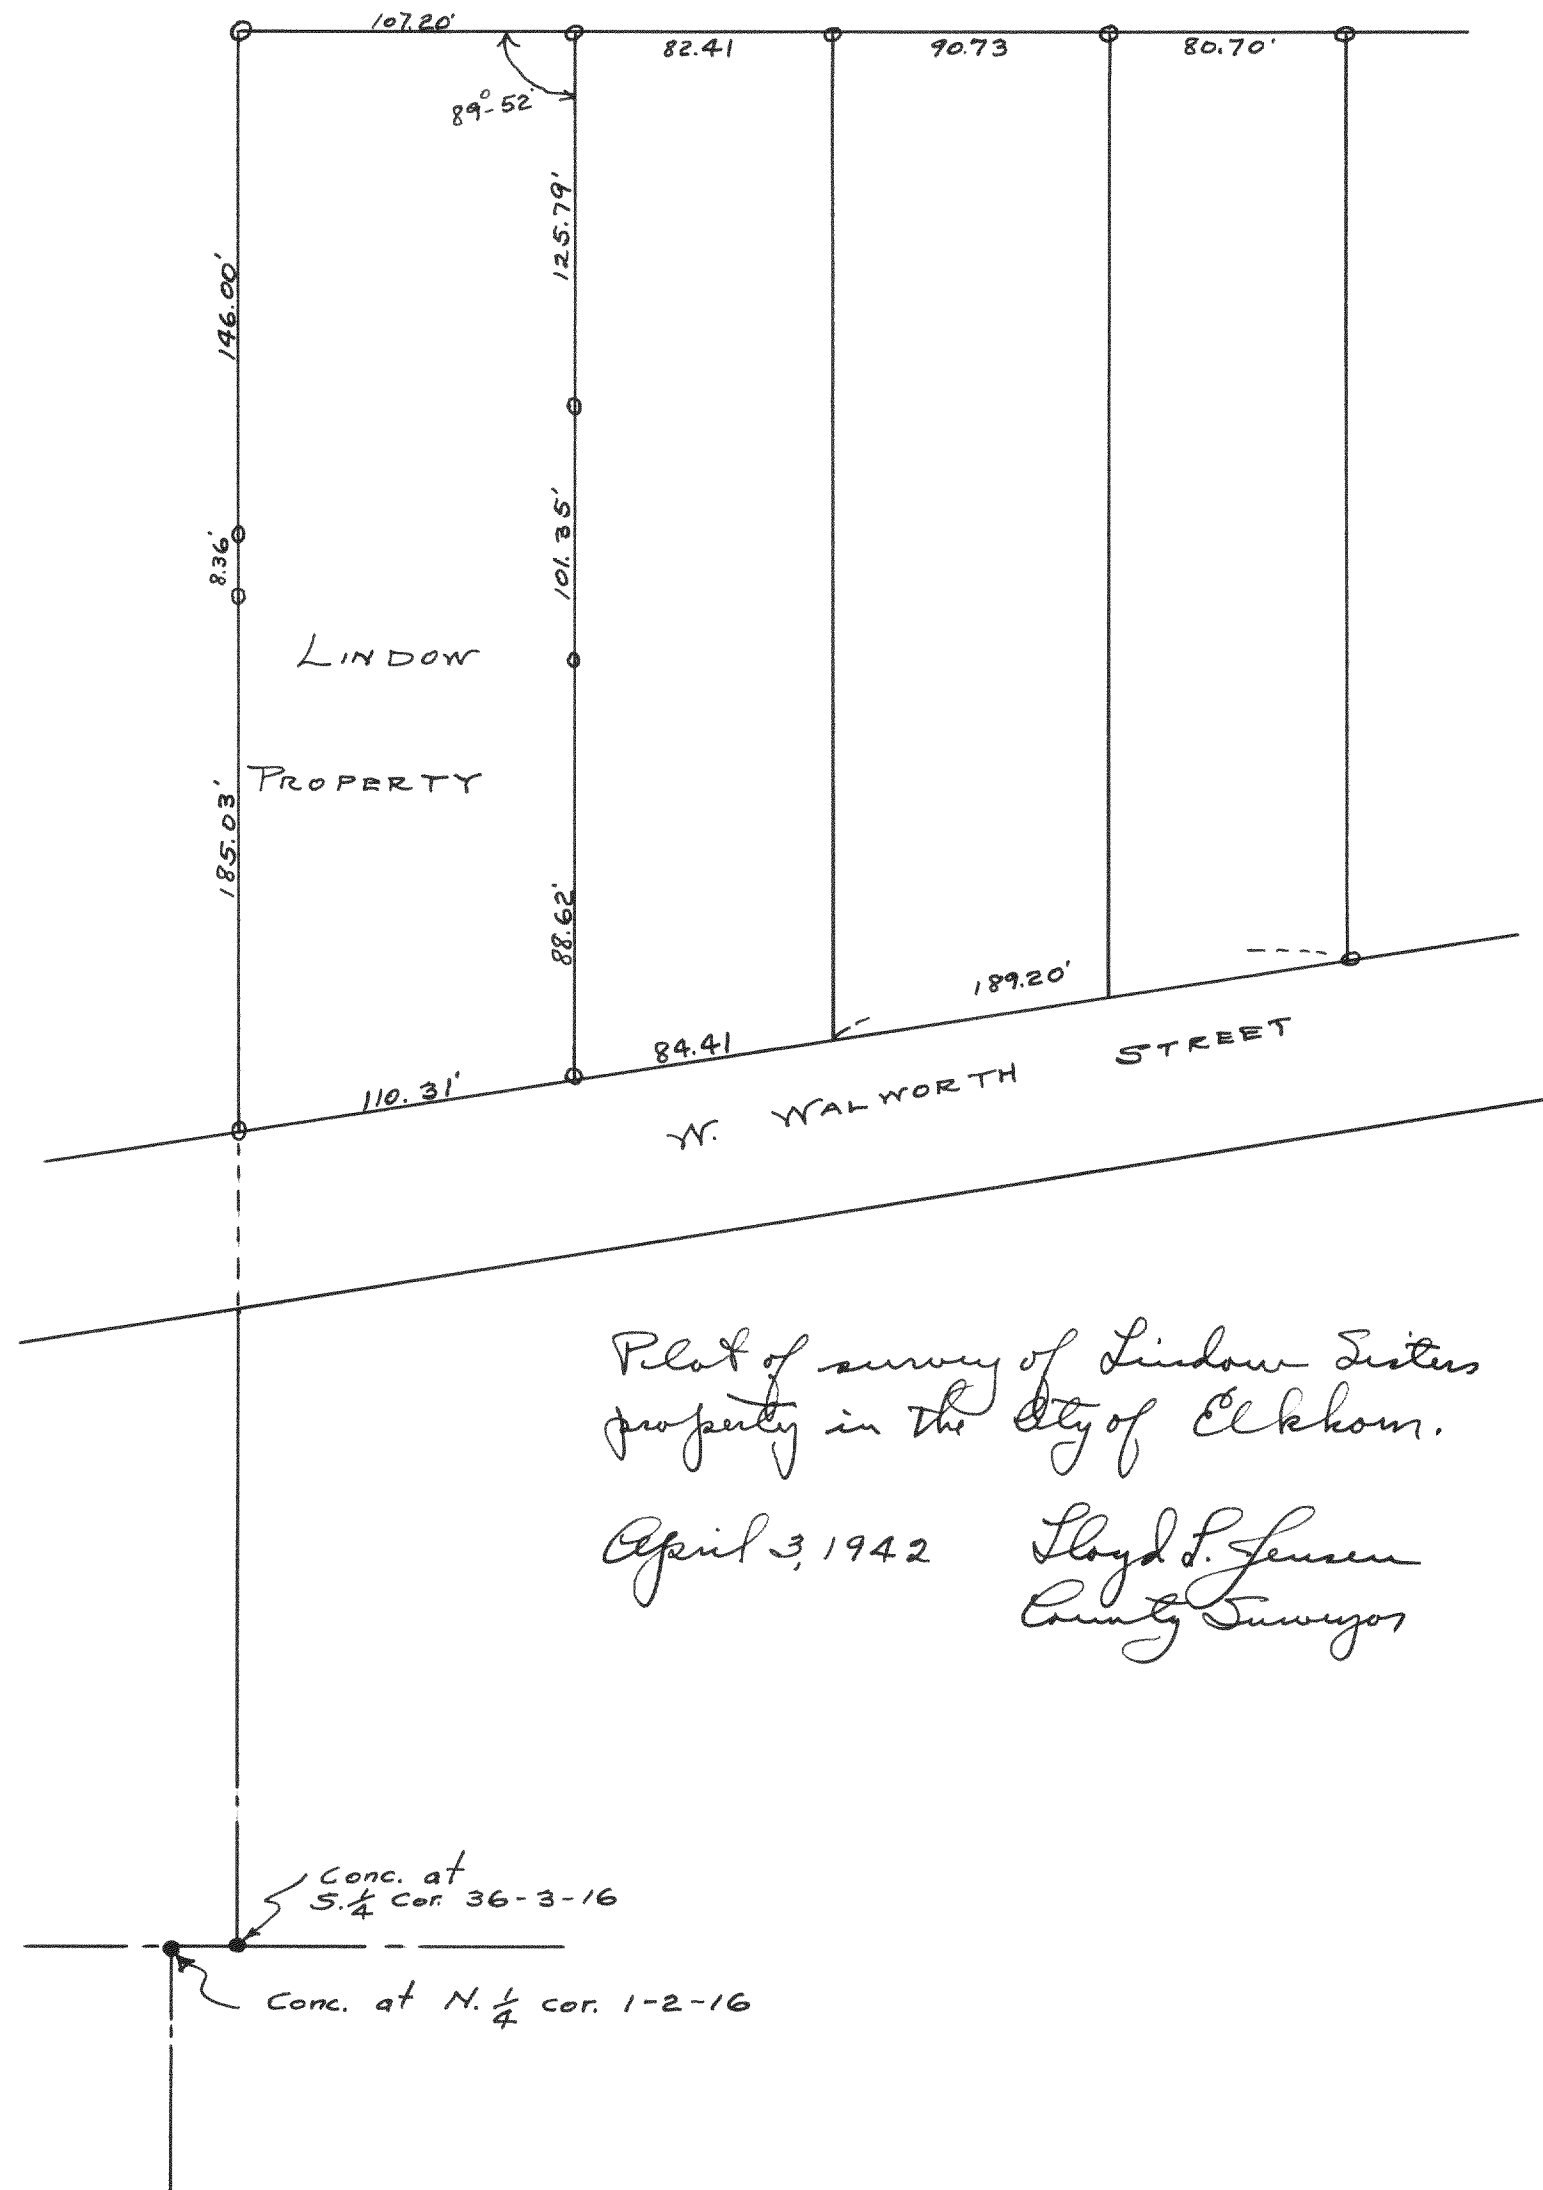

#1360

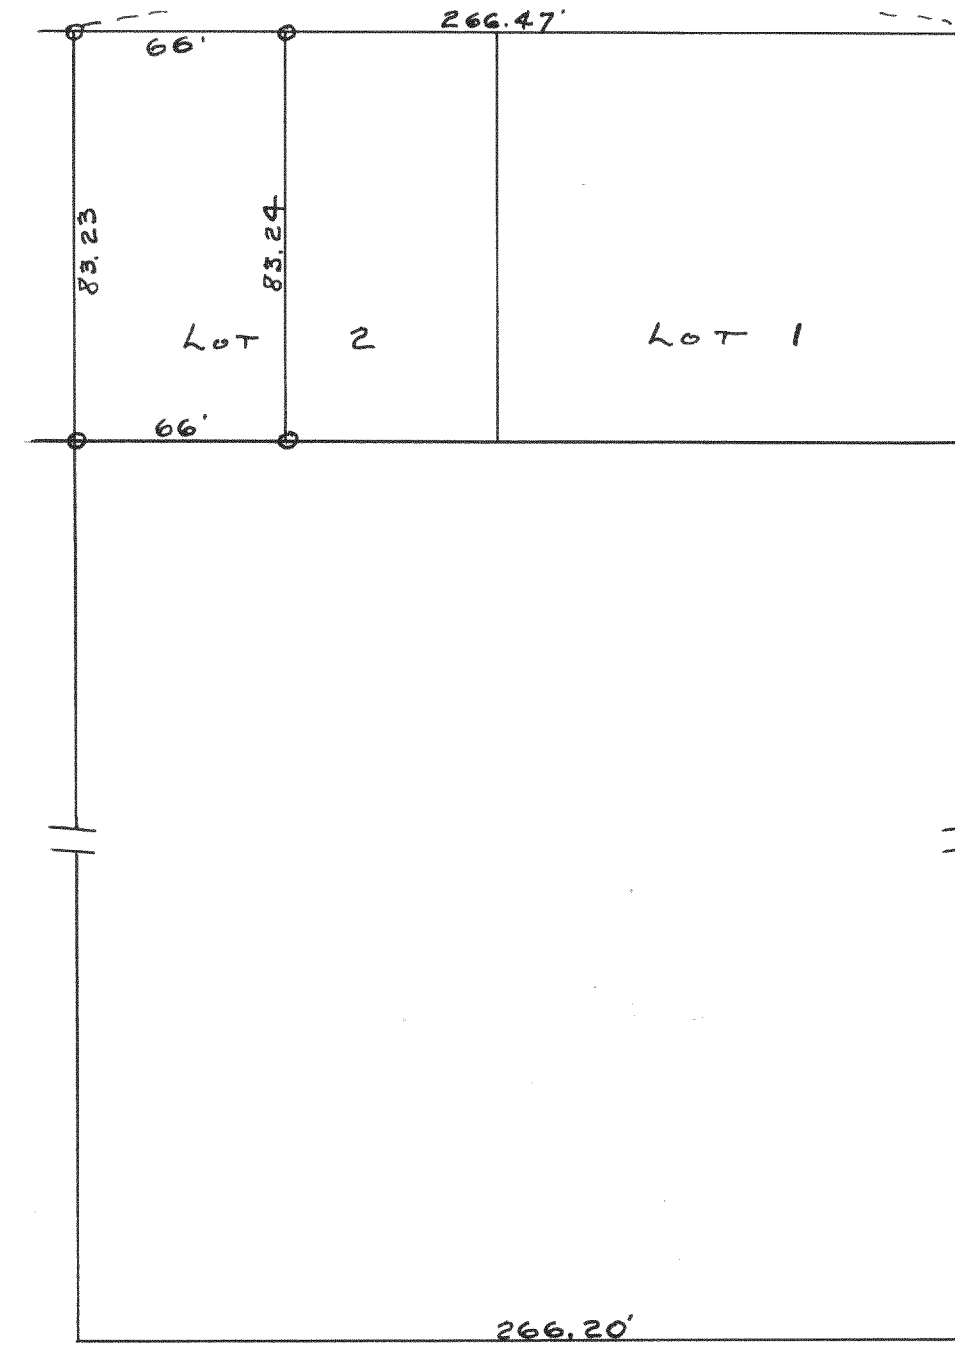

Pilot of survey of the West 66 feet of Lot 2 of Block 18 of the original plat of the City of Elkhorn, Wisconsin.

May 1942 Lloyd S. Jensen
County Surveyor