


#1361

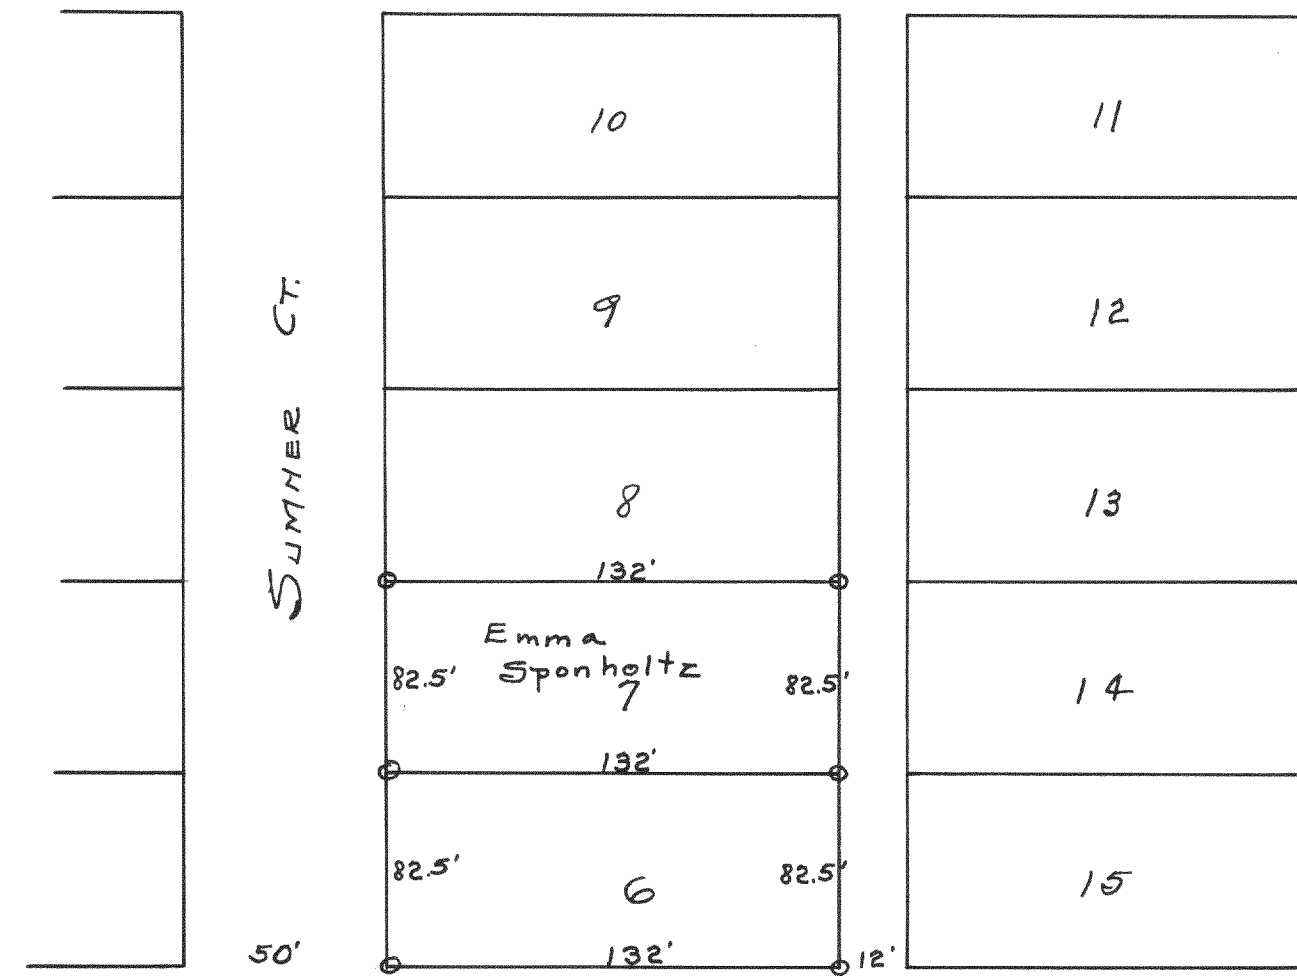


Plot of survey of Lot 7 of
Carey's Add. to the Village
of Seneca City, Walworth
County Wisconsin

May 1942

Lloyd S. Jensen
County Surveyor

#1362

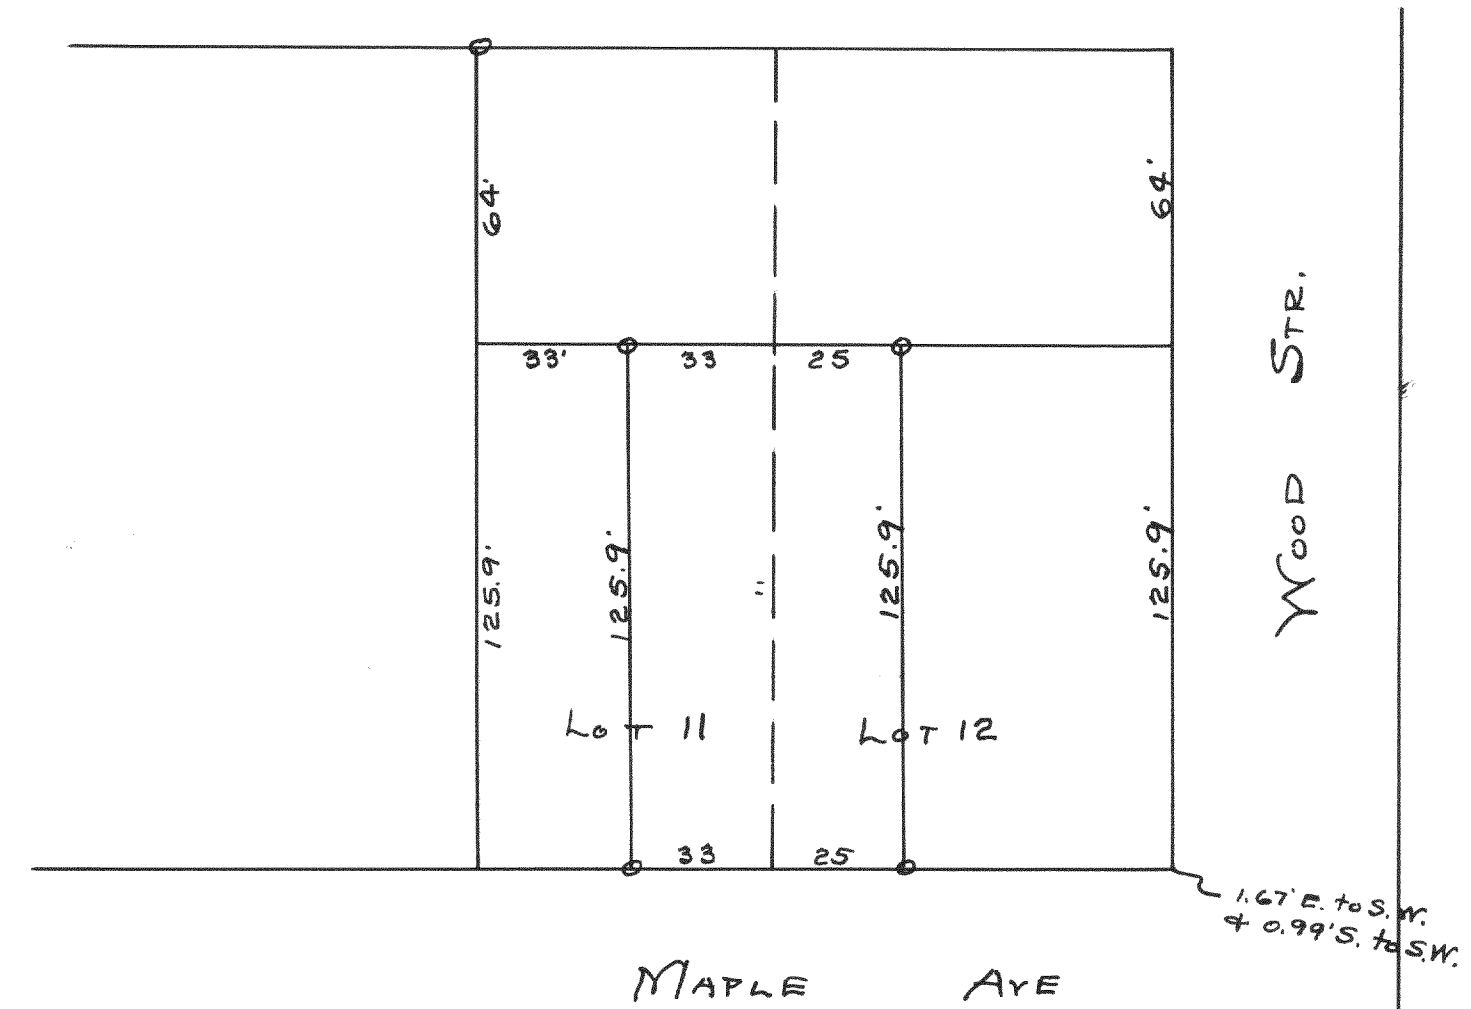

Plot of survey of part of
Lots 11 and 12 of Clark's Add.
to The Village of Walworth.

March 1942 Lloyd S. Jensen
County Surveyor