


#1365

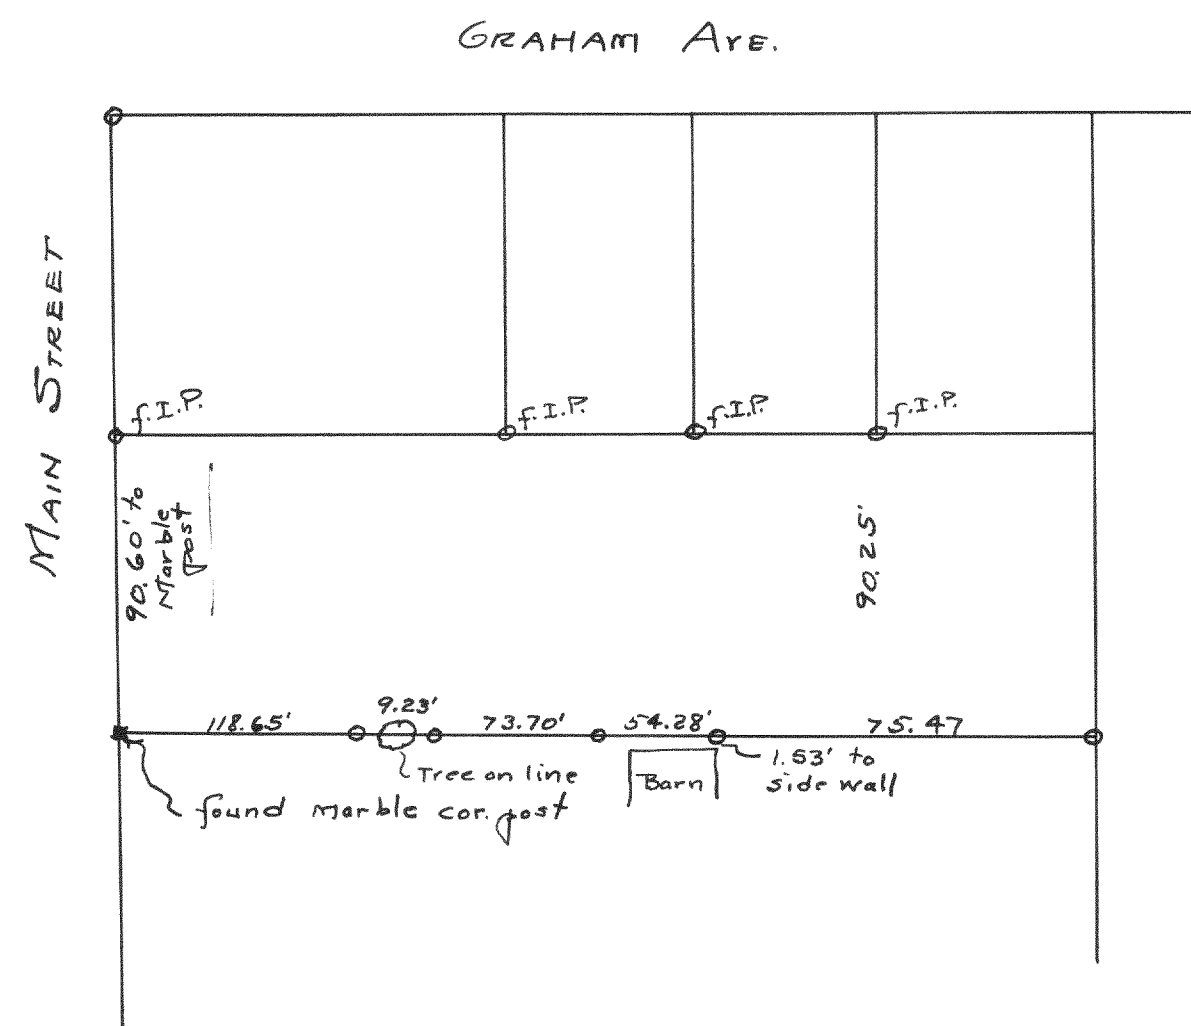


Plot of survey of the West line
of the Horyum property in the
City of Milwaukee.

July 1942

Lloyd L. Jensen
County Surveyor.

#1366

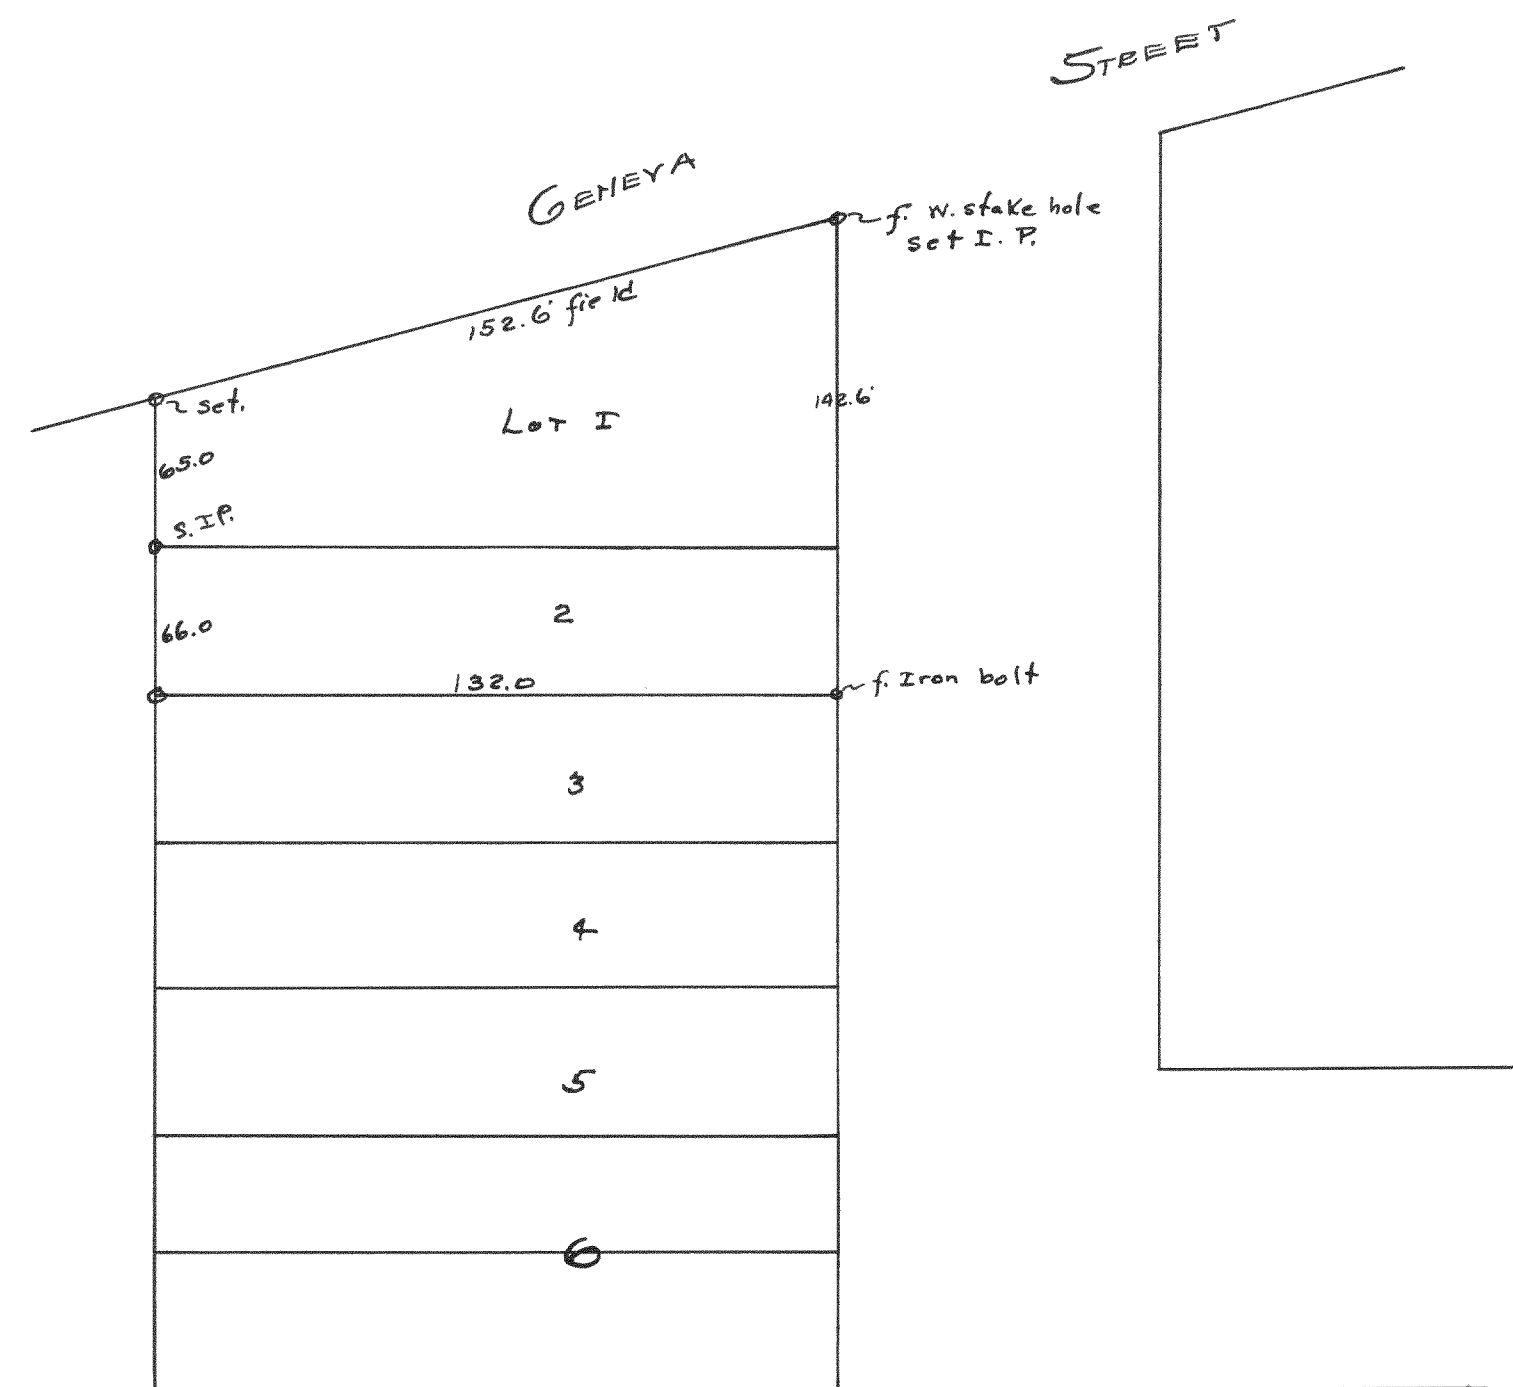

Plot of survey of the rear line
of Lot 12 of Block 5 of the original
plot of William Bay Wisconsin.

Nov. 1942

Lloyd L. Jensen
County Surveyor