


#1373

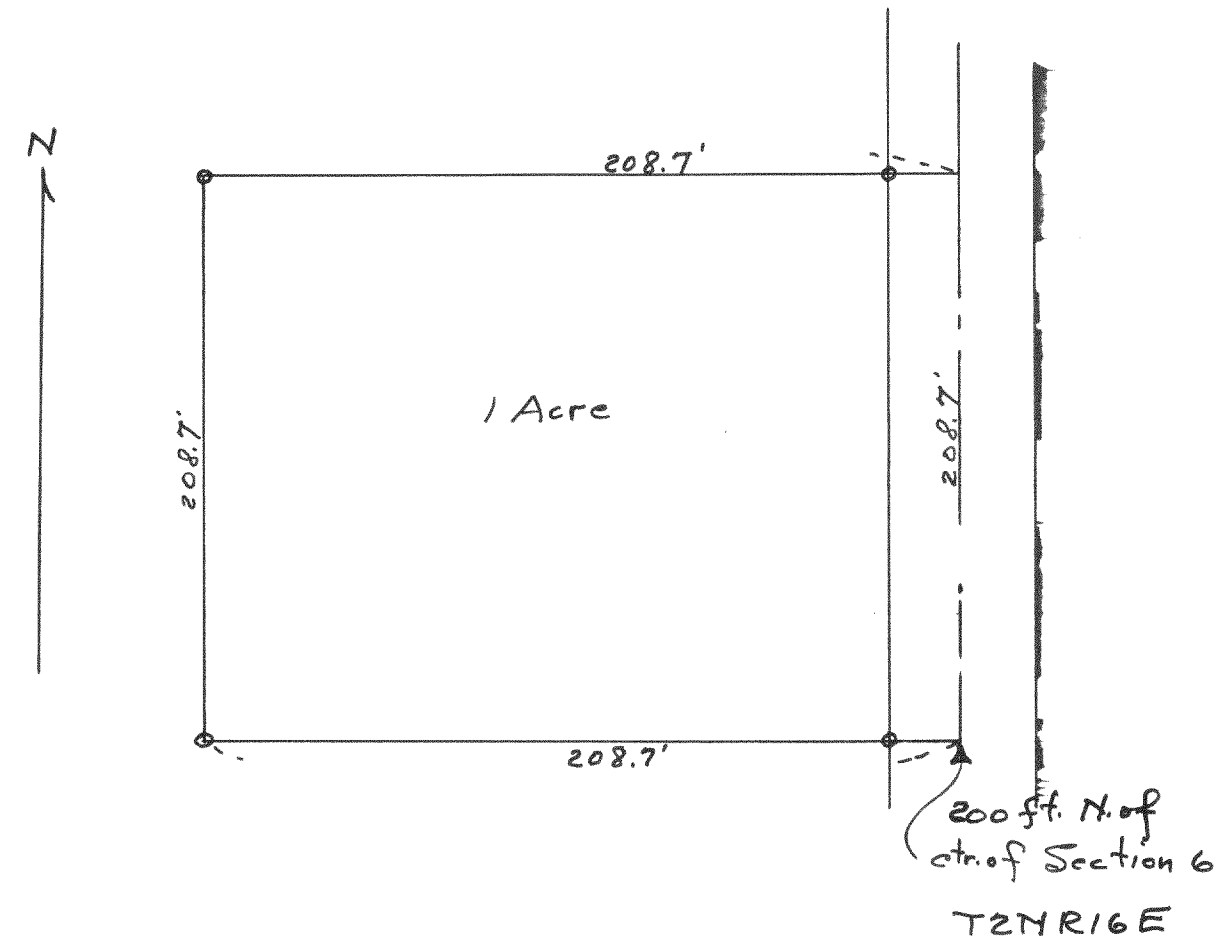


Survey of 1 acre parcel of land
in the Southeast corner of SE $\frac{1}{4}$ of
NW $\frac{1}{4}$ of Section 6-2-16

March 16, 1943

Lloyd L. Jensen
County Surveyor

#1374

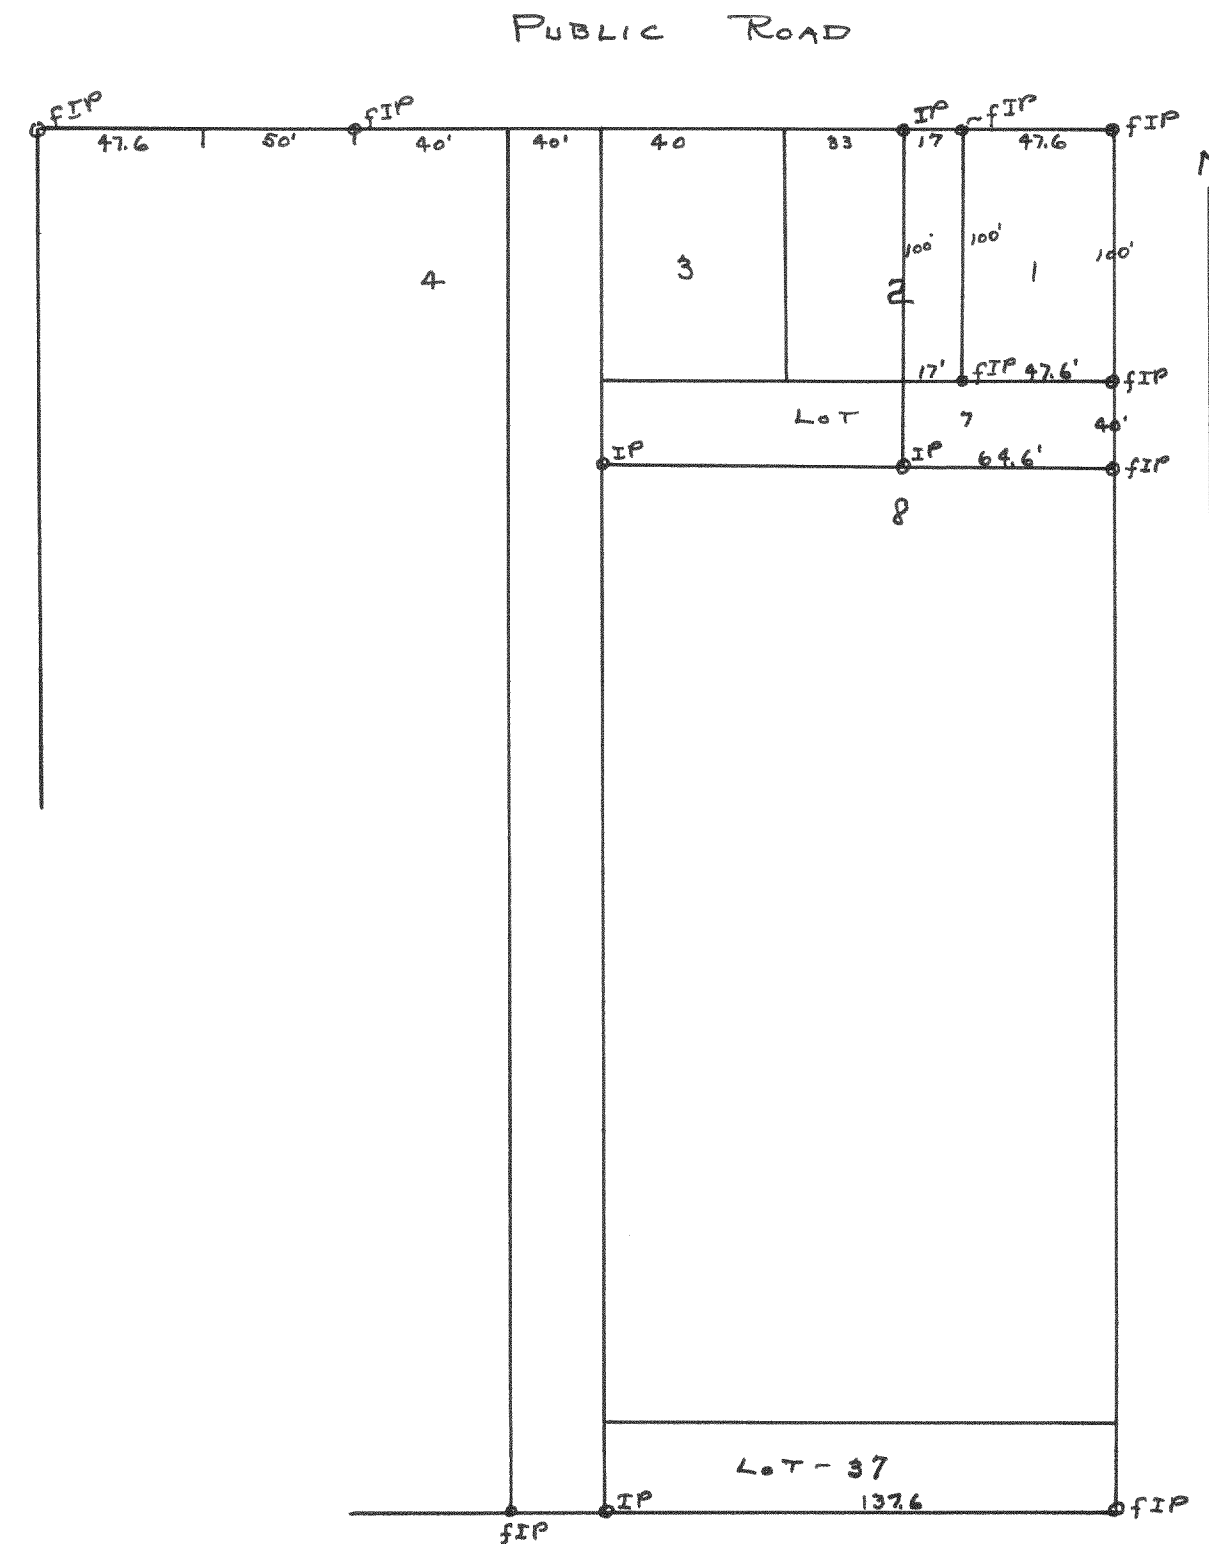

Plot of survey of Lots 1, E. 17' of 2, E 64.6' of 7
and all of Lots 8 to 37 inclusive of Paradise Vista Subd. Sec. 1-1-17

Mar. 28, 1943

Lloyd L. Jensen
County Surveyor