



#1375

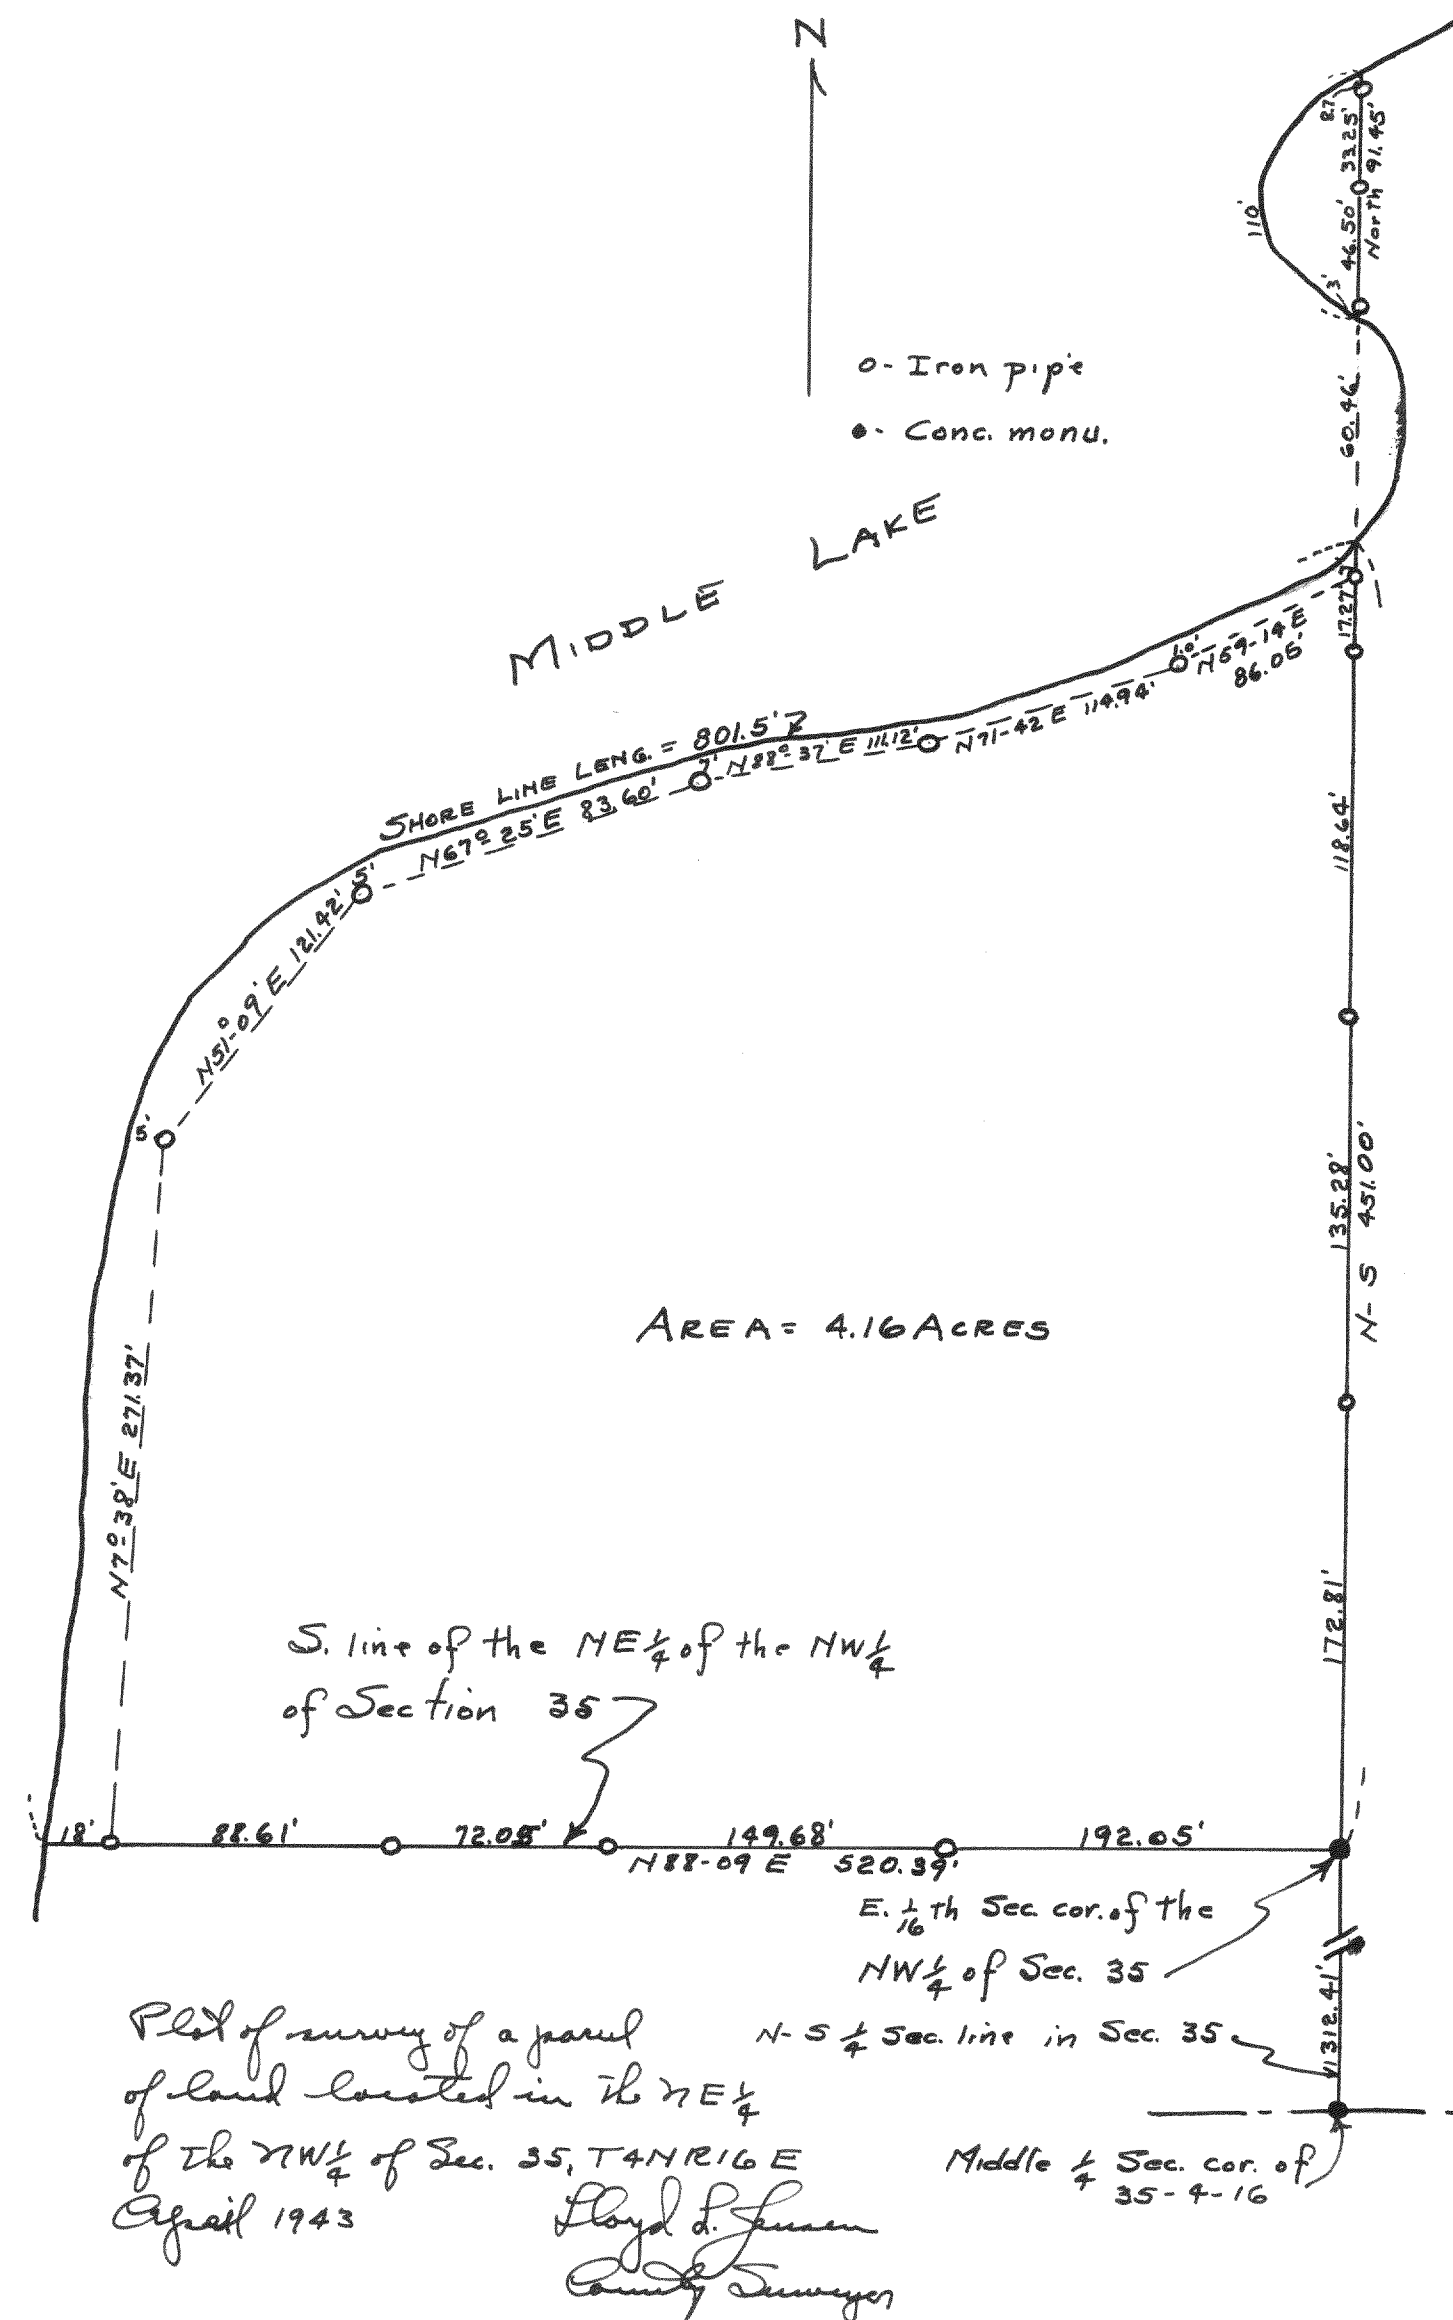

#1376

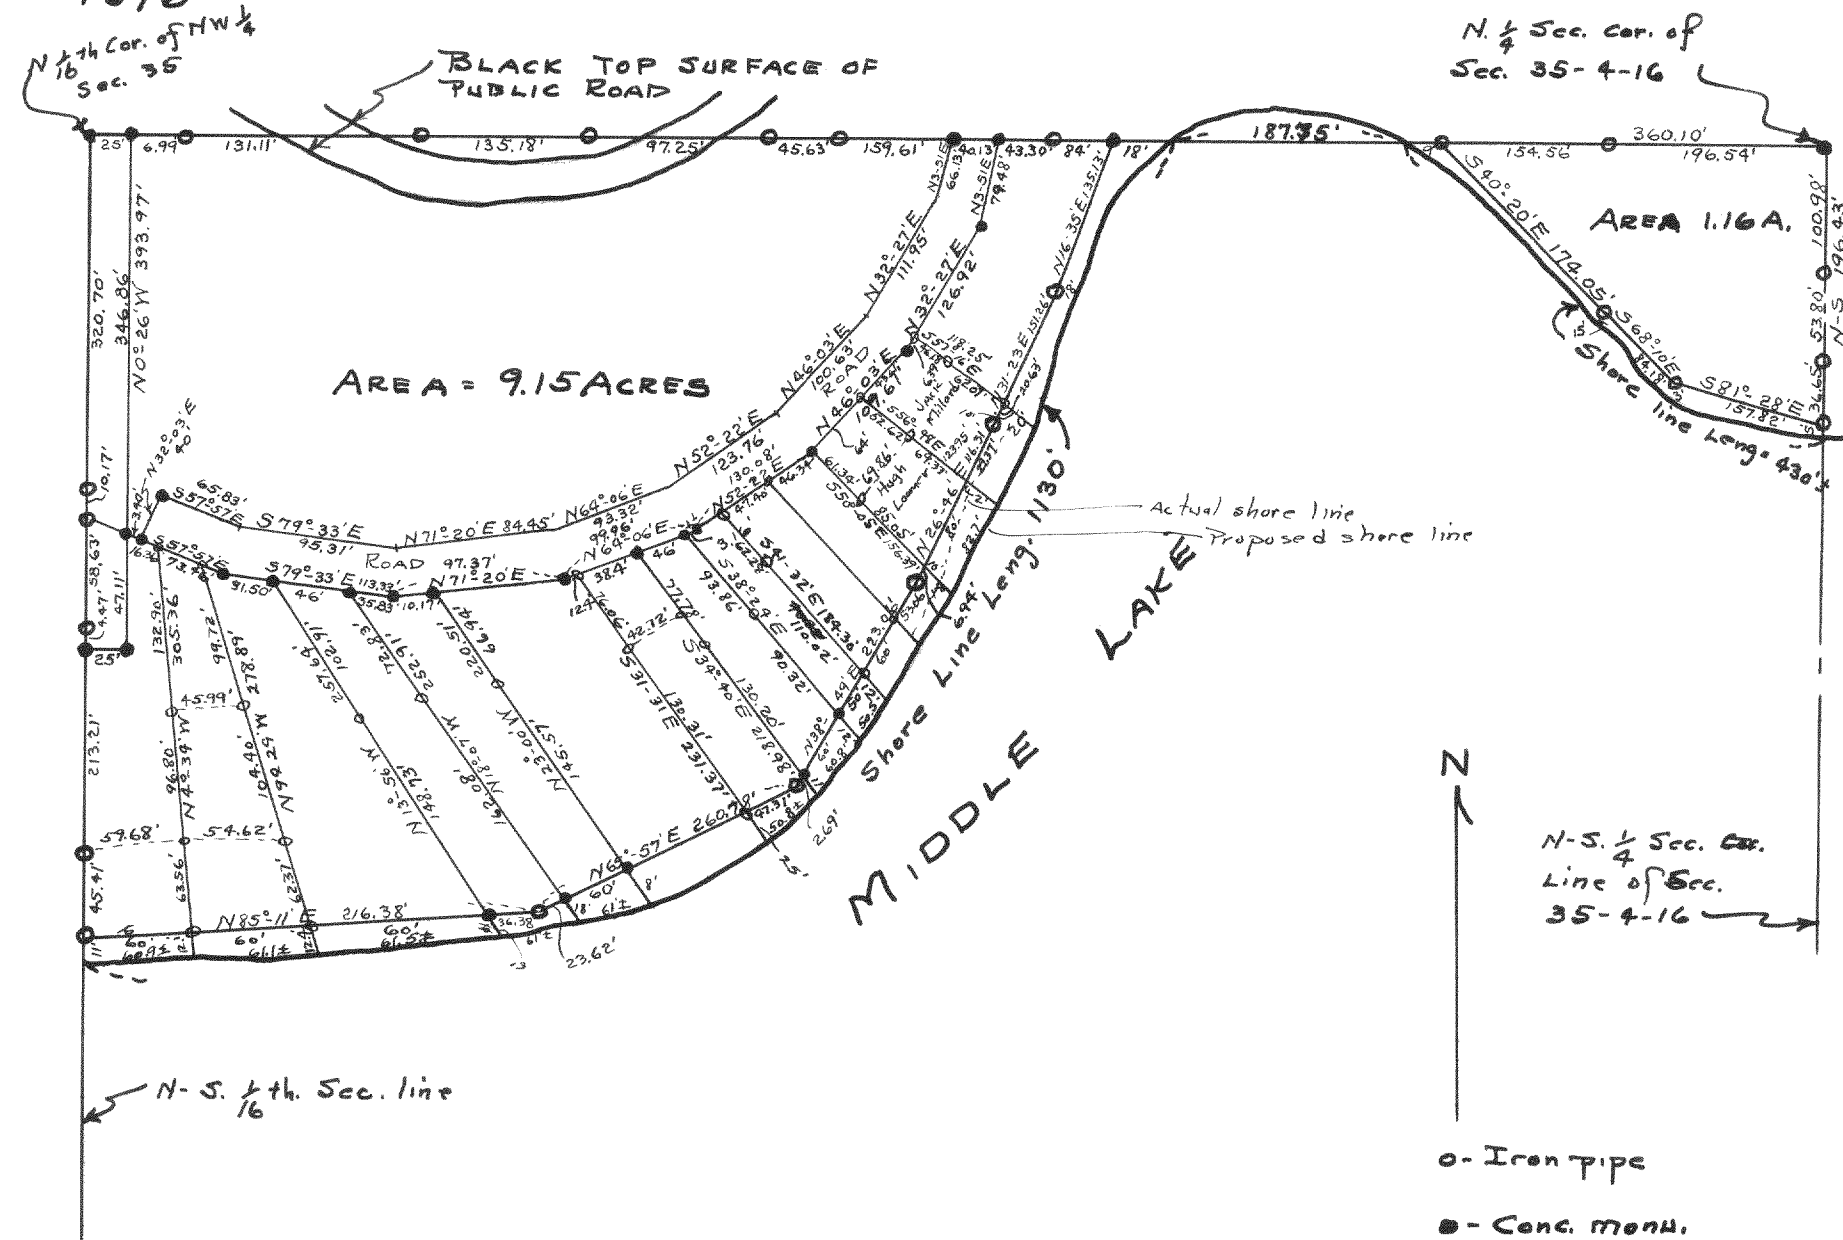

Plot of survey of land located in the
Northeast $\frac{1}{4}$ of the Northwest $\frac{1}{4}$ of Section 35,
T4N R16E.

April & July 1943

Lloyd S. Jensen
County Surveyor