



#1384

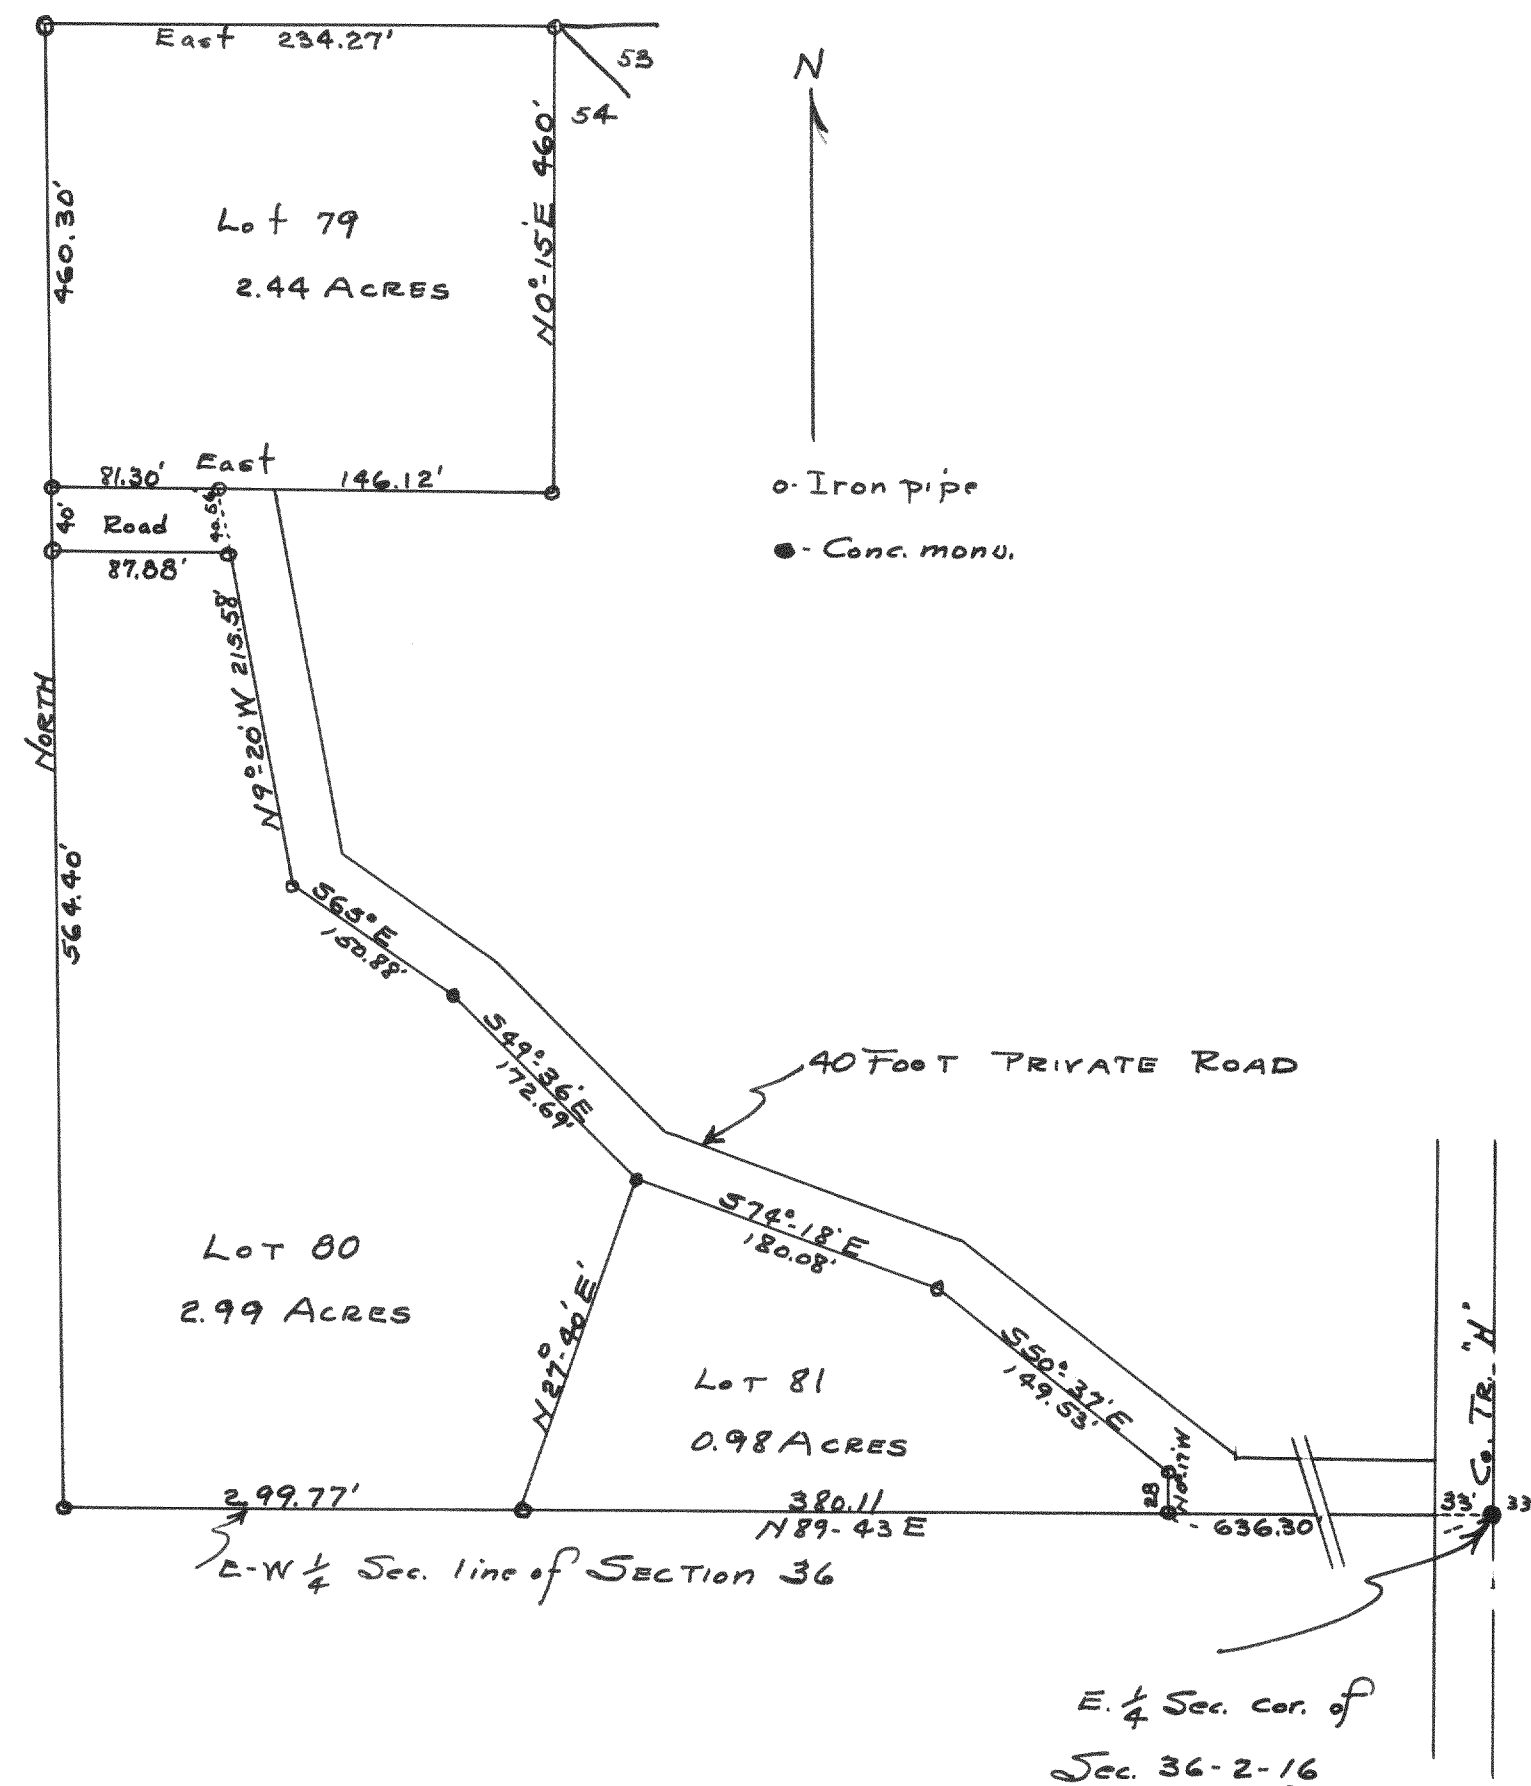

Plot of survey of land located in the  
East  $\frac{1}{2}$  of the Northeast  $\frac{1}{4}$  of Section 36, T27N R16E.  
June 1943  
Lloyd D. Jensen  
County Surveyor

#1385

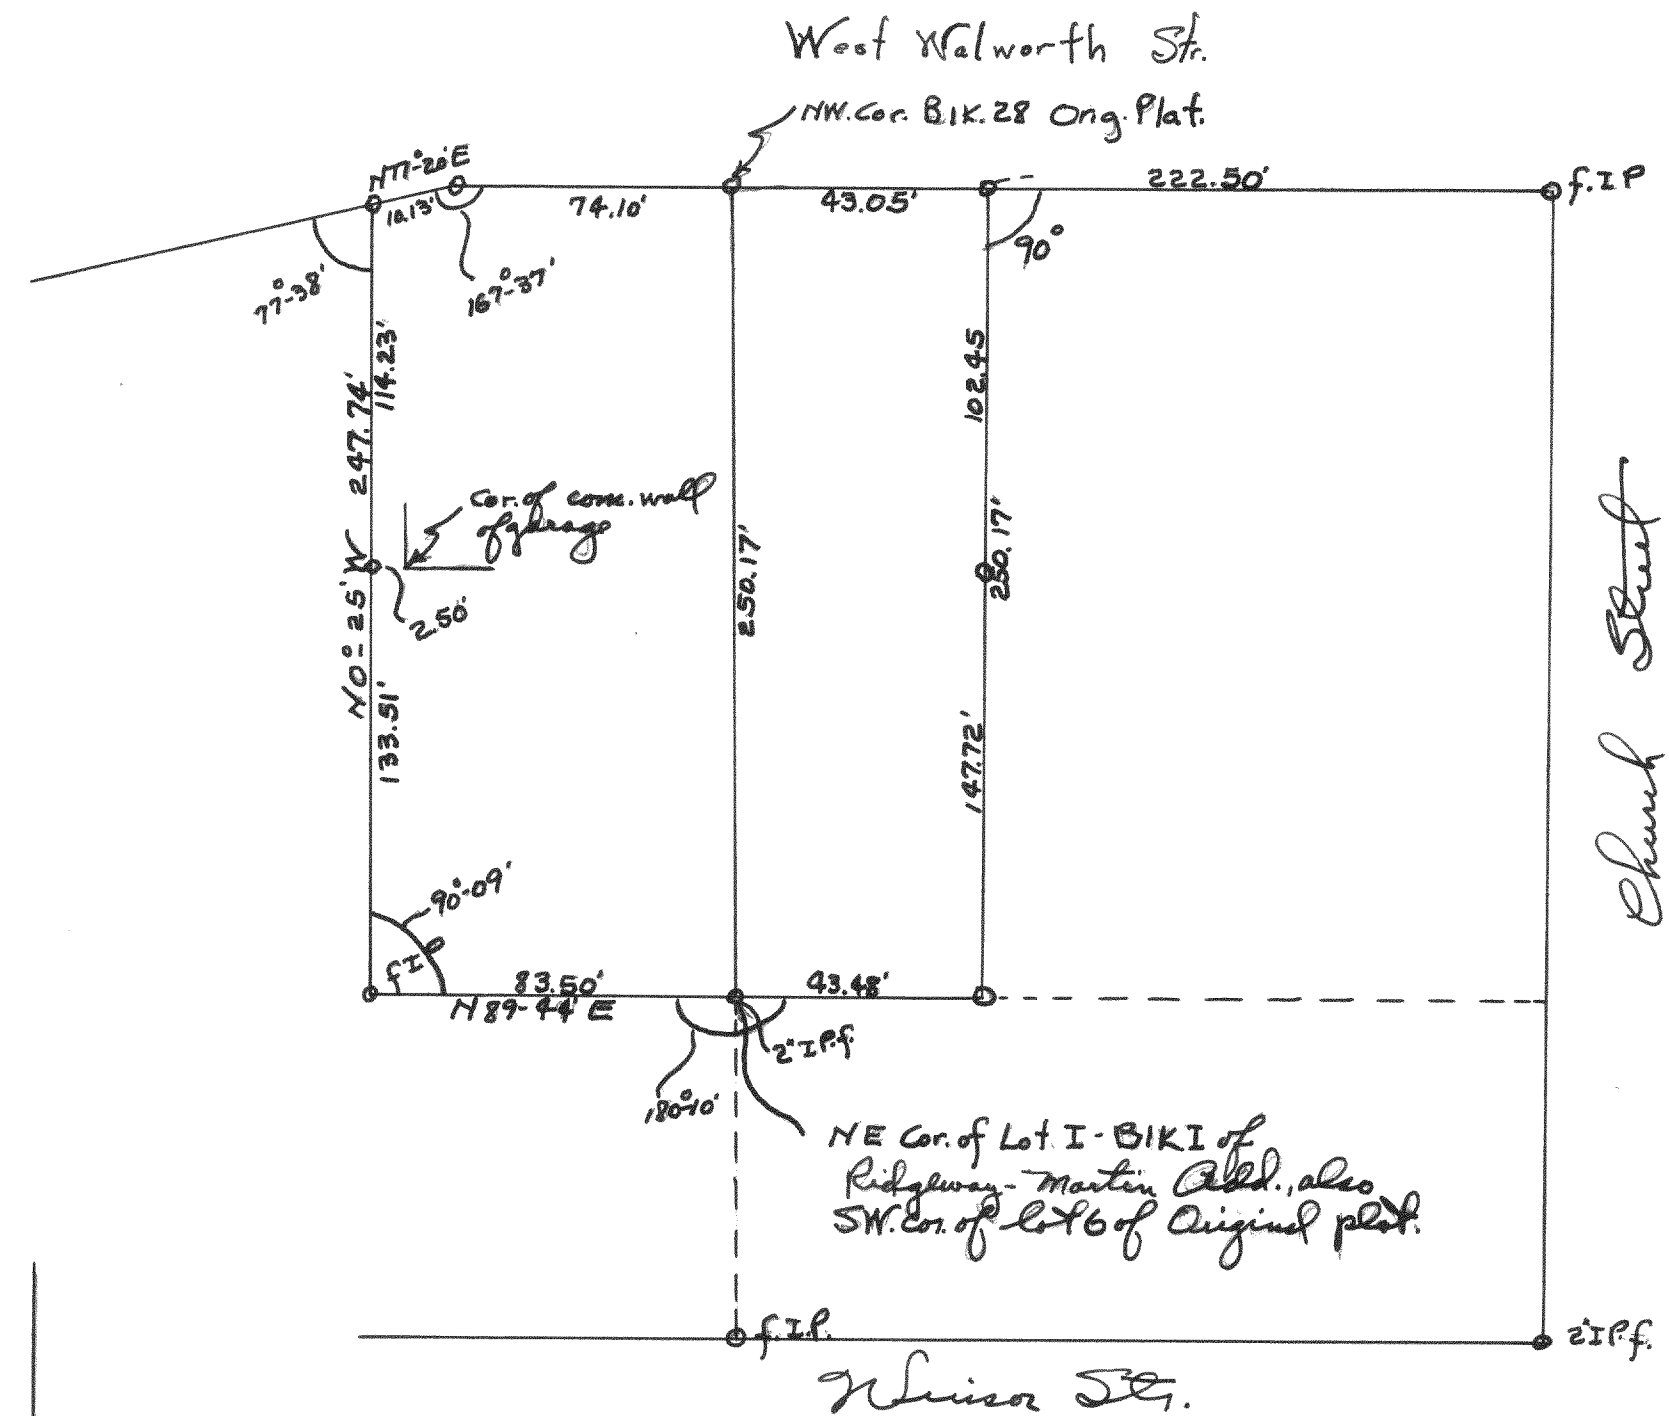

Plot of survey of the Mather property  
on West Walworth Street in the City of  
Elkhorn,  
June 6, 1943  
Lloyd D. Jensen  
County Surveyor