



#1388

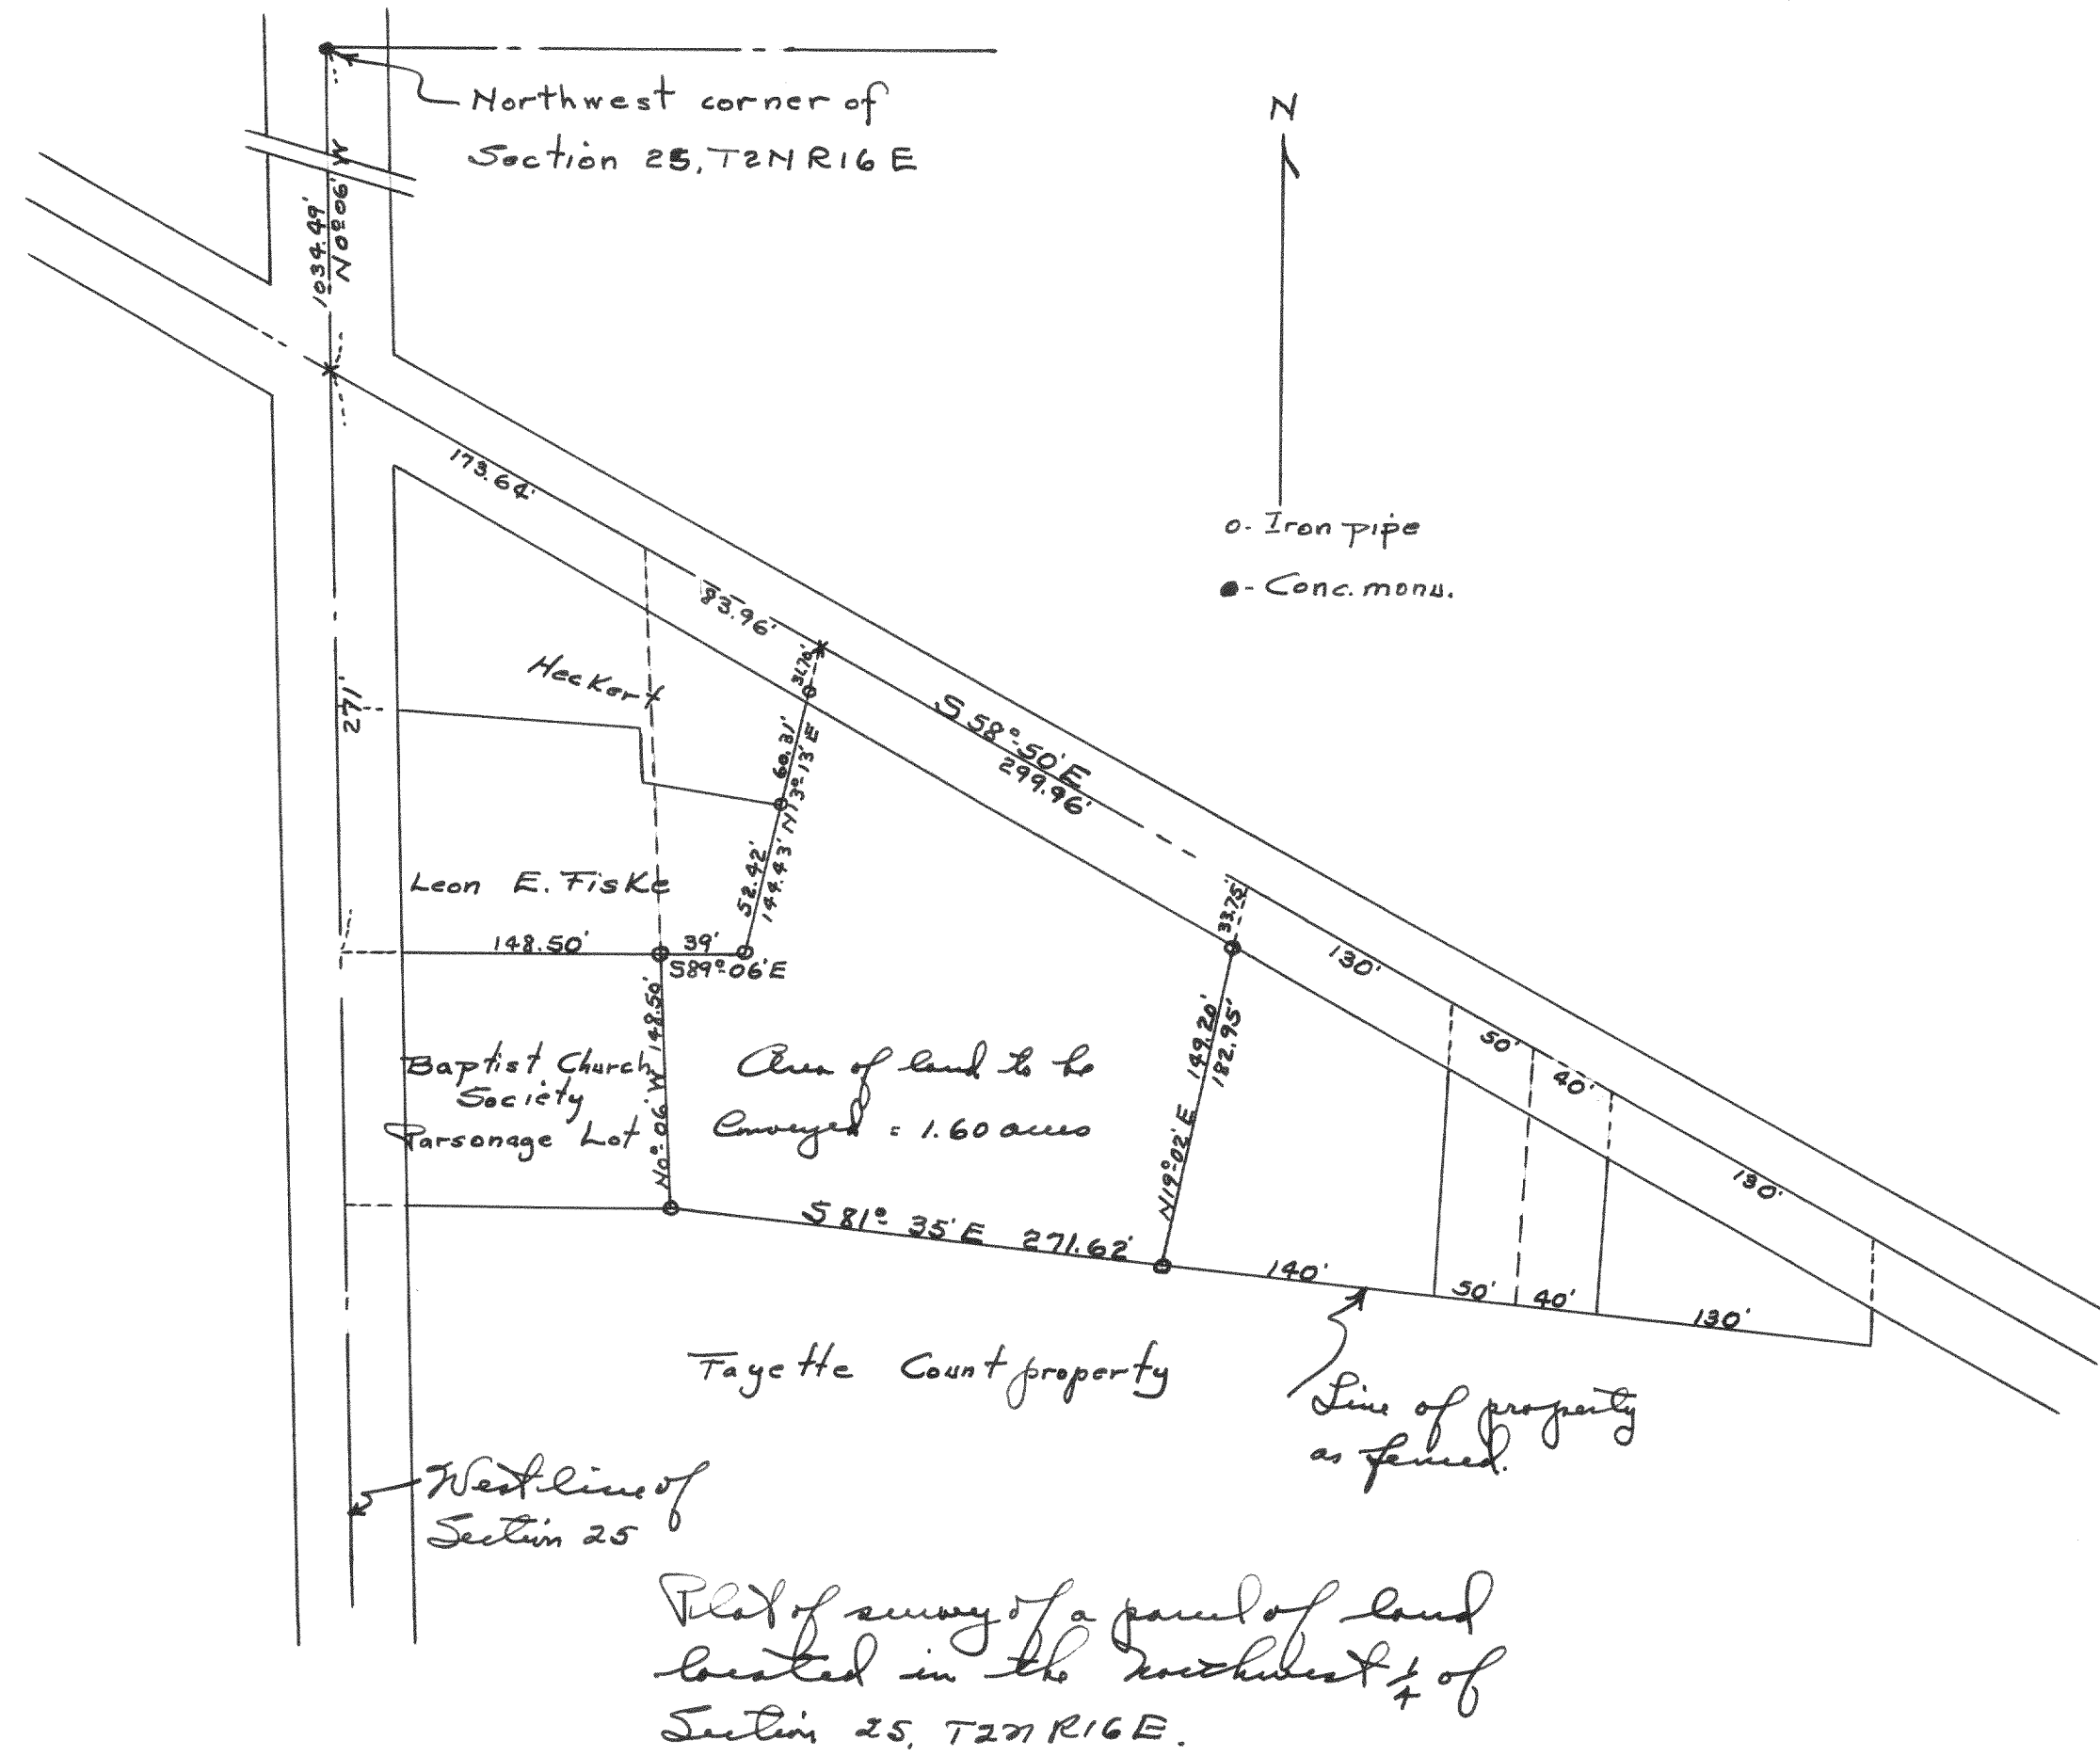

July 1943

Lloyd S. Jensen
County Surveyor

#1389

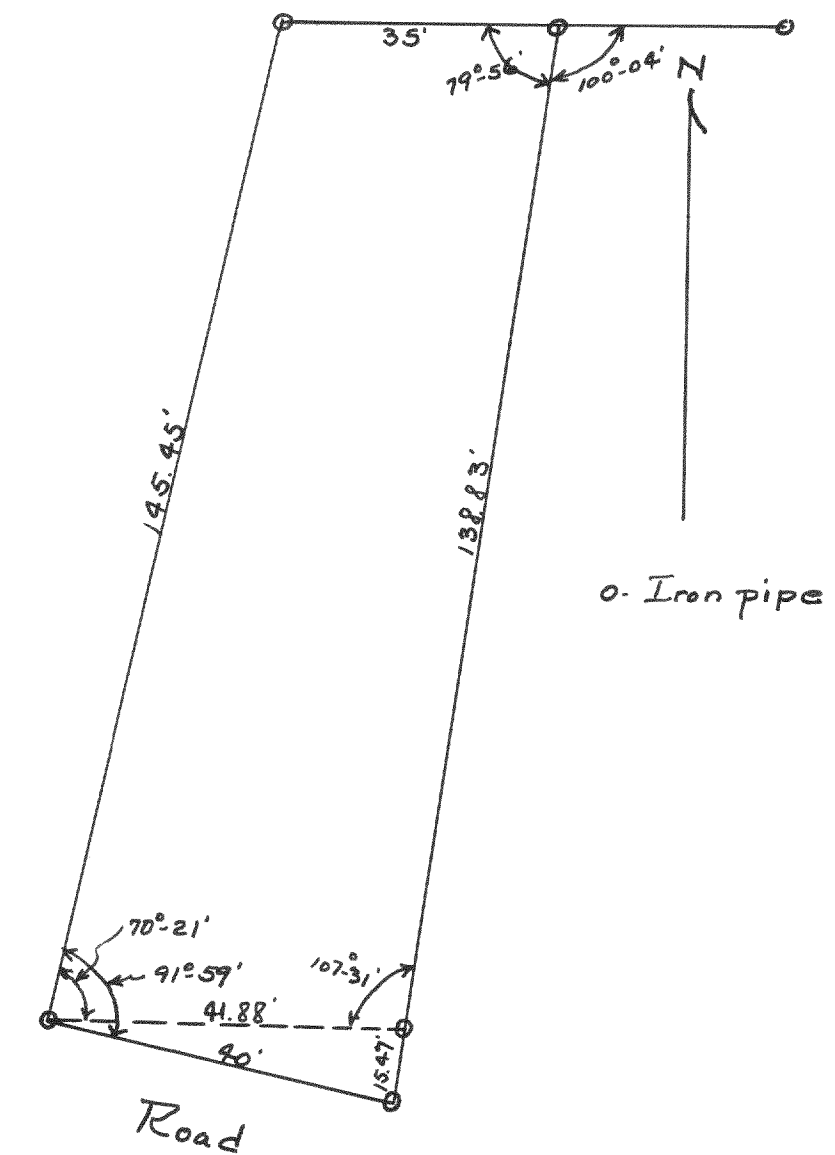Plot of survey of Lot 12 of
Block F of Arco Beach
Subd.

July 29, 1943

Lloyd S. Jensen
County Surveyor