


#1390

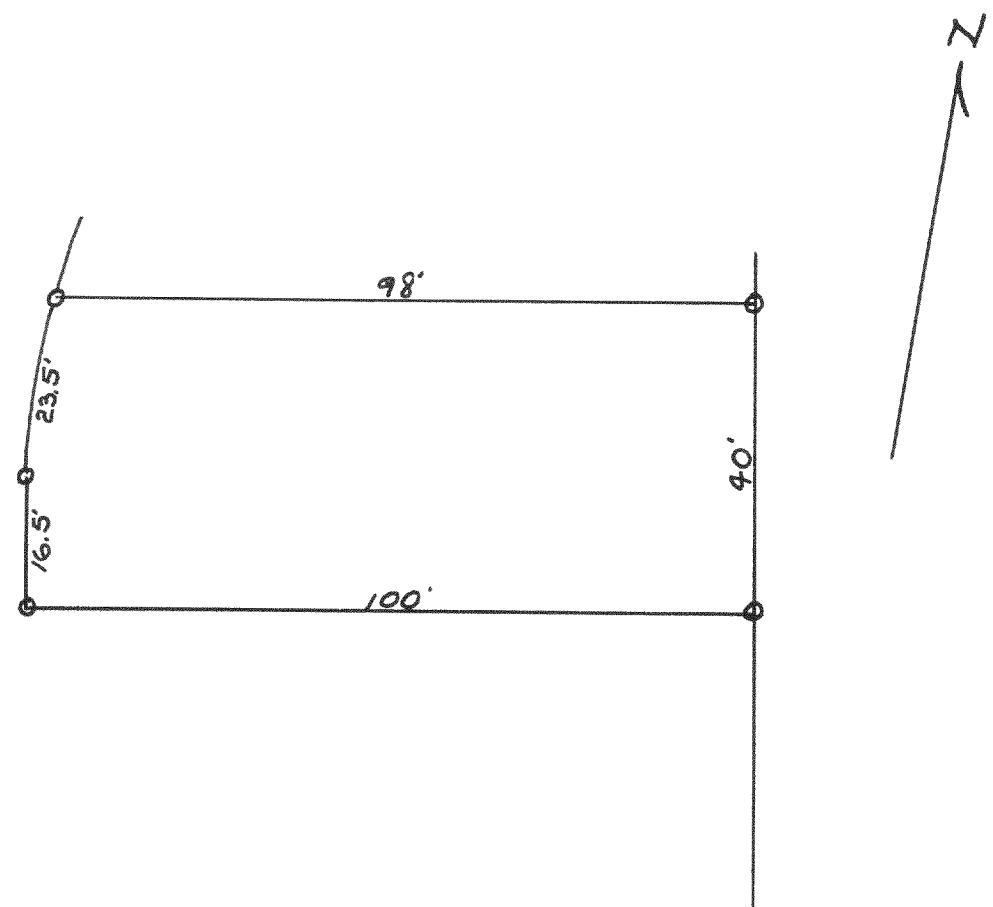


Plot of survey of Lot 8 of Block D
of Creso Beach Subdivision, Section 5,
T17N R17E.

Aug. 5, 1943

Floyd L. Jensen
County Surveyor

#1391

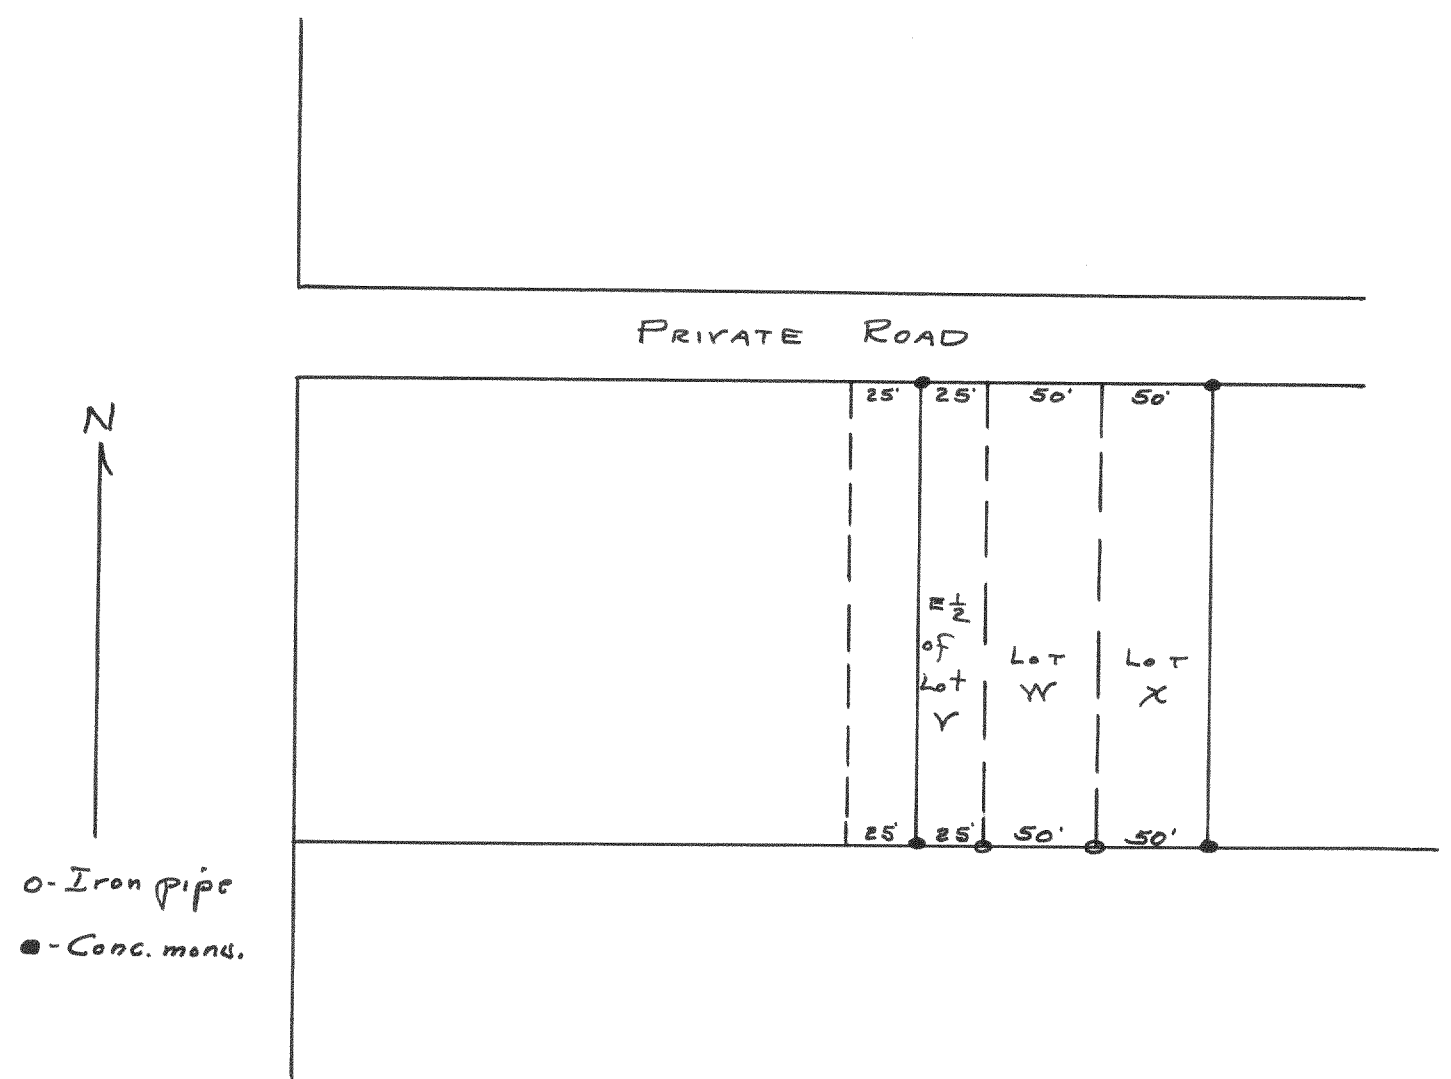

Plot of survey of Lots X, W and the East $\frac{1}{2}$
of Lot Y of Lock Vista Club Subd. No. 2.

July 19, 1943

Floyd L. Jensen
County Surveyor