


#1393

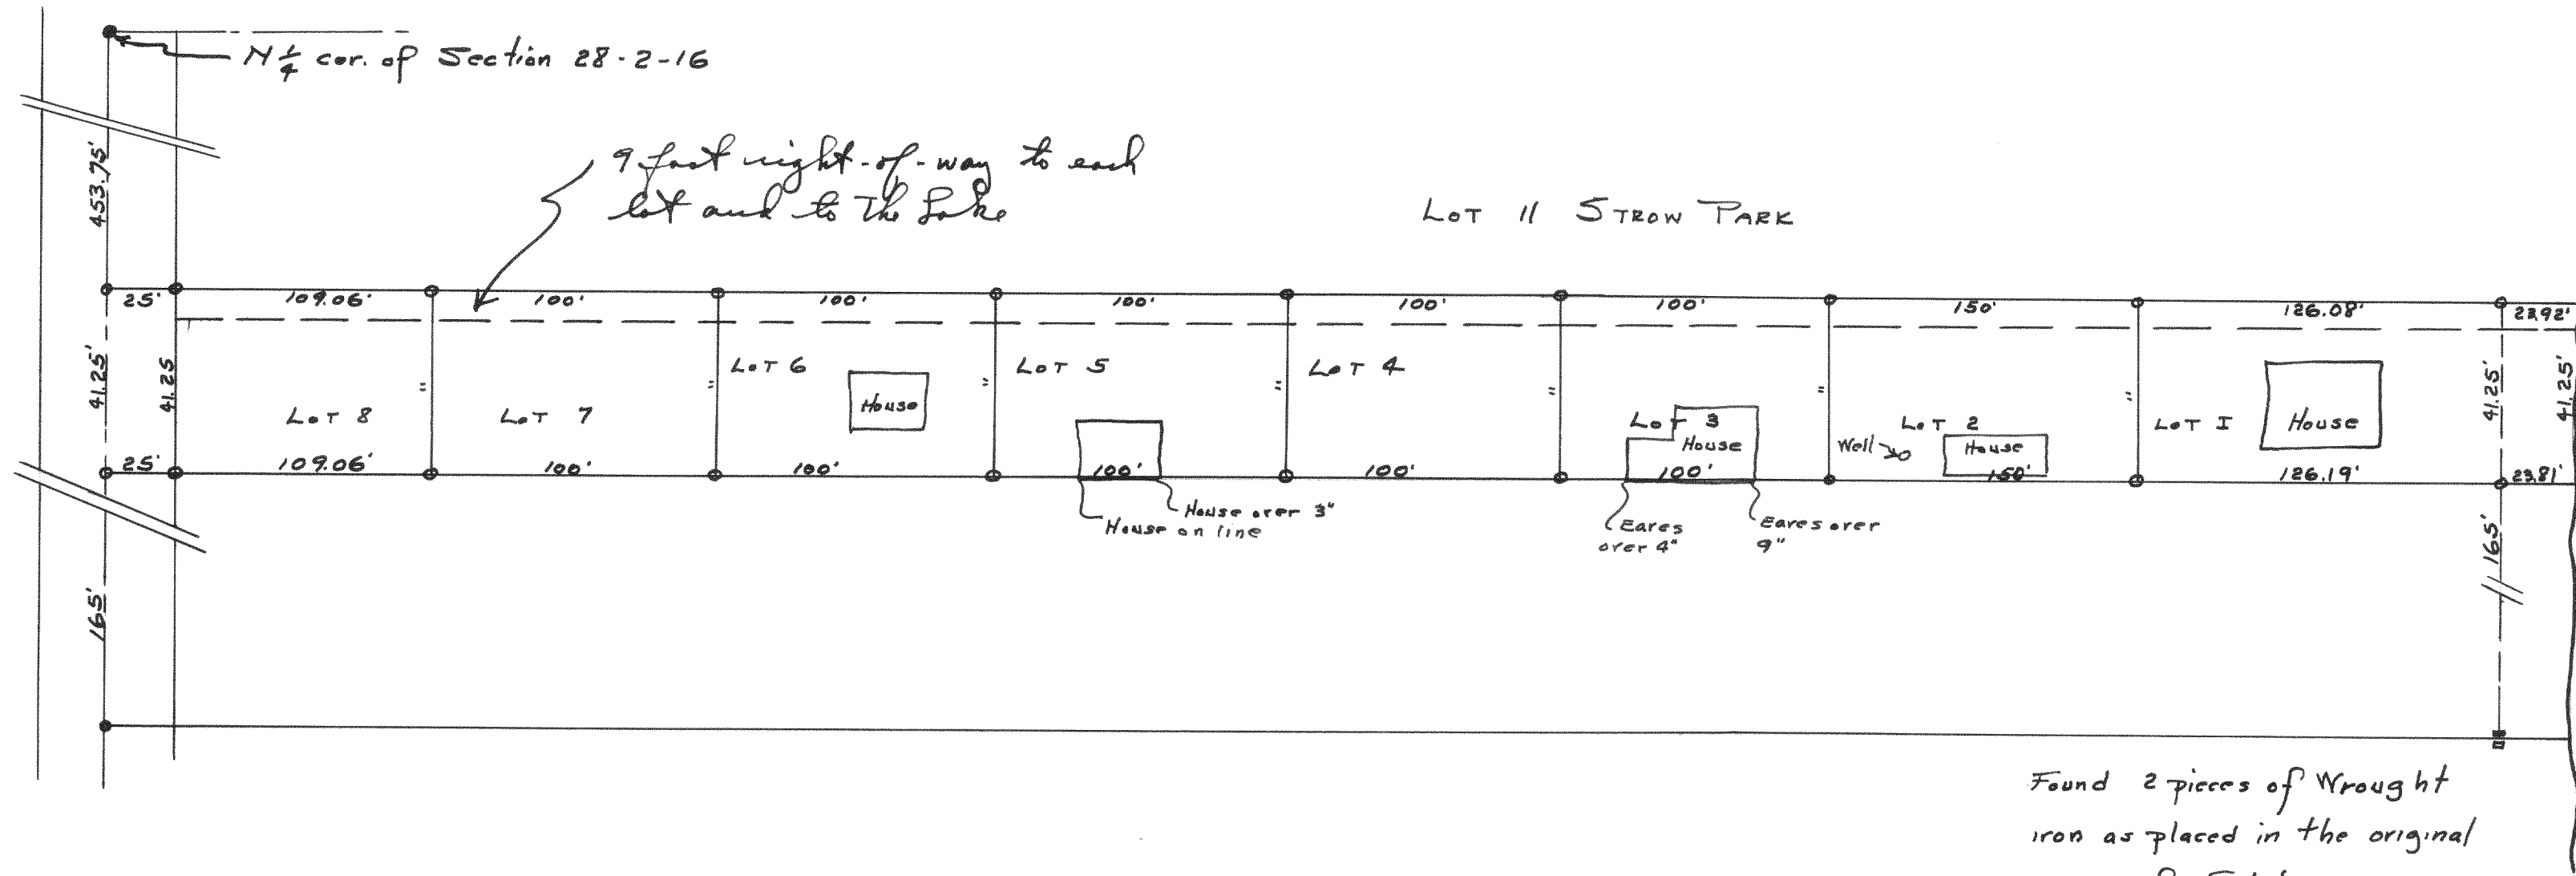

Found 2 pieces of Wrought iron as placed in the original survey of Subd.

Survey of Lot 12 of Strow Park and dividing of it into 8 lots.

July 1943

Lloyd L. Jensen
County Surveyor