


#1394

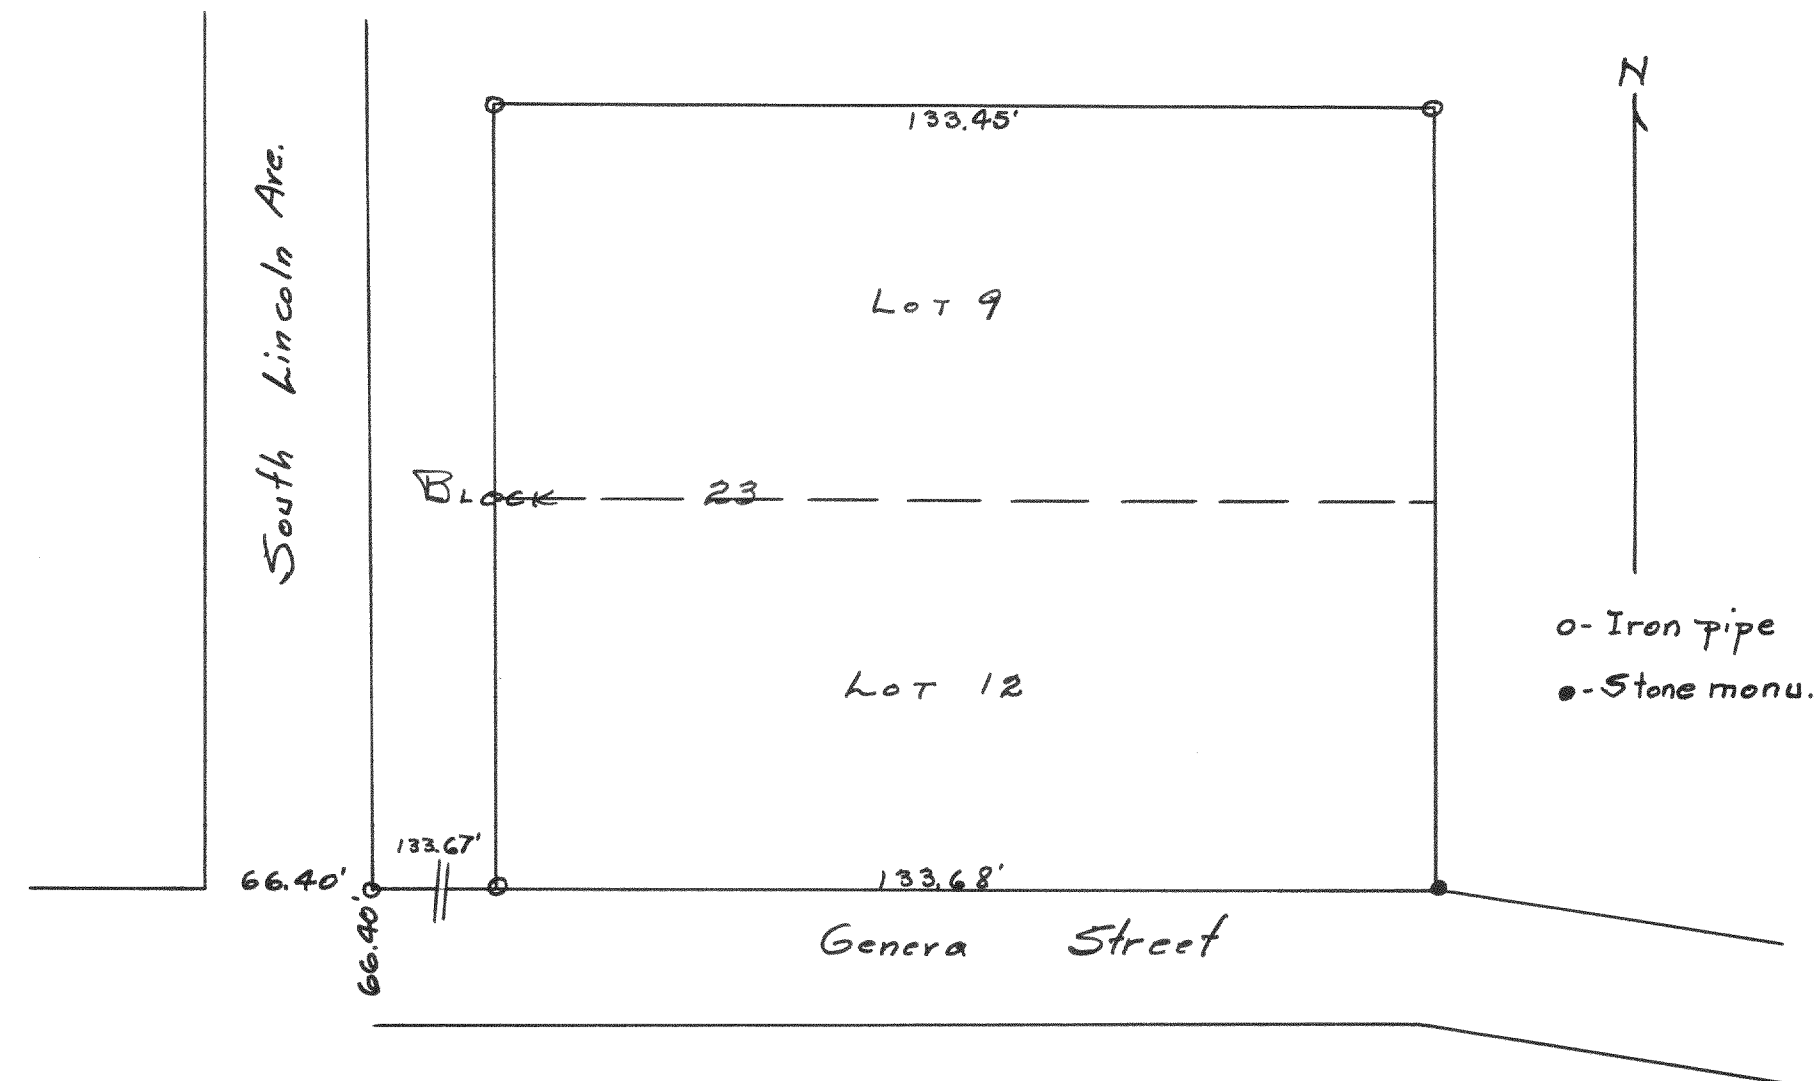


Plot of survey of Lots 9 and 12 of Block 23
of Rockwell's Add. to City of Elkhorn.

June 1943

Lloyd S. Jensen
County Surveyor

#1395

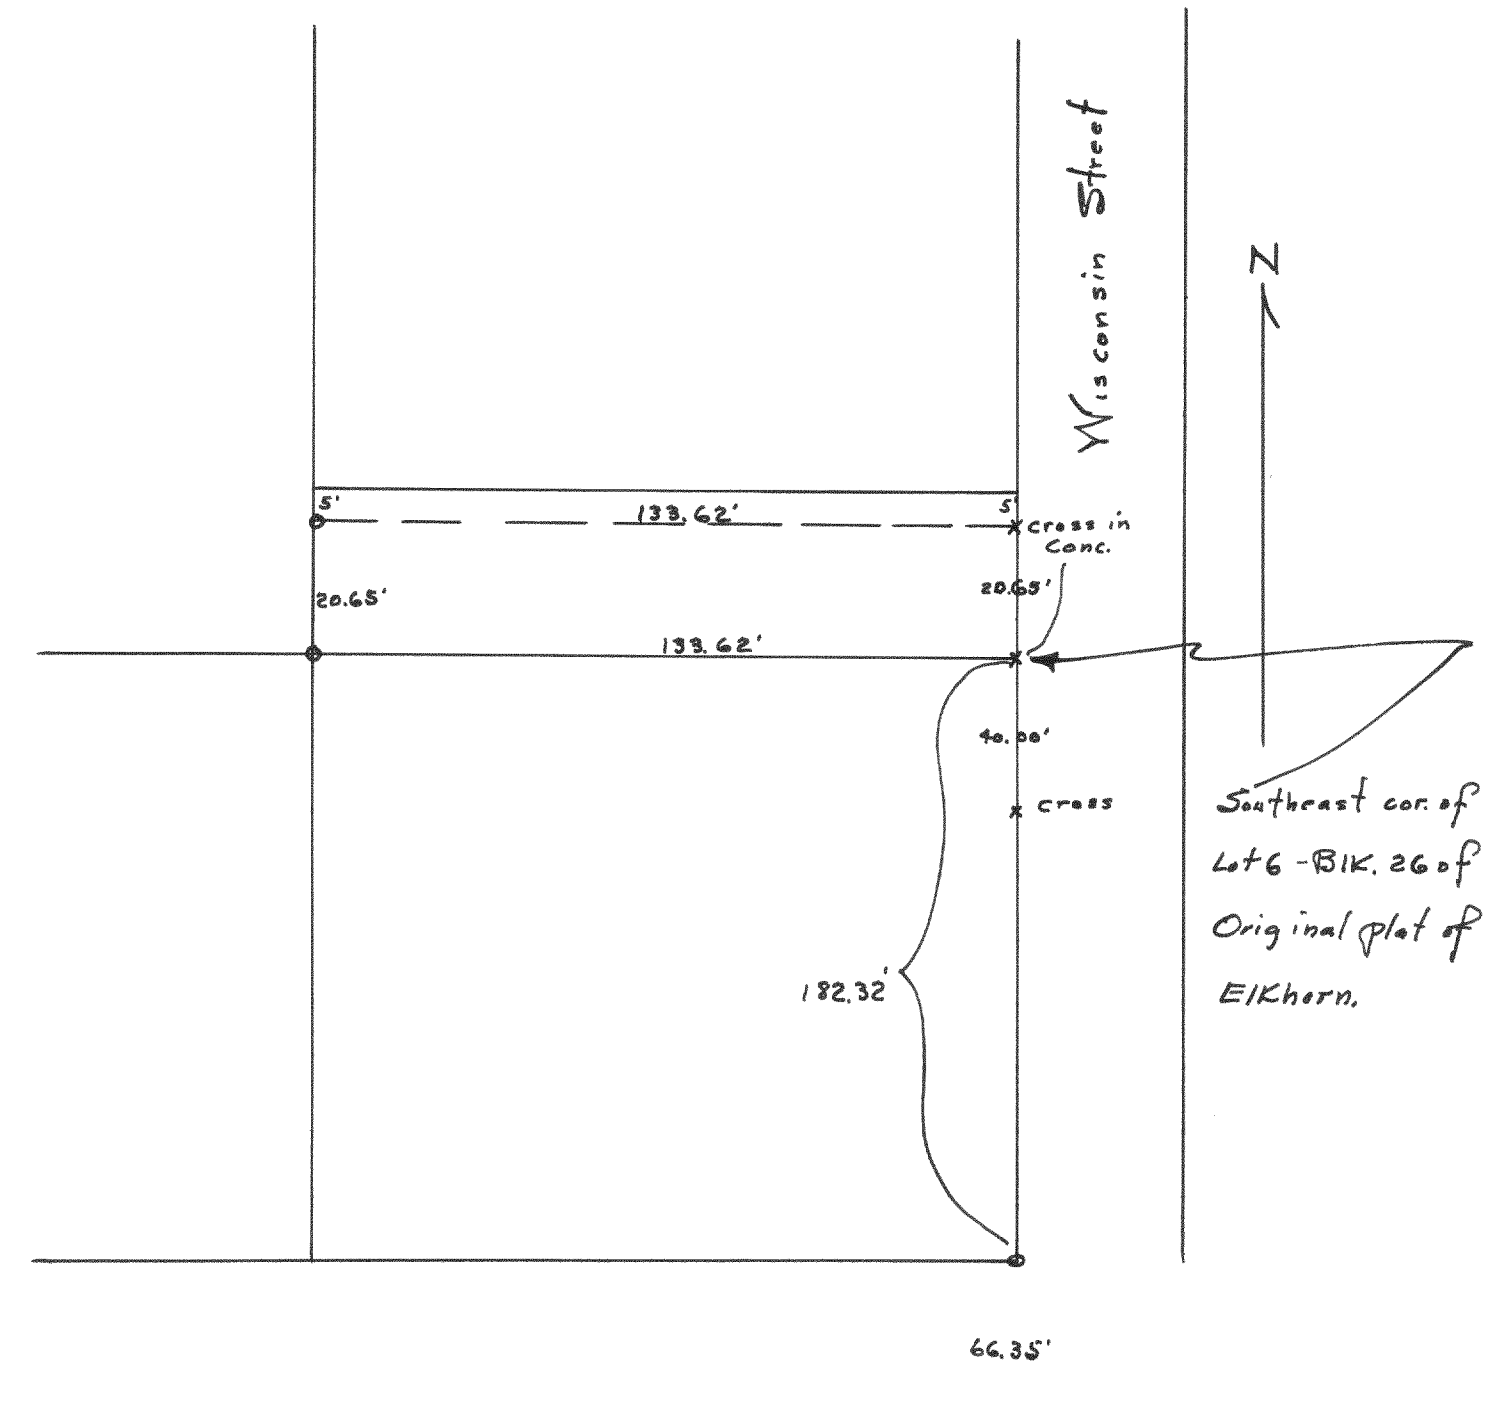

Plot of survey of part of Lot 6
of Blk. 26 of Original plat of
City of Elkhorn.

May 27, 1943

Lloyd S. Jensen
County Surveyor