



#1396

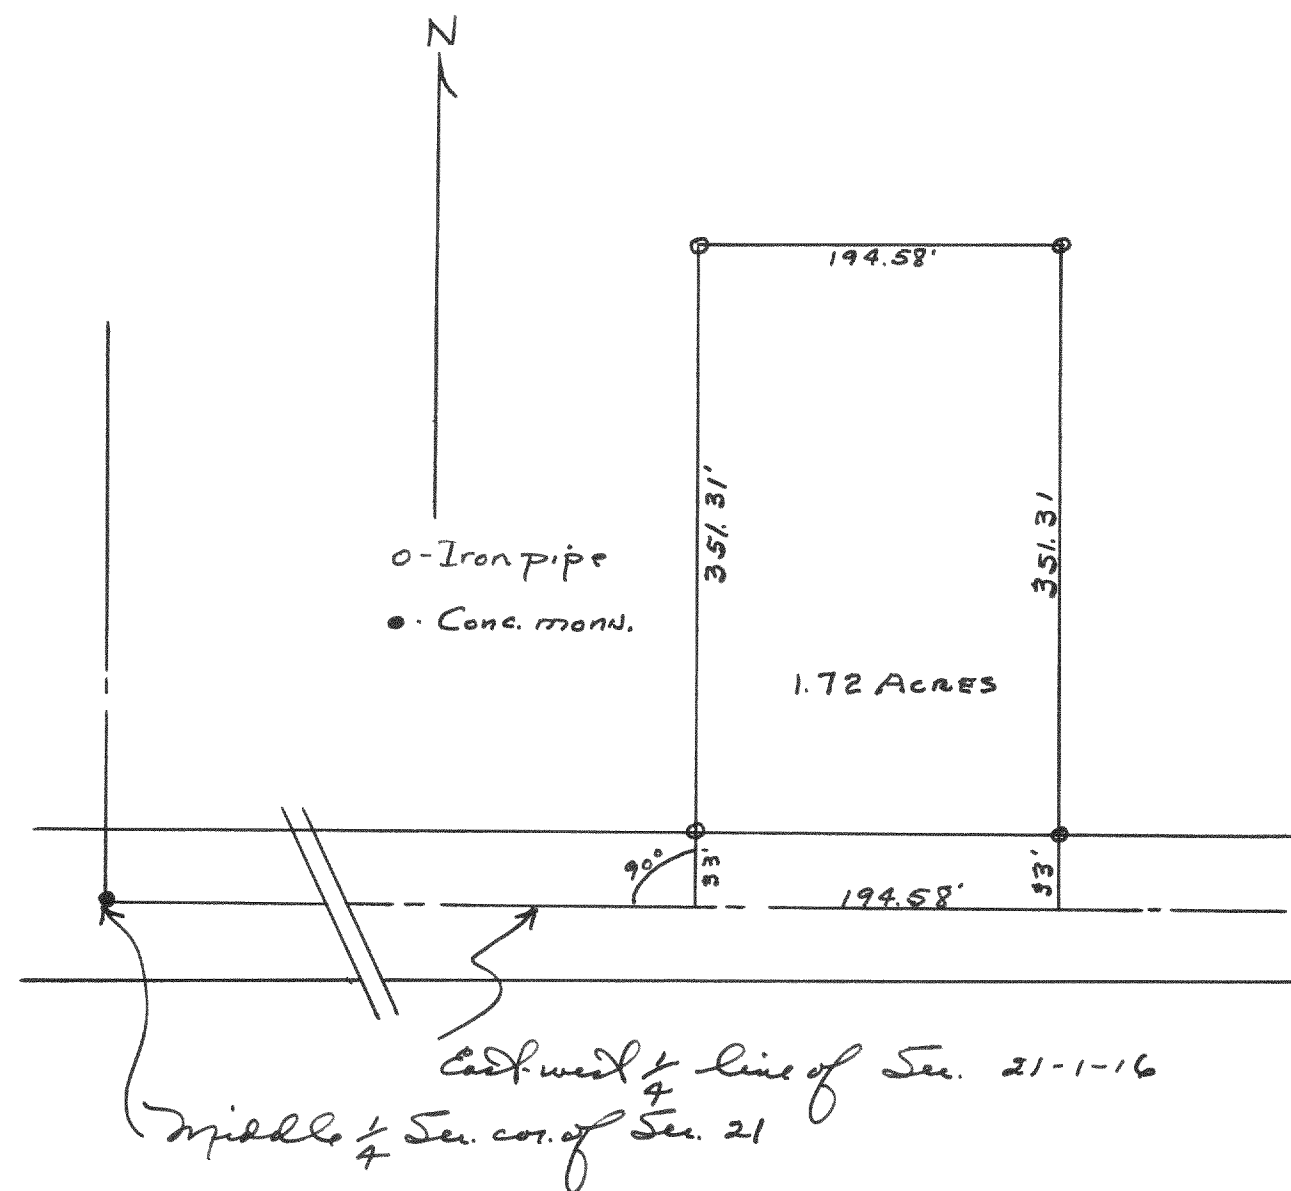

A parcel of land located in the
Southeast $\frac{1}{4}$ of Section 21, T17R16E
of Walworth County Wisconsin
June 2, 1943
Lloyd S. Jensen
County Surveyor

#1397

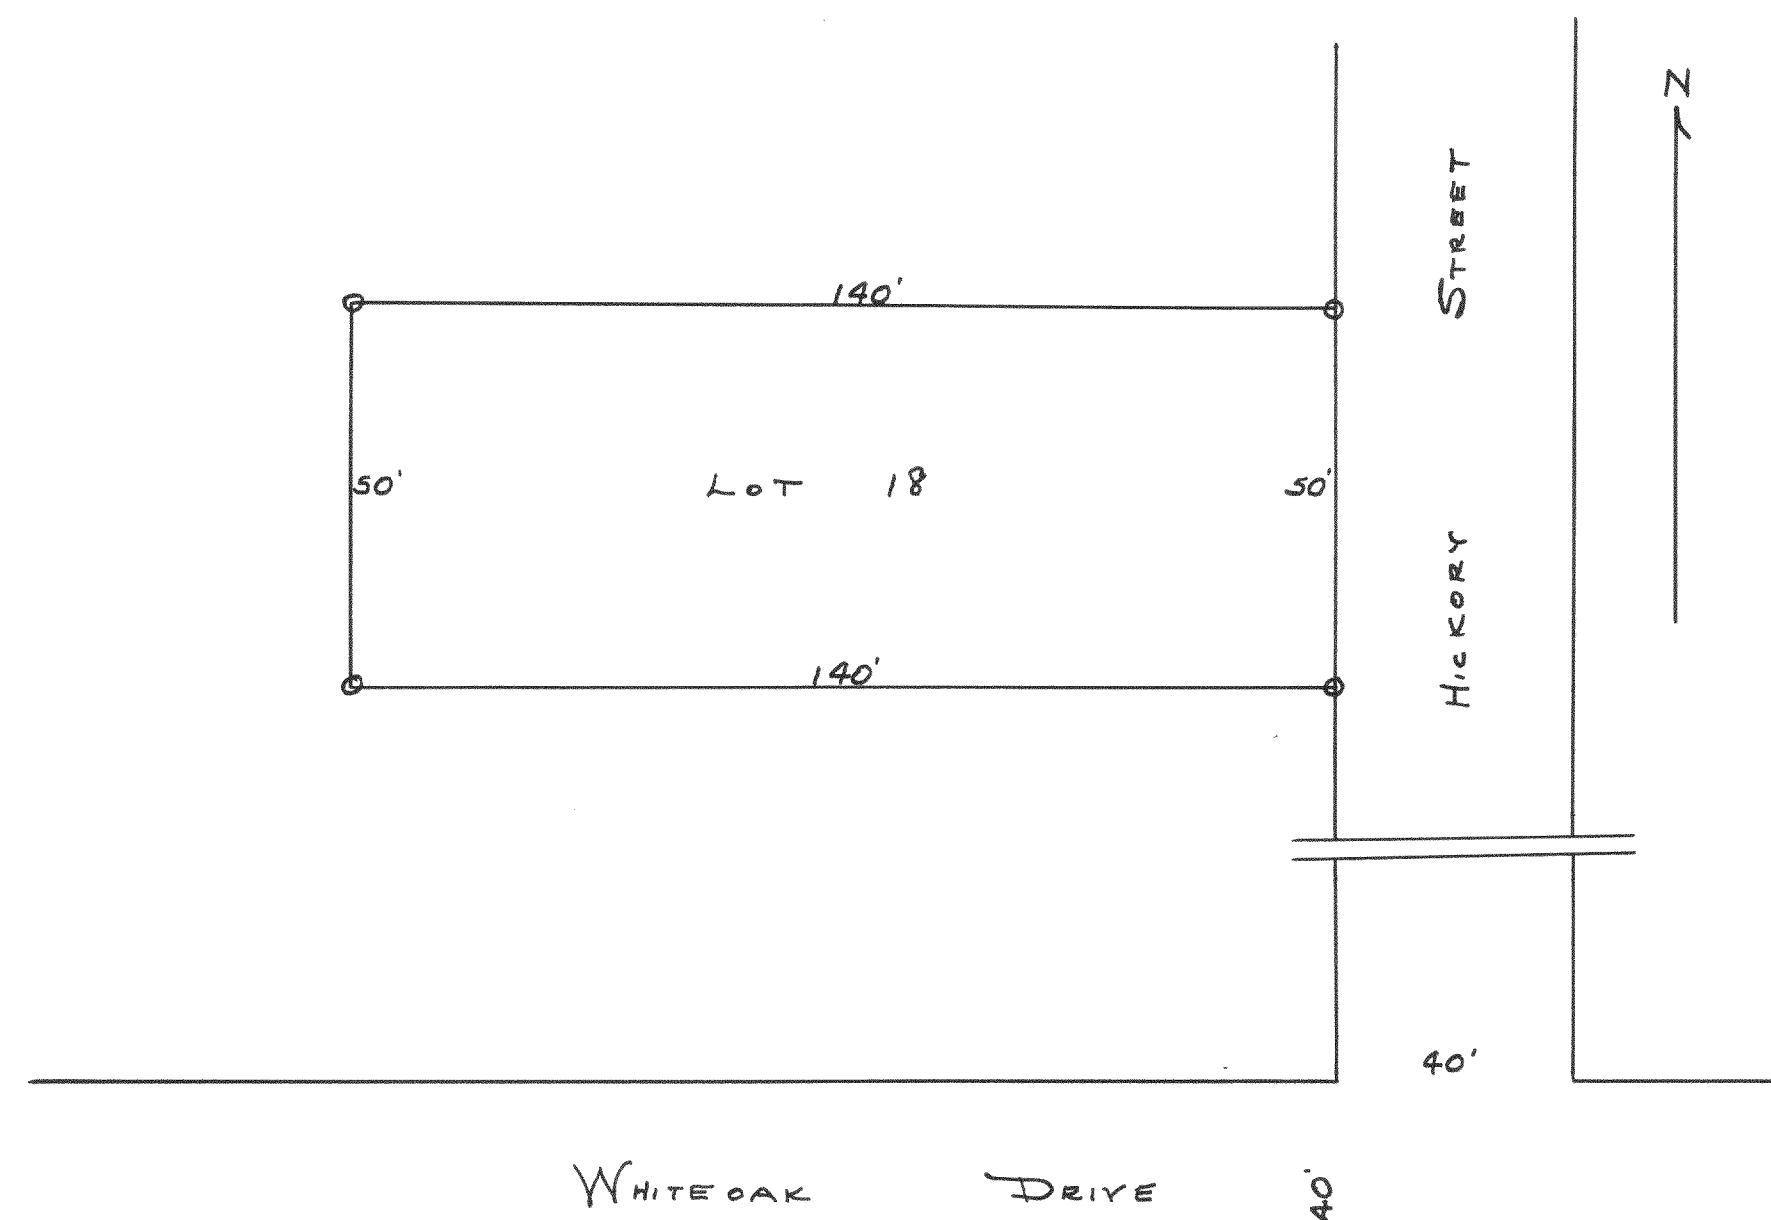

Plot of survey of Lot 18 of Blk. 12 of
The plot of Miramas Subdivision.
June 1943
Lloyd S. Jensen
County Surveyor