


#1400

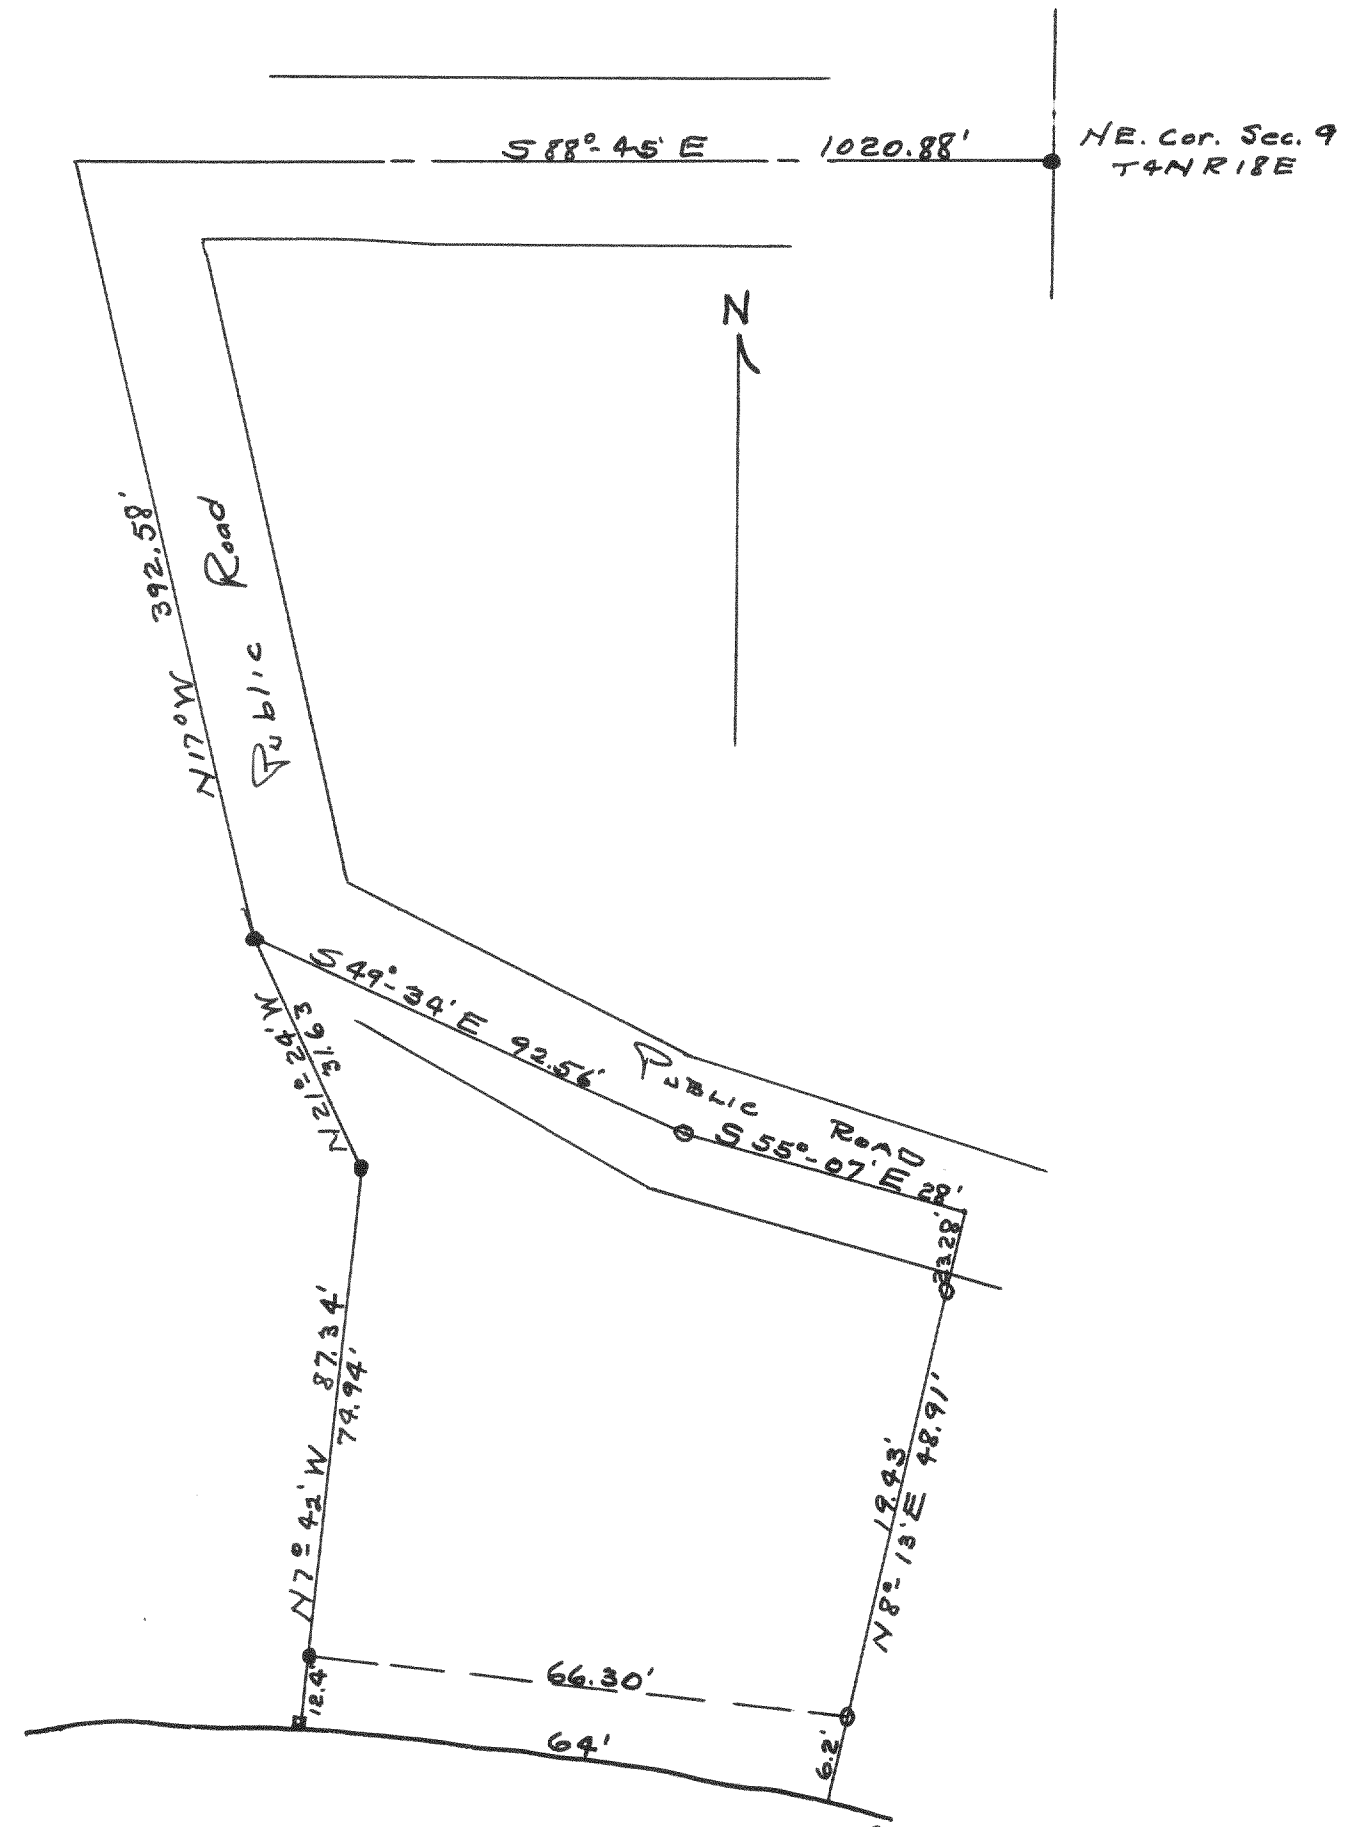


Plot of survey of a parcel of land located in the Northeast fractional $\frac{1}{4}$ of Section 9, T4N R18E.

April 1943

Lloyd L. Jensen
County Surveyor

#1401

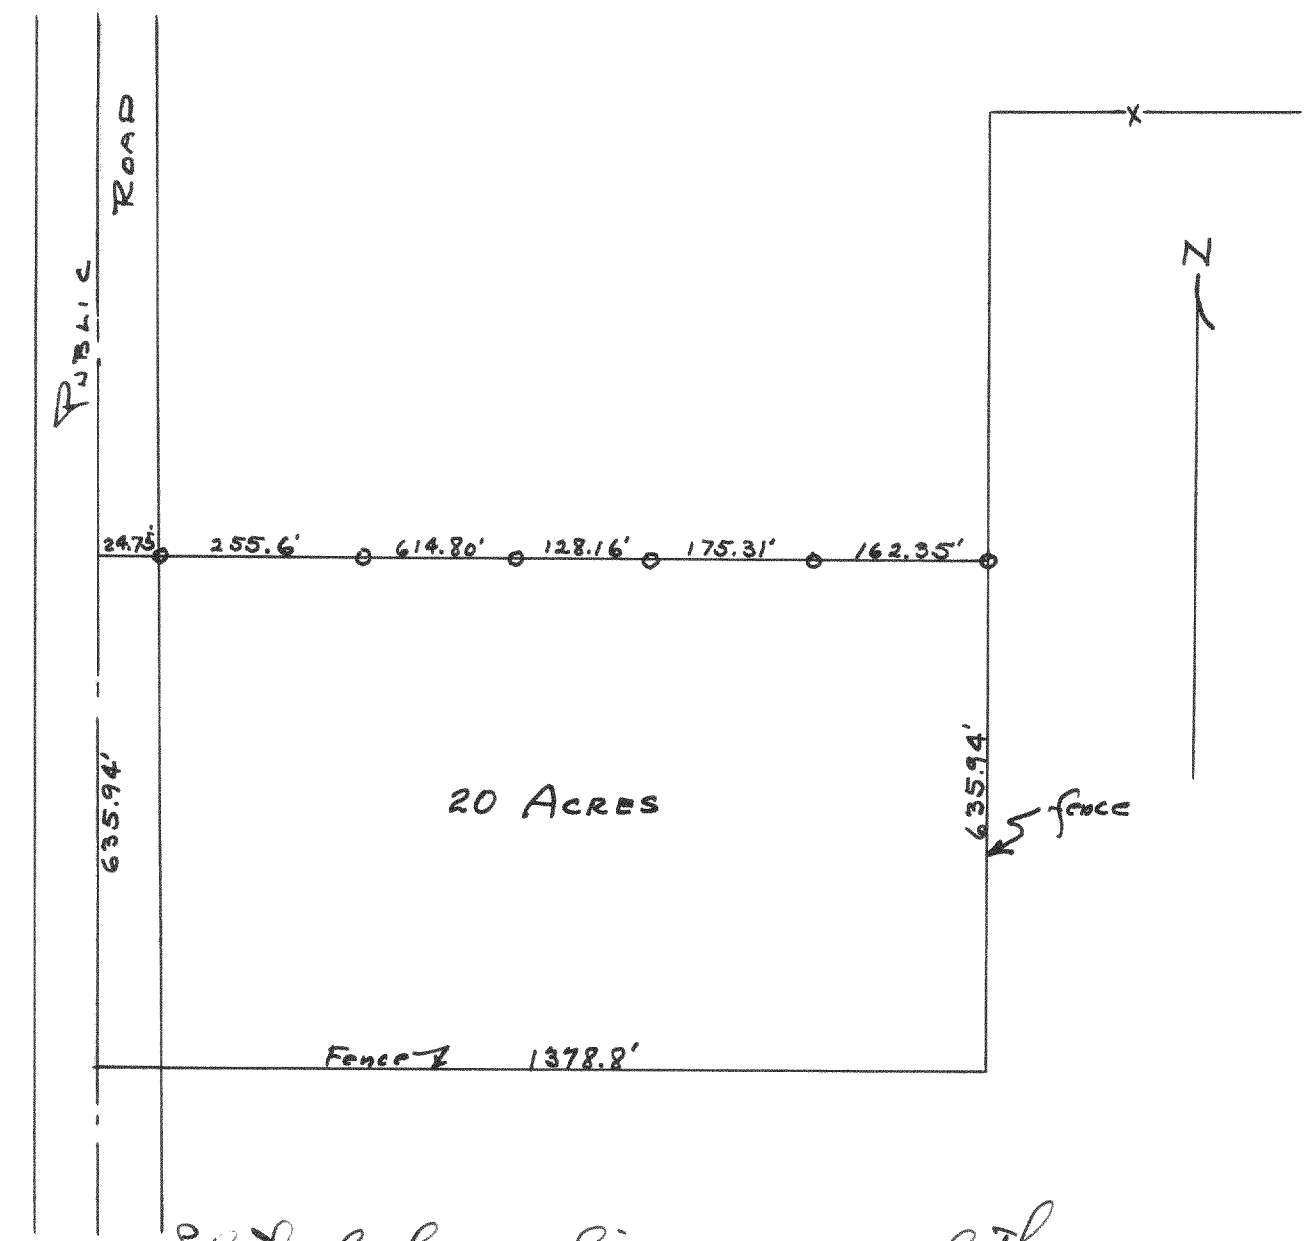

Plot of fence line survey of the South 20 acres of the West $\frac{1}{2}$ of the Southwest $\frac{1}{4}$ of Section 6, T3N R16E.

April 2, 1943

Lloyd L. Jensen
County Surveyor