


#1402

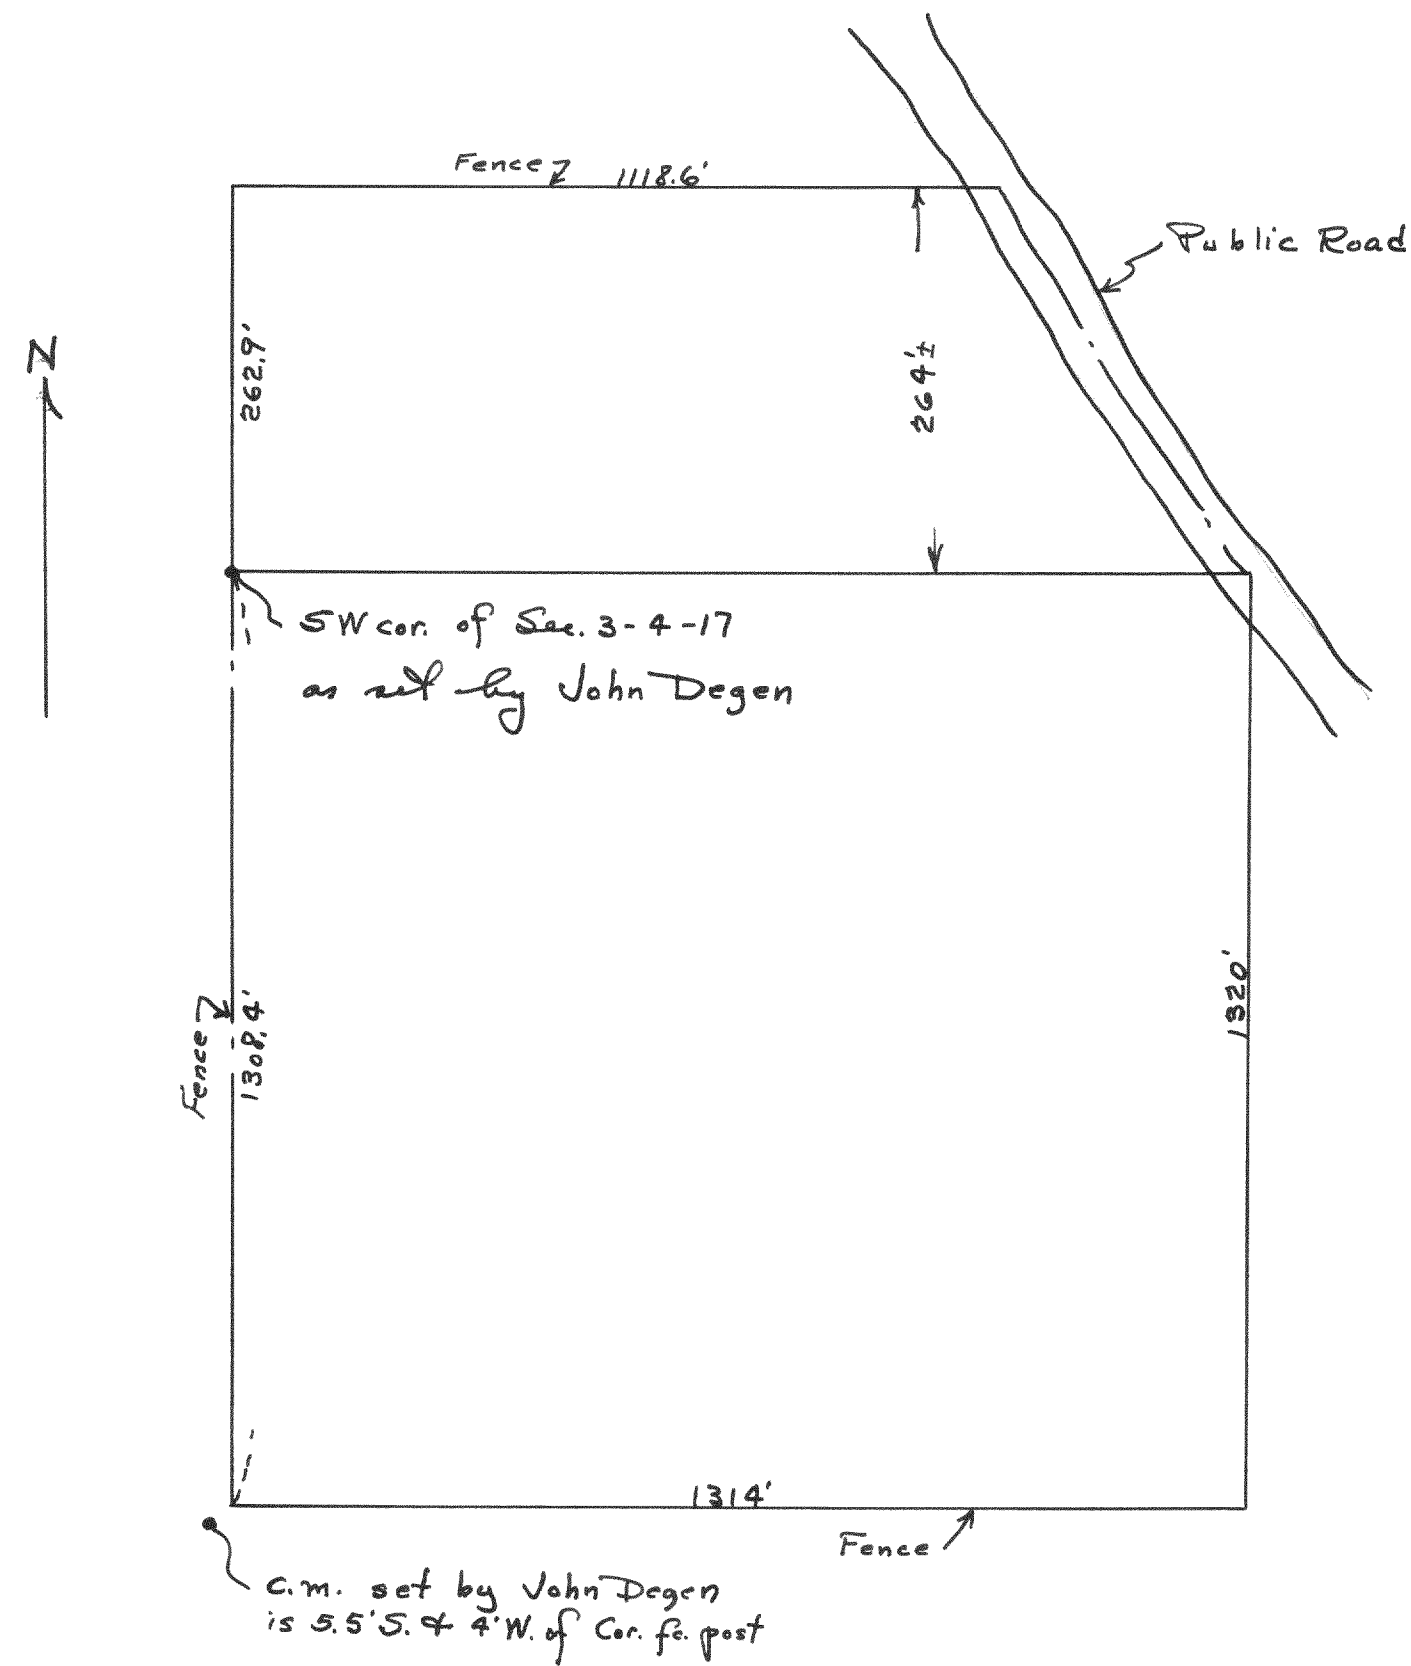


Plot of survey of fence lines of a farm
located in Sections 3 and 10 of T4N R17E.

April 20, 1943

Lloyd L. Jensen
County Surveyor

#1403

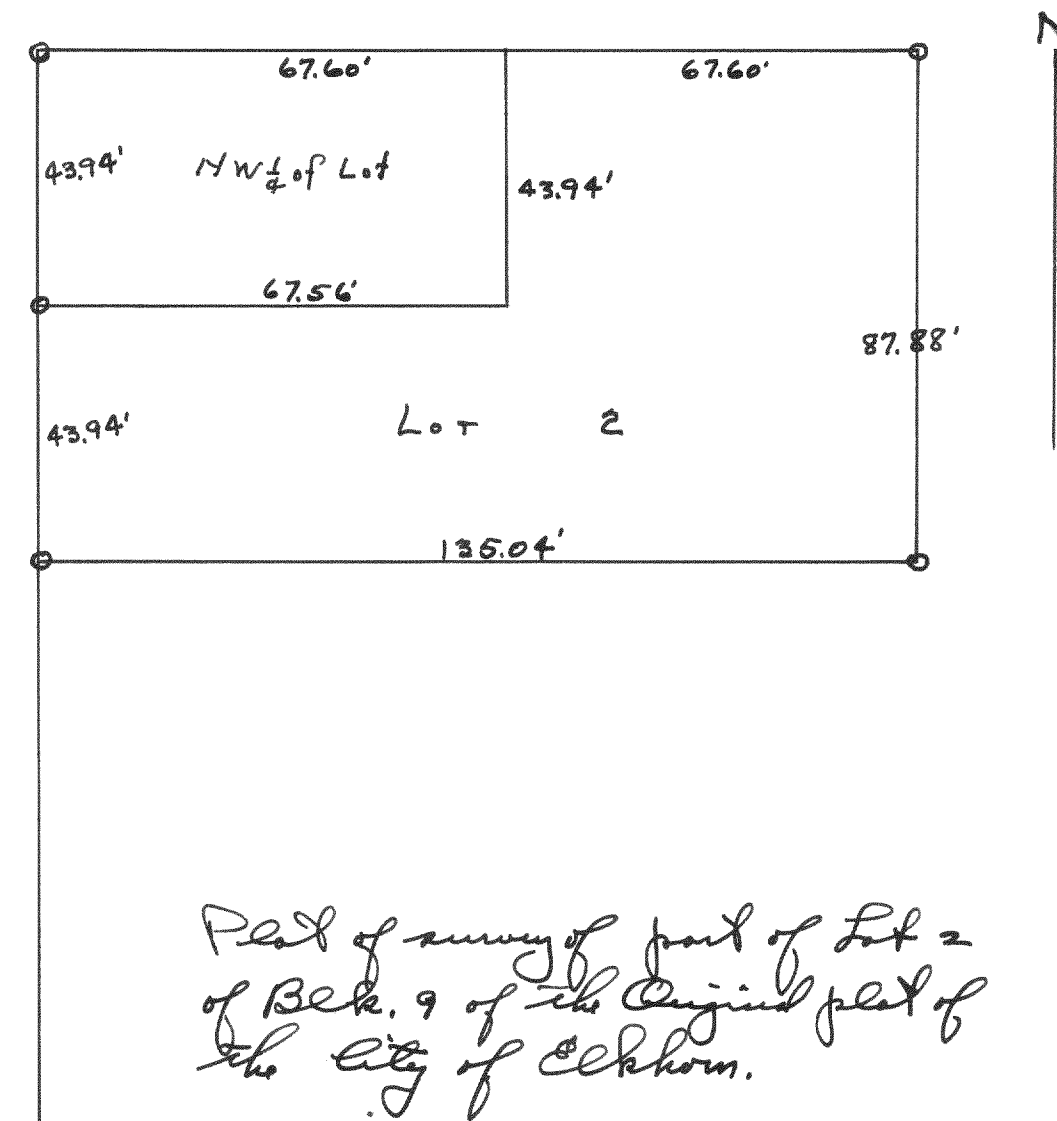

Plot of survey of part of Lot 2
of Block 9 of the Original plat of
the City of Elkhorn.

May 1943

Lloyd L. Jensen
County Surveyor