


#1407

2


Lot C - Private drive for
property owners, 50 feet wide

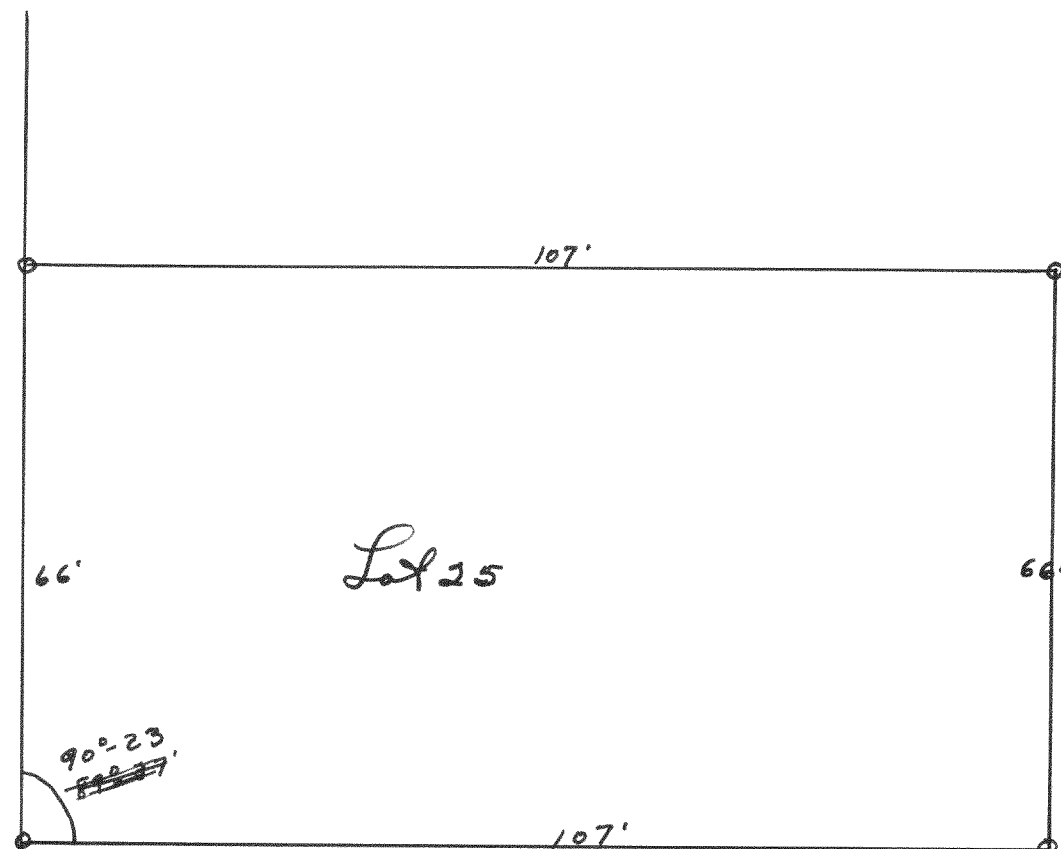

Plot of survey of Lot 25 of
Robinson's Subd. located in
Sections 11 and 14, T17N R17E
April 1943 Lloyd S. Jensen
County Surveyor

#1408

PUBLIC ROAD

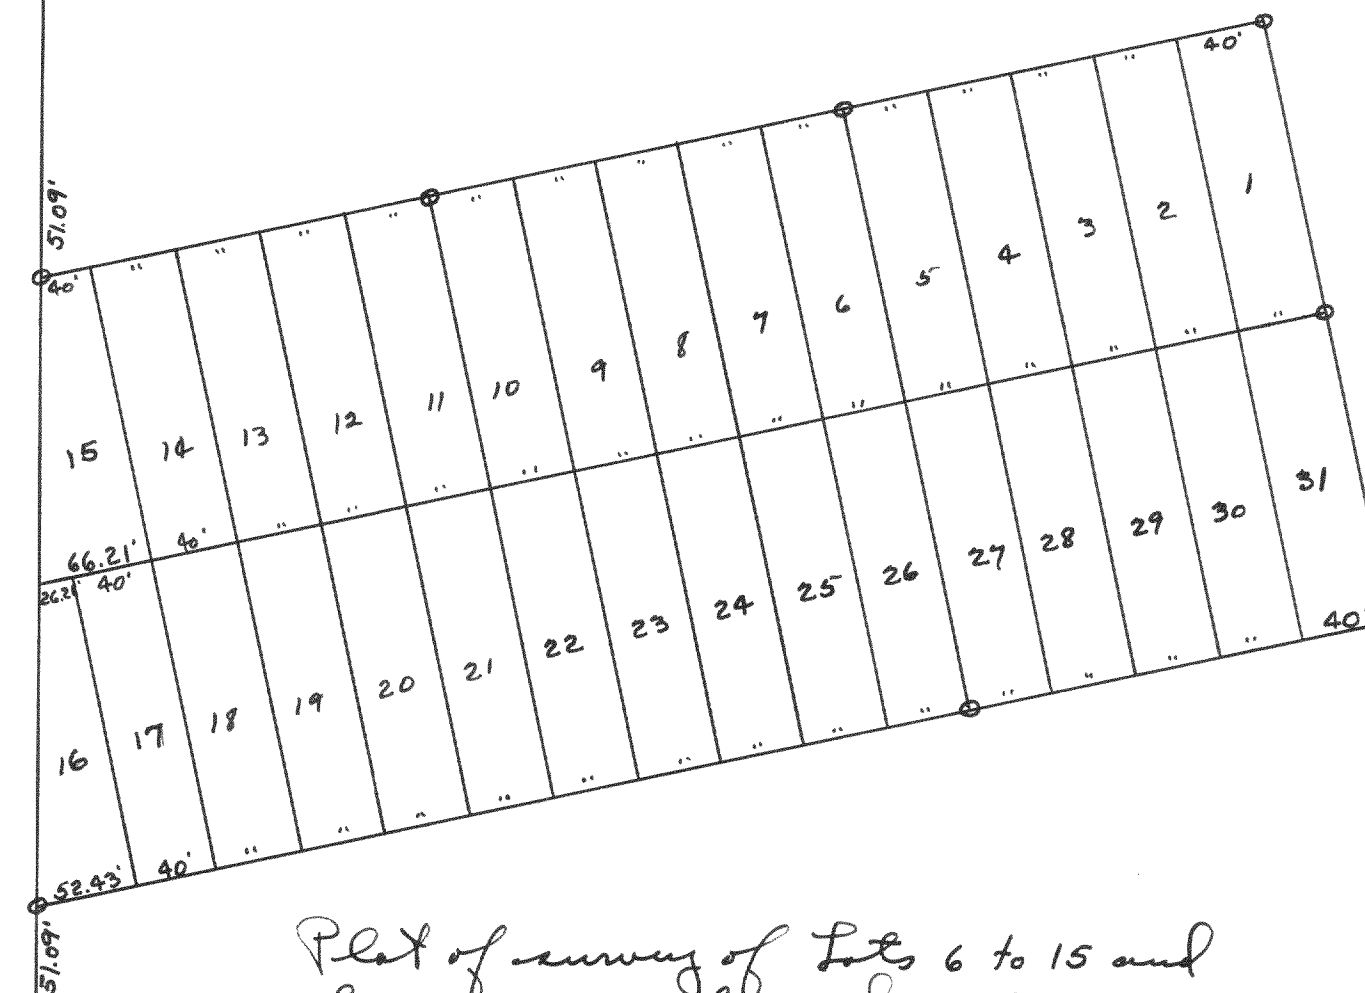

Plot of survey of Lots 6 to 15 and
Lots 16 to 26 of Block 9 of Delavan
Lakeview Crest Subd.

April 1943

Lloyd S. Jensen
County Surveyor