


#1409

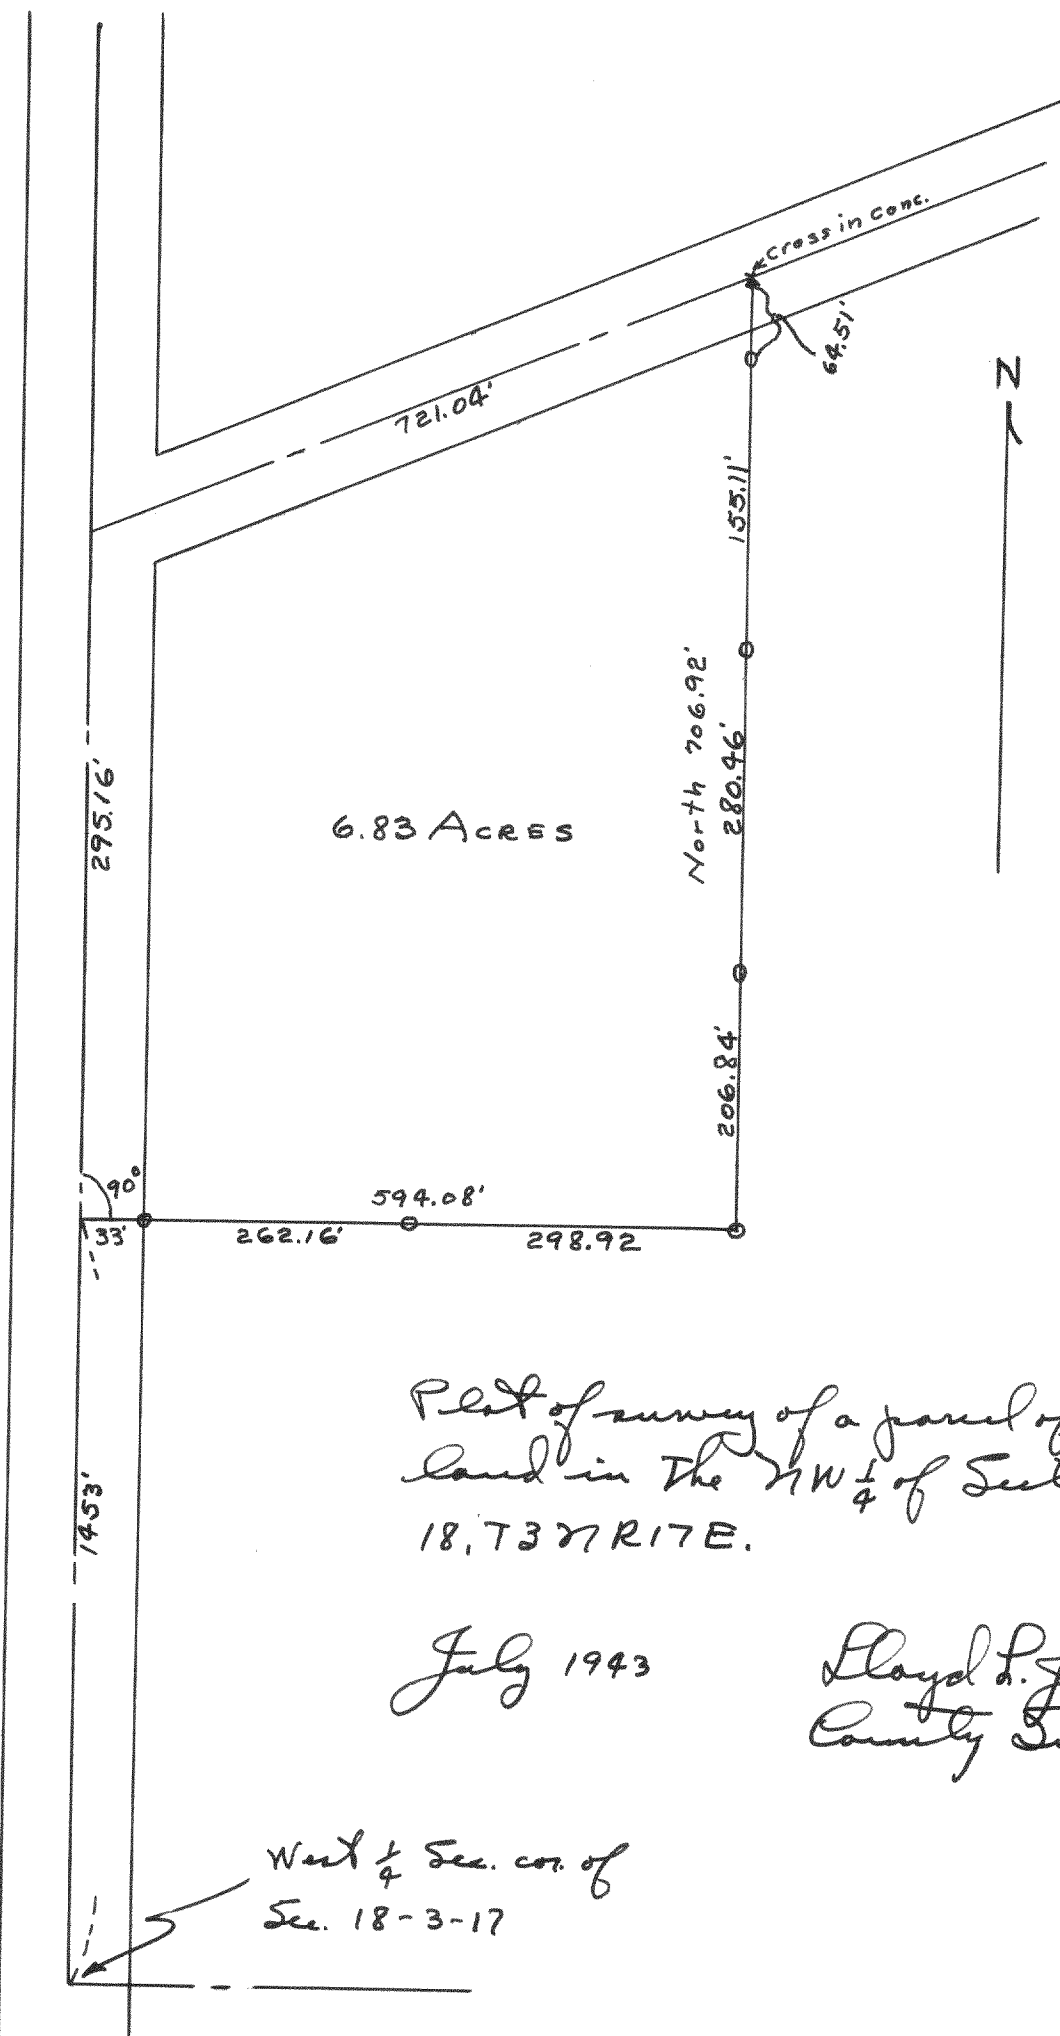


Plot of survey of a parcel of land in the NW 1/4 of Section 18, T37N R17E.

July 1943

Lloyd L. Jensen
County Surveyor

West 1/4 Sec. cor. of
Sec. 18-3-17

#1410

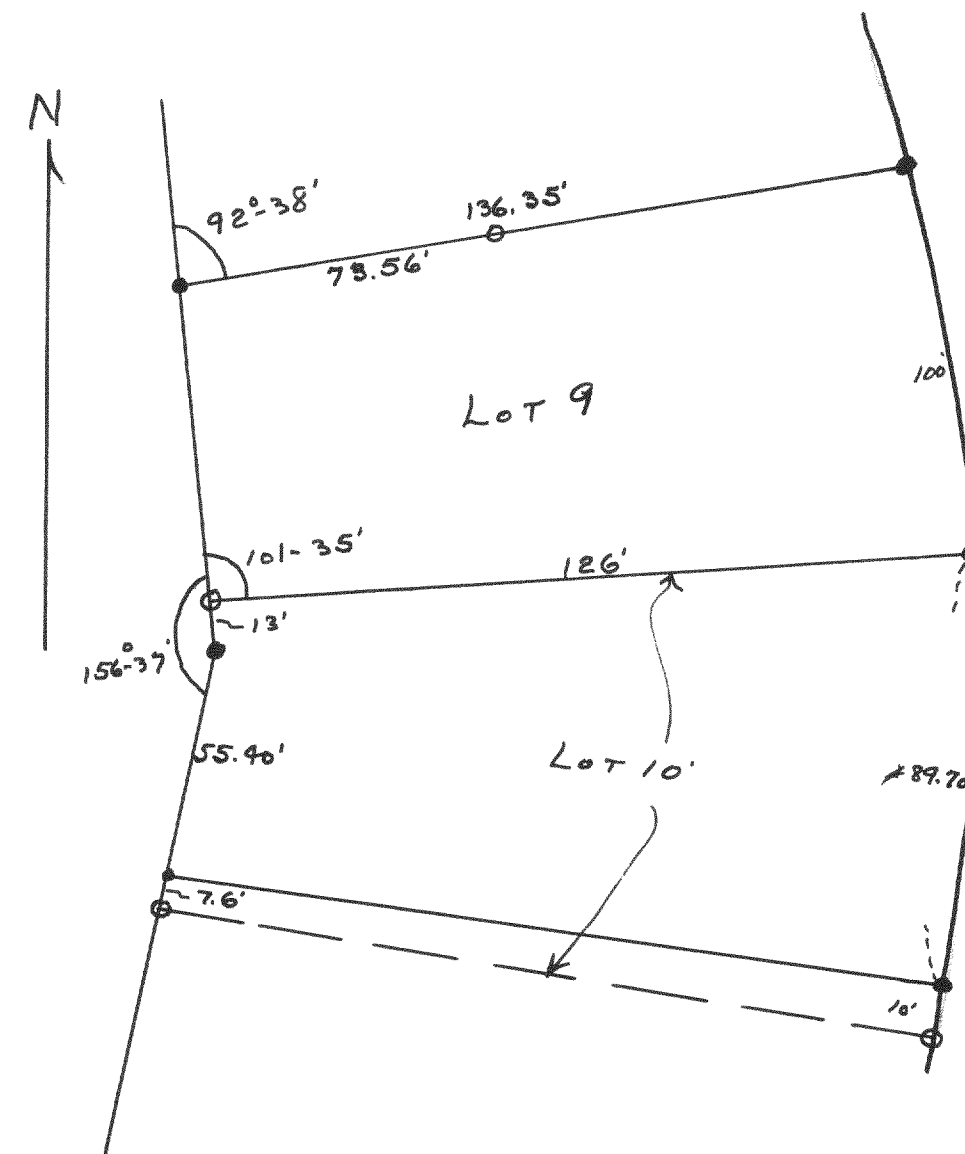

Plot of survey of Lot 9 and nearly all of Lot 10 of Block D of Unit 3 of the Country Club Estates, Fontana, Cal.

April 30, 1943

Lloyd L. Jensen
County Surveyor